
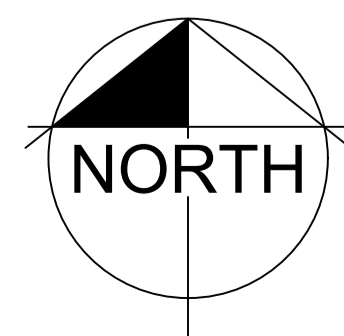


- LEGEND**
- Water Service
 - Water Reticulation
 - Valve
 - Water Meter
 - Fire Hydrant
 - Fitting
 - Bend
 - Tapping Band
 - End Cap
 - Tee

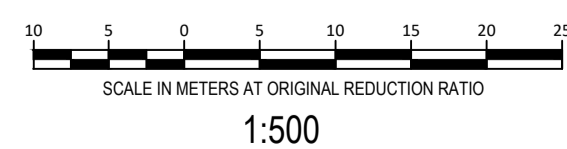

PROJECT Providence, Ripley	
LEVEL DATUM	SCALE 1:500 @ A1
ORIGIN	Date: MAY 2018 Surveyed: RPS Comp by: RPS
FB :	LB : DWG. 116052 s42 Waterr

CLIENT AMEX CORP. PTY LTD	
AS CONSTRUCTED WATER RETICULATION STAGE 42 BUILT TO DATE	
Parish	Job Ref 116052-44
Local Authority IPSWICH CITY COUNCIL	Rev

RPS Australia East Pty Ltd
ACN 140 292 762
ABN 44 140 292 762
180 Brisbane Street
PO Box 341
Ipswich QLD 4305
T +61 7 3437 2000
F +61 7 3434 2099
W rpsgroup.com.au

© COPYRIGHT PROTECTS THIS PLAN. Unauthorised reproduction or amendment not permitted. Please contact the author.

Reference **116052-238**