


STAGE 15C (PL)


STAGE 15B

FINAL ISSUE

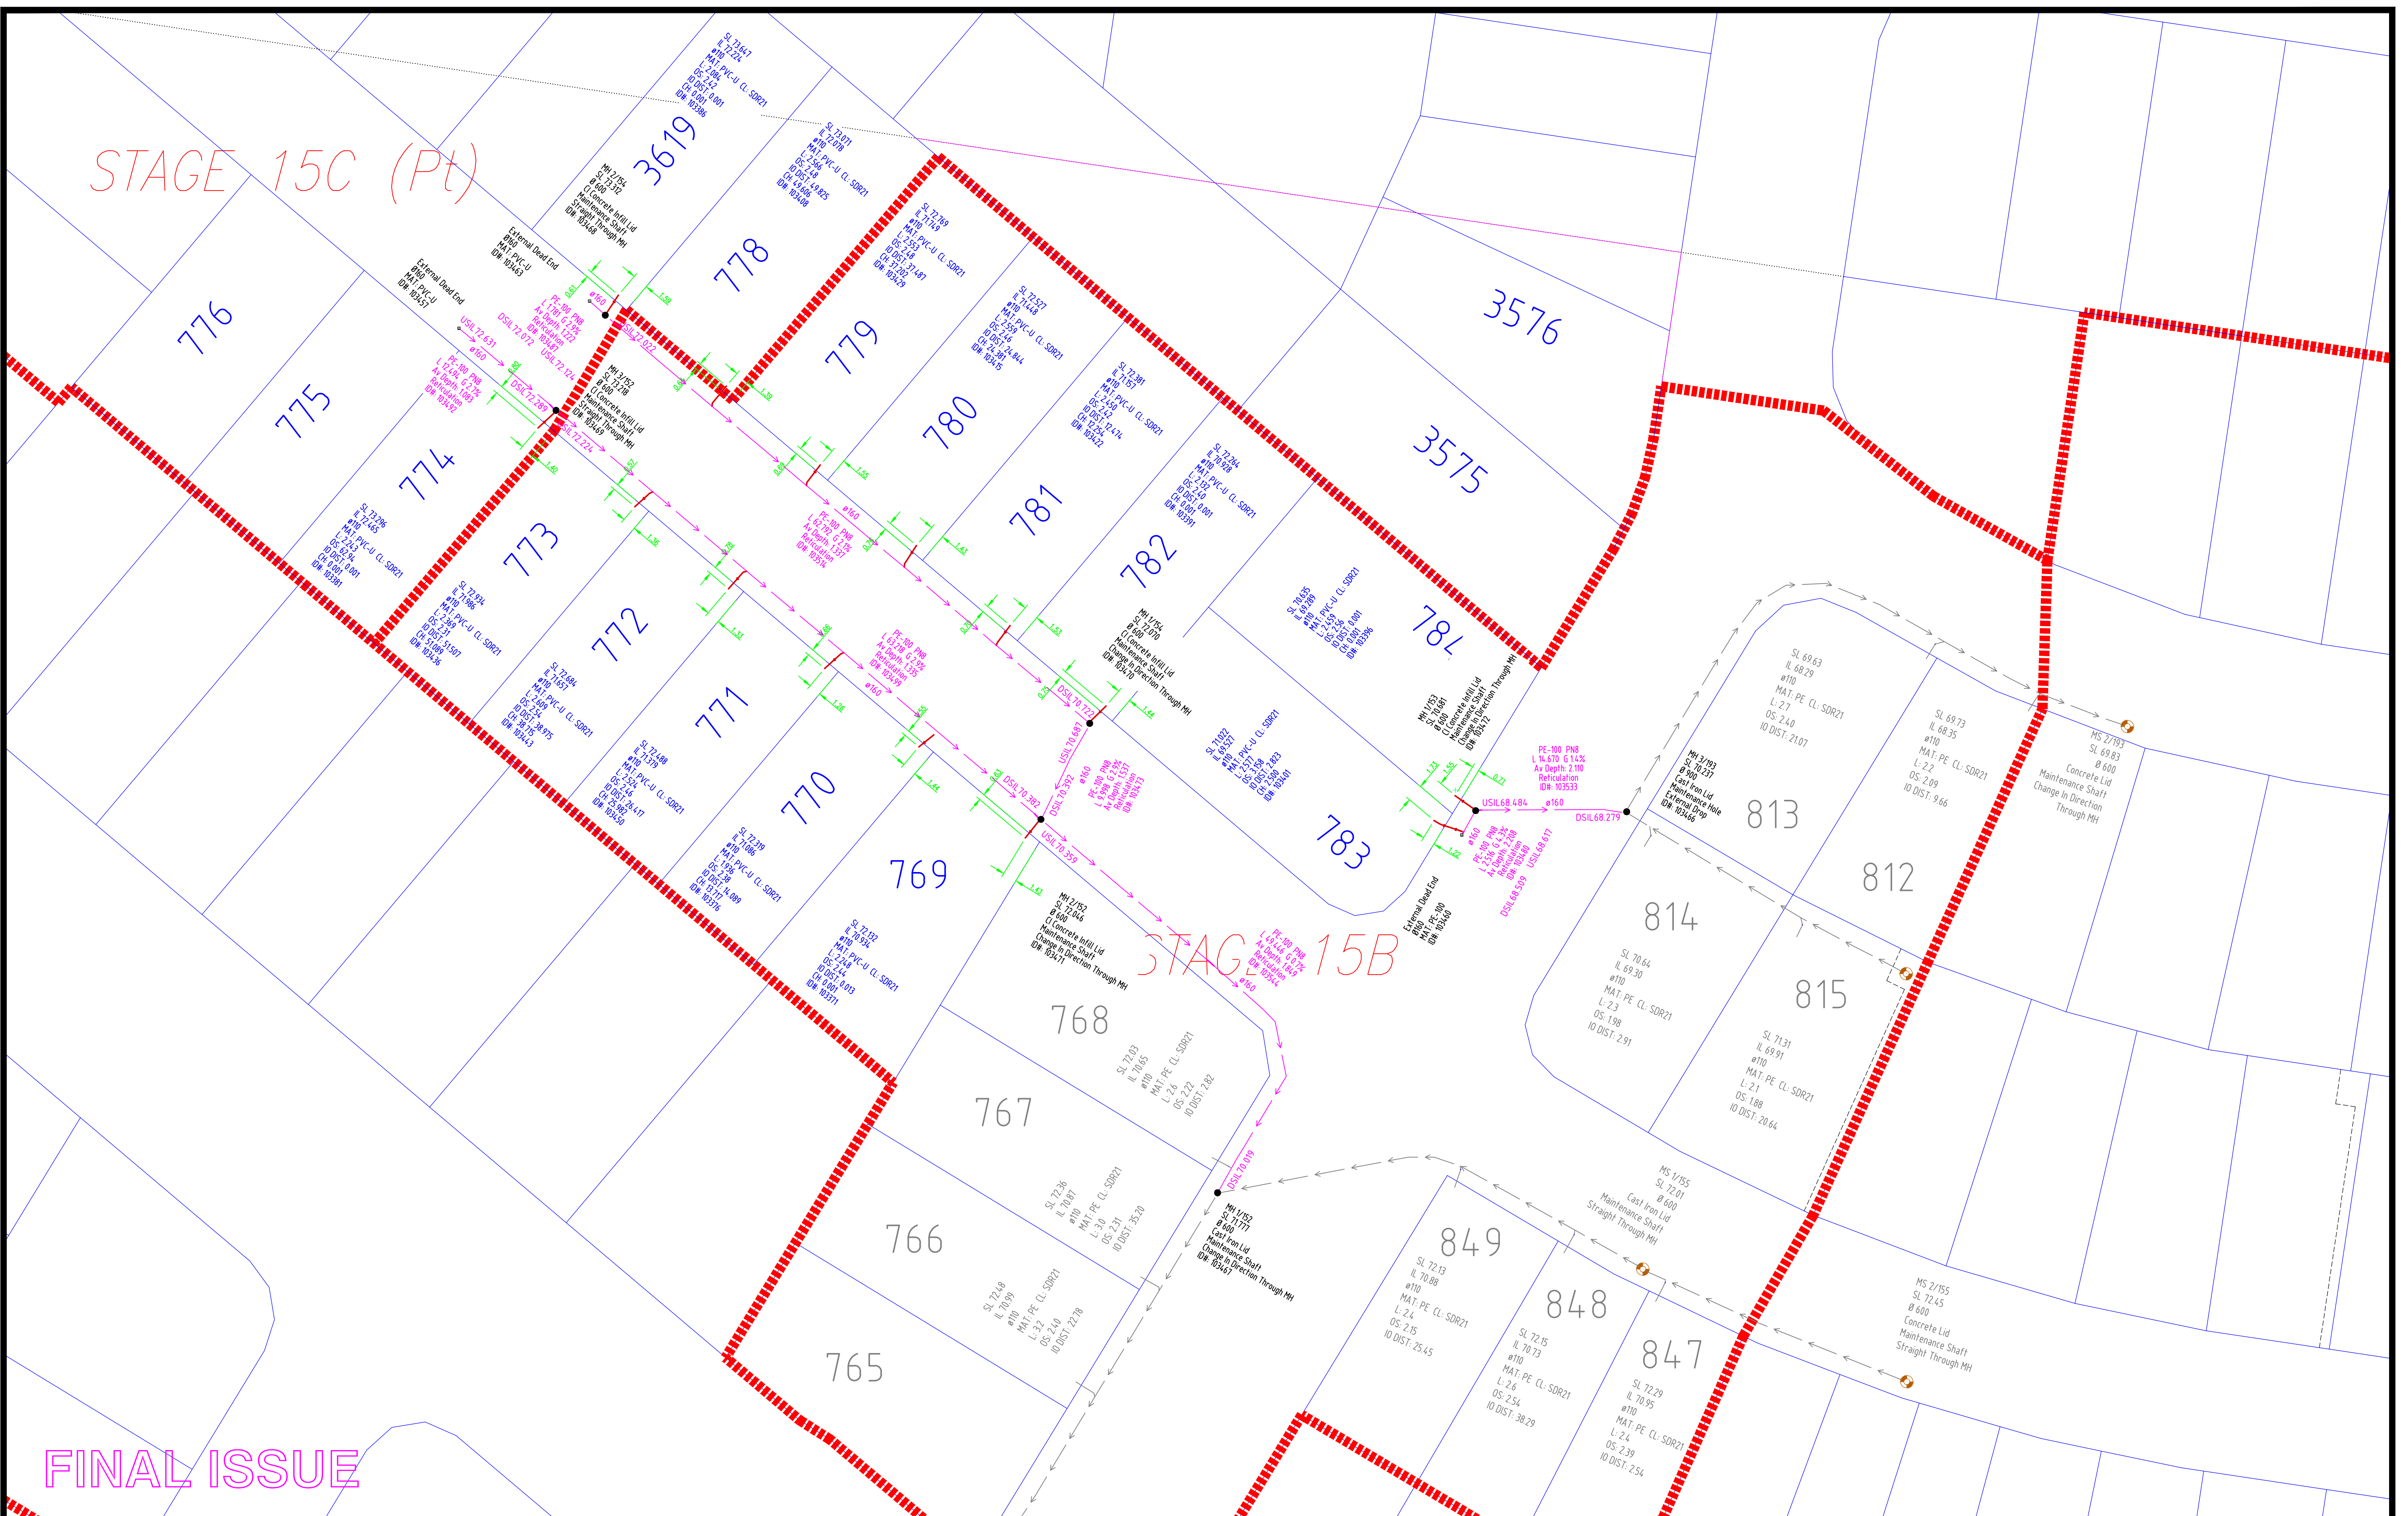

| LEGEND | | ABBREVIATIONS - Sewer Main | |
|--------|--|----------------------------|---------------------------------------|
| | Sewer Line | Mat | Material |
| | Lot Boundary | DSIL | Down stream invert level |
| | Stage Boundary | USIL | Up stream invert level |
| | Manhole / Maintenance Structure | SL | Surface level |
| | Existing Manhole / Maintenance Structure | L | Length of pipe from Manhole to Mahole |
| | Existing Sewer Line | | |

| SCALE IN METERS AT ORIGINAL REDUCTION RATIO | | 1:300 | |
|---|---|-----------|----------|
| Amendment | Description | Date | Surveyor |
| ORIG | Final survey pickup for review and lodgement to QOU | 23/8/2018 | RPS |
| | | | Drafted |
| | | | RPS |

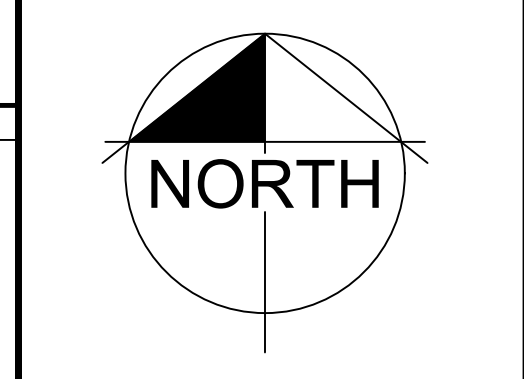

| | |
|---|--|
| PROJECT PROVIDENCE SOUTH RIPLEY | |
| LEVEL DATUM AHD | SCALE 1:300 @ A1 |
| ORIGIN PM60601 PROVIDENCE PDE RL44.315 | Date: AUGUST 2018 Surveyed: RPS Comp by: RPS |
| FB : | LB : |
| DWG. | 116052 s15B Sewer |

| | |
|---|-----------|
| CLIENT AMEX CORPORATION PTY LTD | |
| AS CONSTRUCTED PLOT SEWER RETICULATION STAGE 15B | |
| Parish | Job Ref |
| Local Authority IPSWICH CITY COUNCIL | 116052-58 |

RPS Australia East Pty Ltd
ACN 140 292 762
ABN 44 140 292 762
180 Brisbane Street
PO Box 341
Ipswich QLD 4305
T +61 7 3437 2000
F +61 7 3434 2099
W rpsgroup.com.au

| | |
|--------------------------------|-----|
| Reference 116052-245 | Rev |
|--------------------------------|-----|