


LEGEND

- Water Service
- Water Reticulation
- Valve
- Water Meter
- Fire Hydrant
- Fitting
- Bend
- Tapping Band
- End Cap
- Tee

SCALE IN METERS AT ORIGINAL REDUCTION RATIO 1:300

Amendment	Description	Date	Surveyor	Drafted
ORIG	Final survey pickup for review and lodgement to OOU	23/8/2018	RPS	RPS

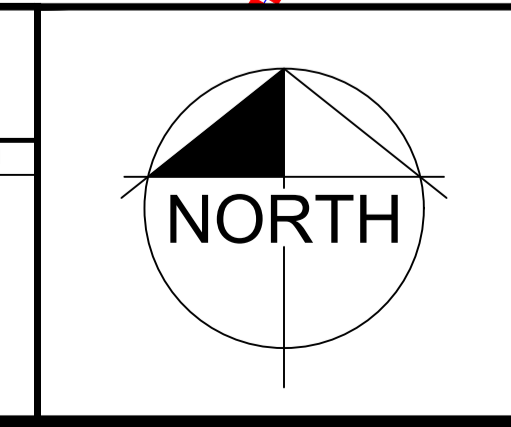

PROJECT PROVIDENCE SOUTH RIPLEY	
LEVEL DATUM AHD	SCALE 1:300 @ A1
ORIGIN PM60601 PROVIDENCE PDE RL44.315	Date: AUGUST 2018 Surveyed: RPS Comp by: RPS
FB :	LB : DWG: 116052 s15B Water

CLIENT AMEX CORPORATION PTY LTD	
AS CONSTRUCTED PLOT SEWER RETICULATION STAGE 15B	
Parish	Job Ref 116052-58
Local Authority IPSWICH CITY COUNCIL	

RPS

RPS Australia East Pty Ltd
ACN 140 292 762
ABN 44 140 292 762
180 Brisbane Street
PO Box 341
Ipswich QLD 4305
T +61 7 3437 2000
F +61 7 3434 2099
W rpsgroup.com.au

© COPYRIGHT PROTECTS THIS PLAN
Unauthorised reproduction or amendment
not permitted. Please contact the author.

Reference 116052-247	Rev
--------------------------------	-----