


AS CONSTRUCTED

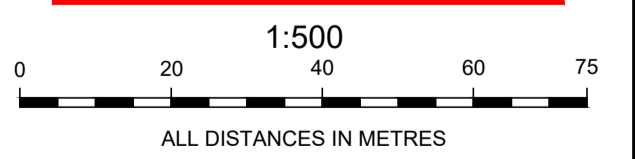


ENGINEER'S CERTIFICATION
 I, Willie Maherbe, hereby certify that:
 1. The information contained in this drawing / document is in compliance with approved drawings and design.
 2. The new water and sewerage works defined by this drawing have been designed and constructed in accordance with the SEQ Code.
 3. This represents an accurate record of as-constructed works.
 4. I accept responsibility for the information contained in this drawing / document.
 RPEQ (signature) RPEQ No. 8112 Date:

REGISTERED SURVEYOR'S CERTIFICATION
 We RPS Australia East Pty Ltd, Registered Surveyor - Land hereby certify that the Levels and Dimensions shown hereon are a correct record of our Survey which was performed in accordance with Council Accuracy Standards.
 Authorised Delegate Date:

A1	E	17/07/2019	10/RWF1 - 10/RWF1 invert levels checked and amended	DJL	RPS	D.L.
	D	27/06/2019	Stormwater for final review	JG	RPS	D.L.
	C	12/06/2019	Stormwater for final review	JG	RPS	D.L.
	B	10/05/2019	Preliminary Stormwater	JG	RPS	D.L.
	A	26/03/2019	Preliminary Stormwater for Laneway check	JG	RPS	D.L.
INDEX	DATE	REVISIONS	DRAWN	CHECKED	PASSED	

DRAWN	JG	10/05/2019
CHECKED	RPS	10/05/2019
PASSED		
INITIALS		DATE

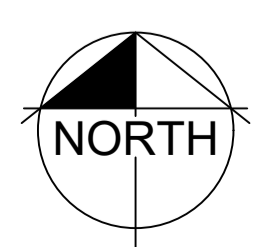

Ipswich City Council
 PROVIDENCE RIPLEY
 STORMWATER RETICULATION
 STAGE 41
 SCALE 1:500
 SHEET 1 OF 1
 DRAWING NO. 116052

RPS Australia Asia Pacific
 180 Brisbane Street
 Ipswich QLD 4305
 (07) 3437 2000
 www.rpsgroup.com.au

