


STAGE 34

STAGE 41C

STAGE 40

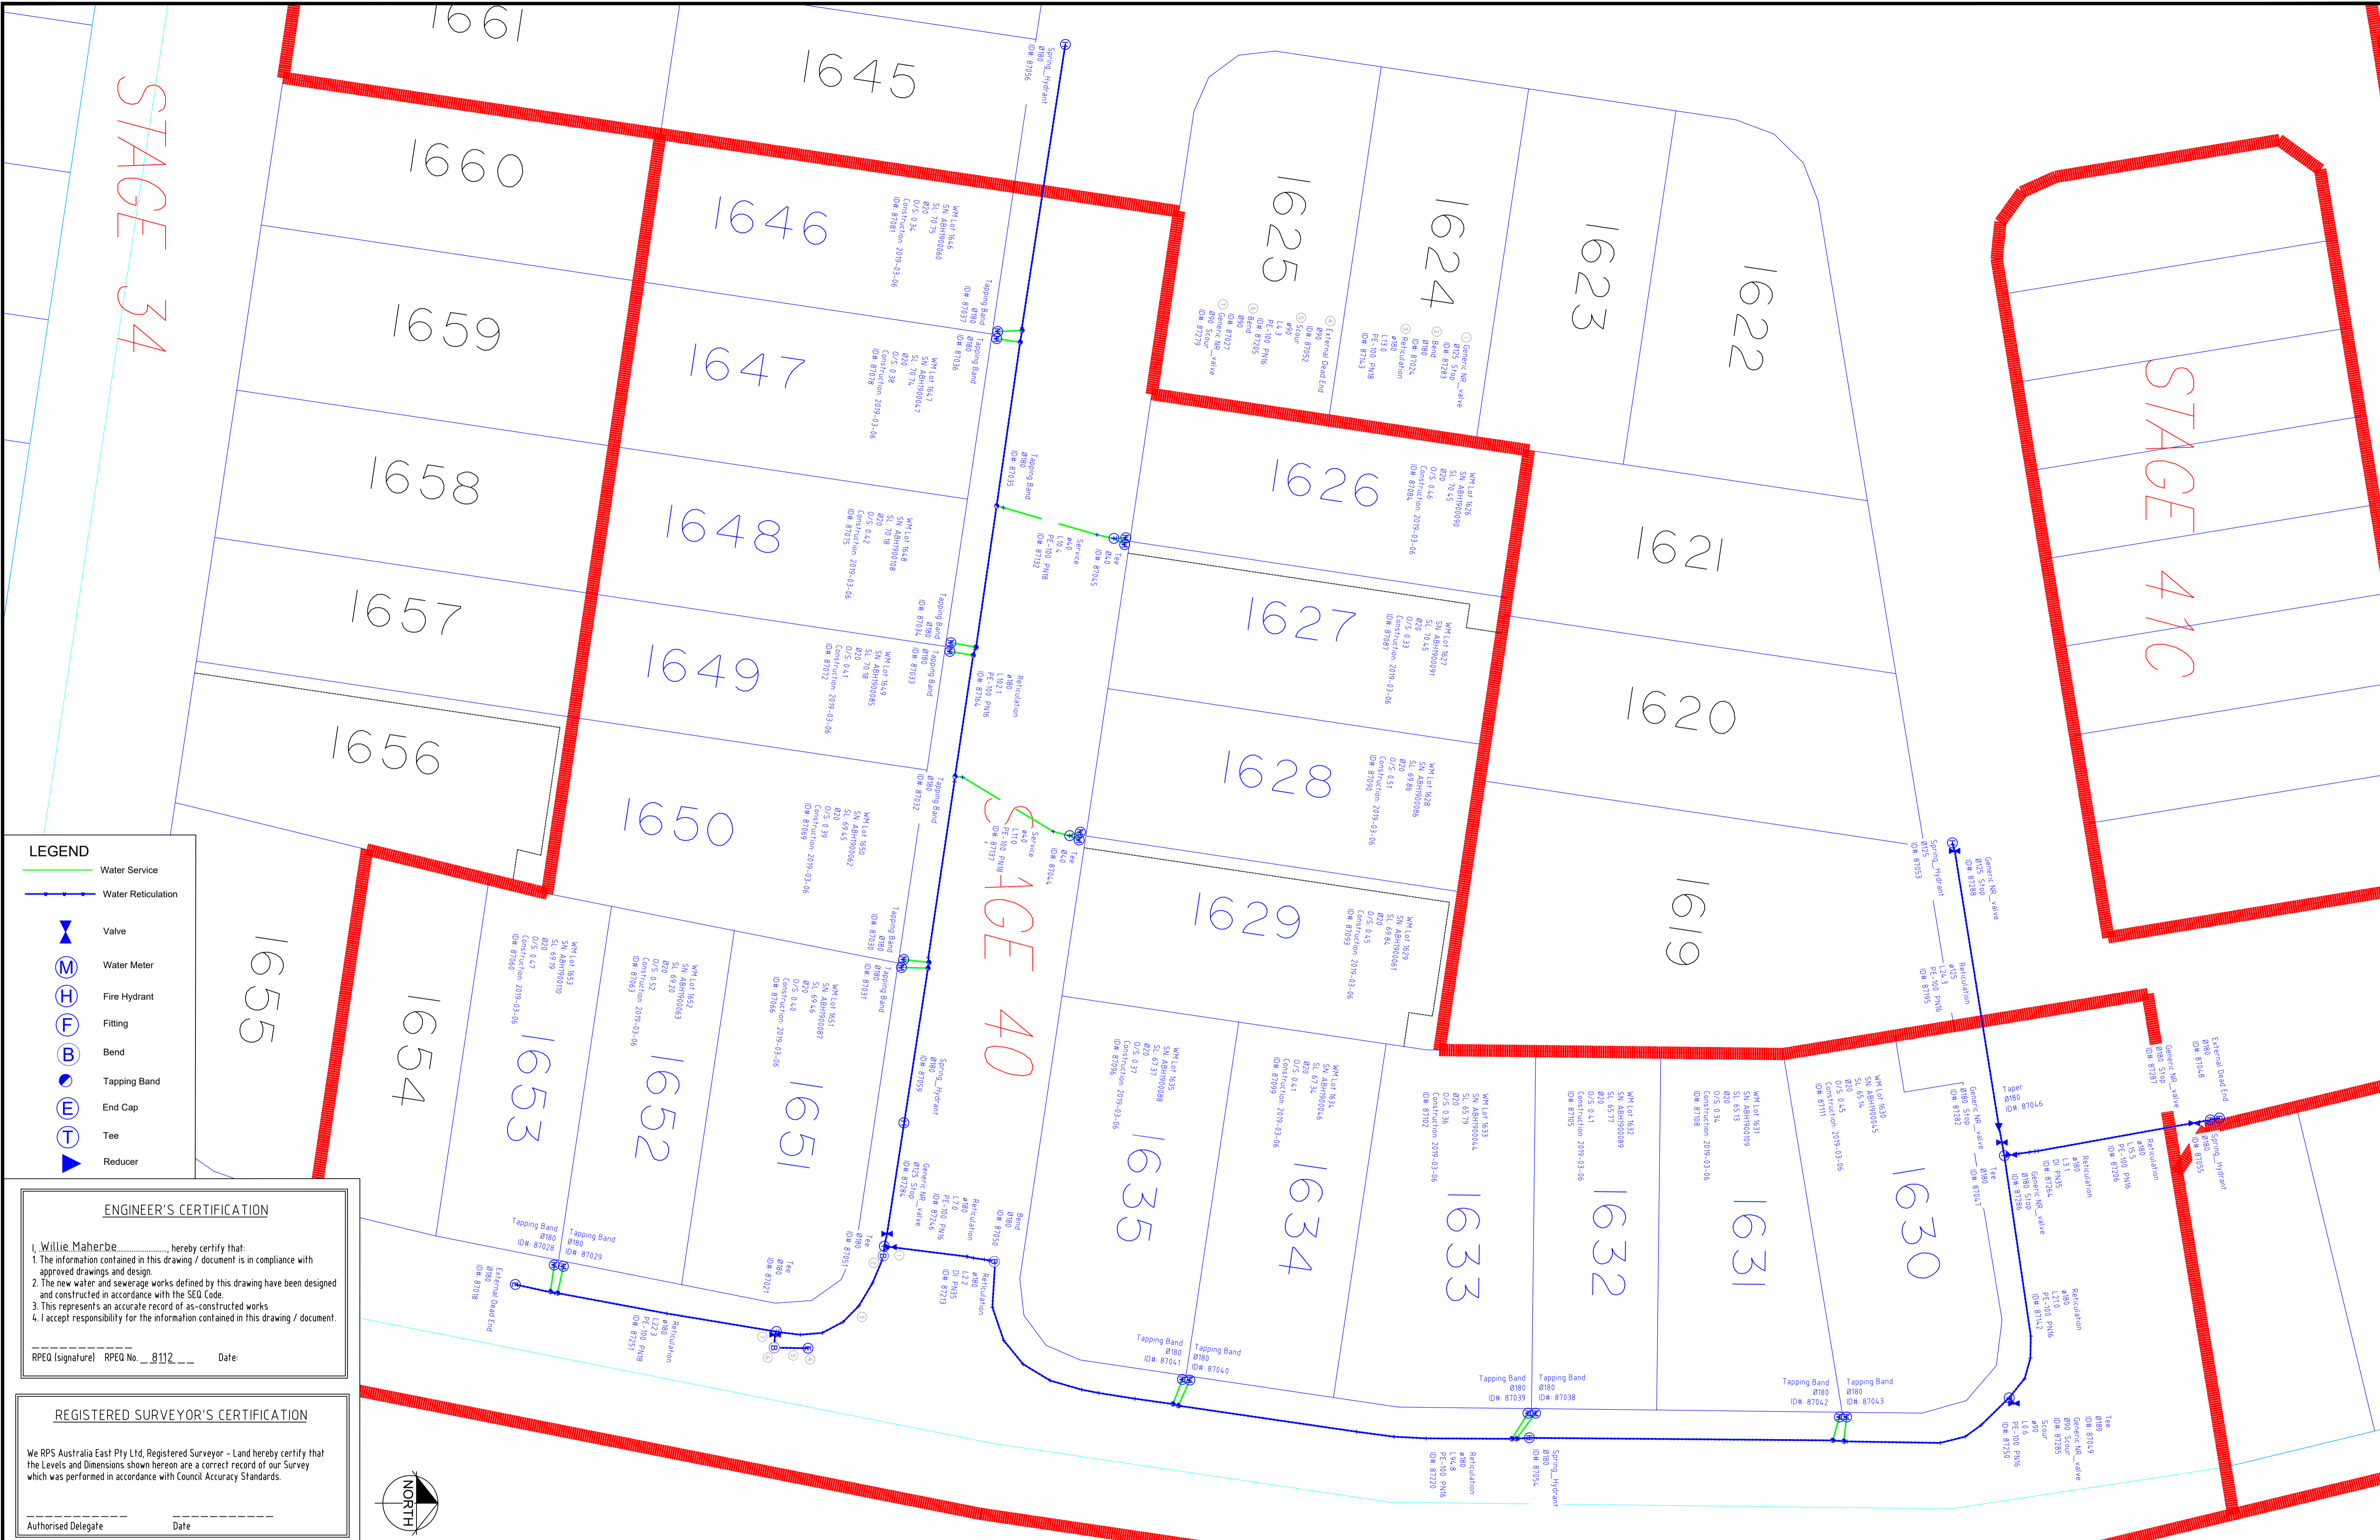

LEGEND

- Water Service
- Water Reticulation
- Valve
- Water Meter
- Fire Hydrant
- Fitting
- Bend
- Tapping Band
- End Cap
- Tee
- Reducer

ENGINEER'S CERTIFICATION


I, Willie Maherbe, hereby certify that:
 1. The information contained in this drawing / document is in compliance with approved drawings and design.
 2. The new water and sewerage works defined by this drawing have been designed and constructed in accordance with the SEQ Code.
 3. This represents an accurate record of as-constructed works
 4. I accept responsibility for the information contained in this drawing / document.

RPEQ (signature) RPEQ No. 8112 Date:

REGISTERED SURVEYOR'S CERTIFICATION

We RPS Australia East Pty Ltd, Registered Surveyor - Land hereby certify that the Levels and Dimensions shown hereon are a correct record of our Survey which was performed in accordance with Council Accuracy Standards.

Authorised Delegate Date:

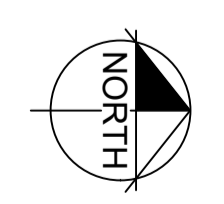

A1	B	12/04/2019	Final water	JG	RPS	RPS
	A	25/03/2019	Preliminary water for review	JG	RPS	RPS
	INDEX	DATE	REVISIONS	DRAWN	CHECKED	PASSED

DRAWN	JG	12/04/2019
CHECKED	RPS	12/04/2019
PASSED	RPS	12/04/2019
INITIALS		DATE

RPS Australia Asia Pacific
 180 Brisbane Street PO Box 341 Ipswich QLD 4305
 (07) 3437 2000
 www.rpsgroup.com.au

Queensland Urban Utilities

PROVIDENCE RIPLEY
 WATER RETICULATION
 STAGE 40

SCALE	1:250
SHEET	1 OF 1
DRAWING NO.	116052