



**LEGEND**

- Water Service
- Water Reticulation
- Valve
- Water Meter
- Fire Hydrant
- Fitting
- Bend
- Tapping Band
- End Cap
- Tee

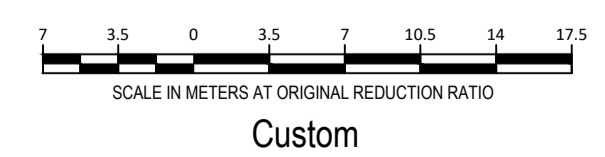

Issue	Description	Date
A	Preliminary water built to date	27/06/2018
B	Preliminary water built to date	10/08/2018
C	Preliminary water built to date	24/10/2018

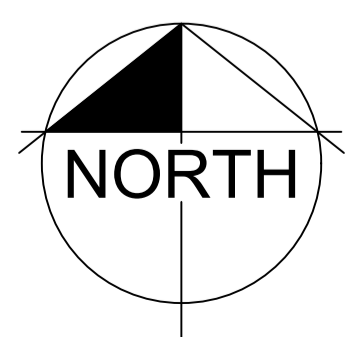

PROJECT <b>Providence, Ripley</b>	
LEVEL DATUM AHD	SCALE <b>1:350 @ A1</b>
ORIGIN	Date: AUGUST 2018
	Surveyed: RPS
	Comp by: RPS
FB :	LB :
DWC:	116052e36&37 Water

CLIENT <b>AMEX CORP. PTY LTD</b>	
<b>AS CONSTRUCTED WATER RETICULATION STAGE 36 &amp; 37</b>	
Parish	Job Ref
Local Authority: IPSWICH CITY COUNCIL	116052



©COPYRIGHT PROTECTS THIS PLAN  
Unauthorized reproduction or amendment  
not permitted. Please contact the author.

RPS Australia East Pty Ltd  
ACN 140 292 762  
ABN 44 140 292 762  
180 Brisbane Street  
PO Box 341  
Ipswich QLD 4305  
T +61 7 3437 2000  
F +61 7 3434 2099  
W rpsgroup.com.au

Reference	Rev
<b>116052</b>	