


LEGEND


- Sewer Line
- Lot Boundary
- Stage Boundary
- Manhole / Maintenance Structure

ABBREVIATIONS - Sewer Main

- | | |
|------|---------------------------------------|
| Mat | Material |
| DSIL | Down stream invert level |
| USIL | Up stream invert level |
| SL | Surface level |
| L | Length of pipe from Manhole to Mahole |

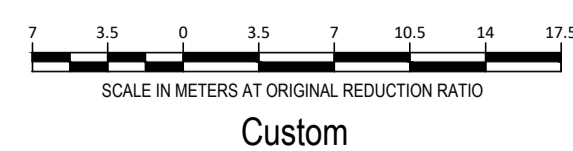

BUILDERS ISSUE

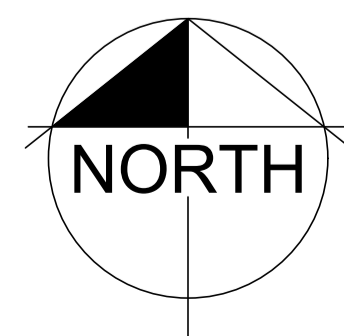


PROJECT Providence, Ripley	
LEVEL DATUM AHD	SCALE 1:350 @ A1
ORIGIN OPM60301 RL 44.315 Barrams RD Sth Ripley	Date: OCTOBER 2017 Surveyed: RPS Comp by: RPS
FB : FLD	LB : DWG. 116052 s32 Sewer BUILDERS ISSUE

CLIENT AMEX CORP. PTY LTD	
AS CONSTRUCTED SEWER RETICULATION MAIN STAGE 32	
Parish	Job Ref 116052-34
Authority IPSWICH CITY COUNCIL	Rev

RPS Australia East Pty Ltd
ACN 140 292 762
ABN 44 140 292 762
180 Brisbane Street
PO Box 341
Ipswich QLD 4305
T +61 7 3437 2000
F +61 7 3434 2099
W rpsgroup.com.au

©COPYRIGHT PROTECTS THIS PLAN
Unauthorized reproduction or amendment
not permitted. Please contact the author.


Reference **116052-217**

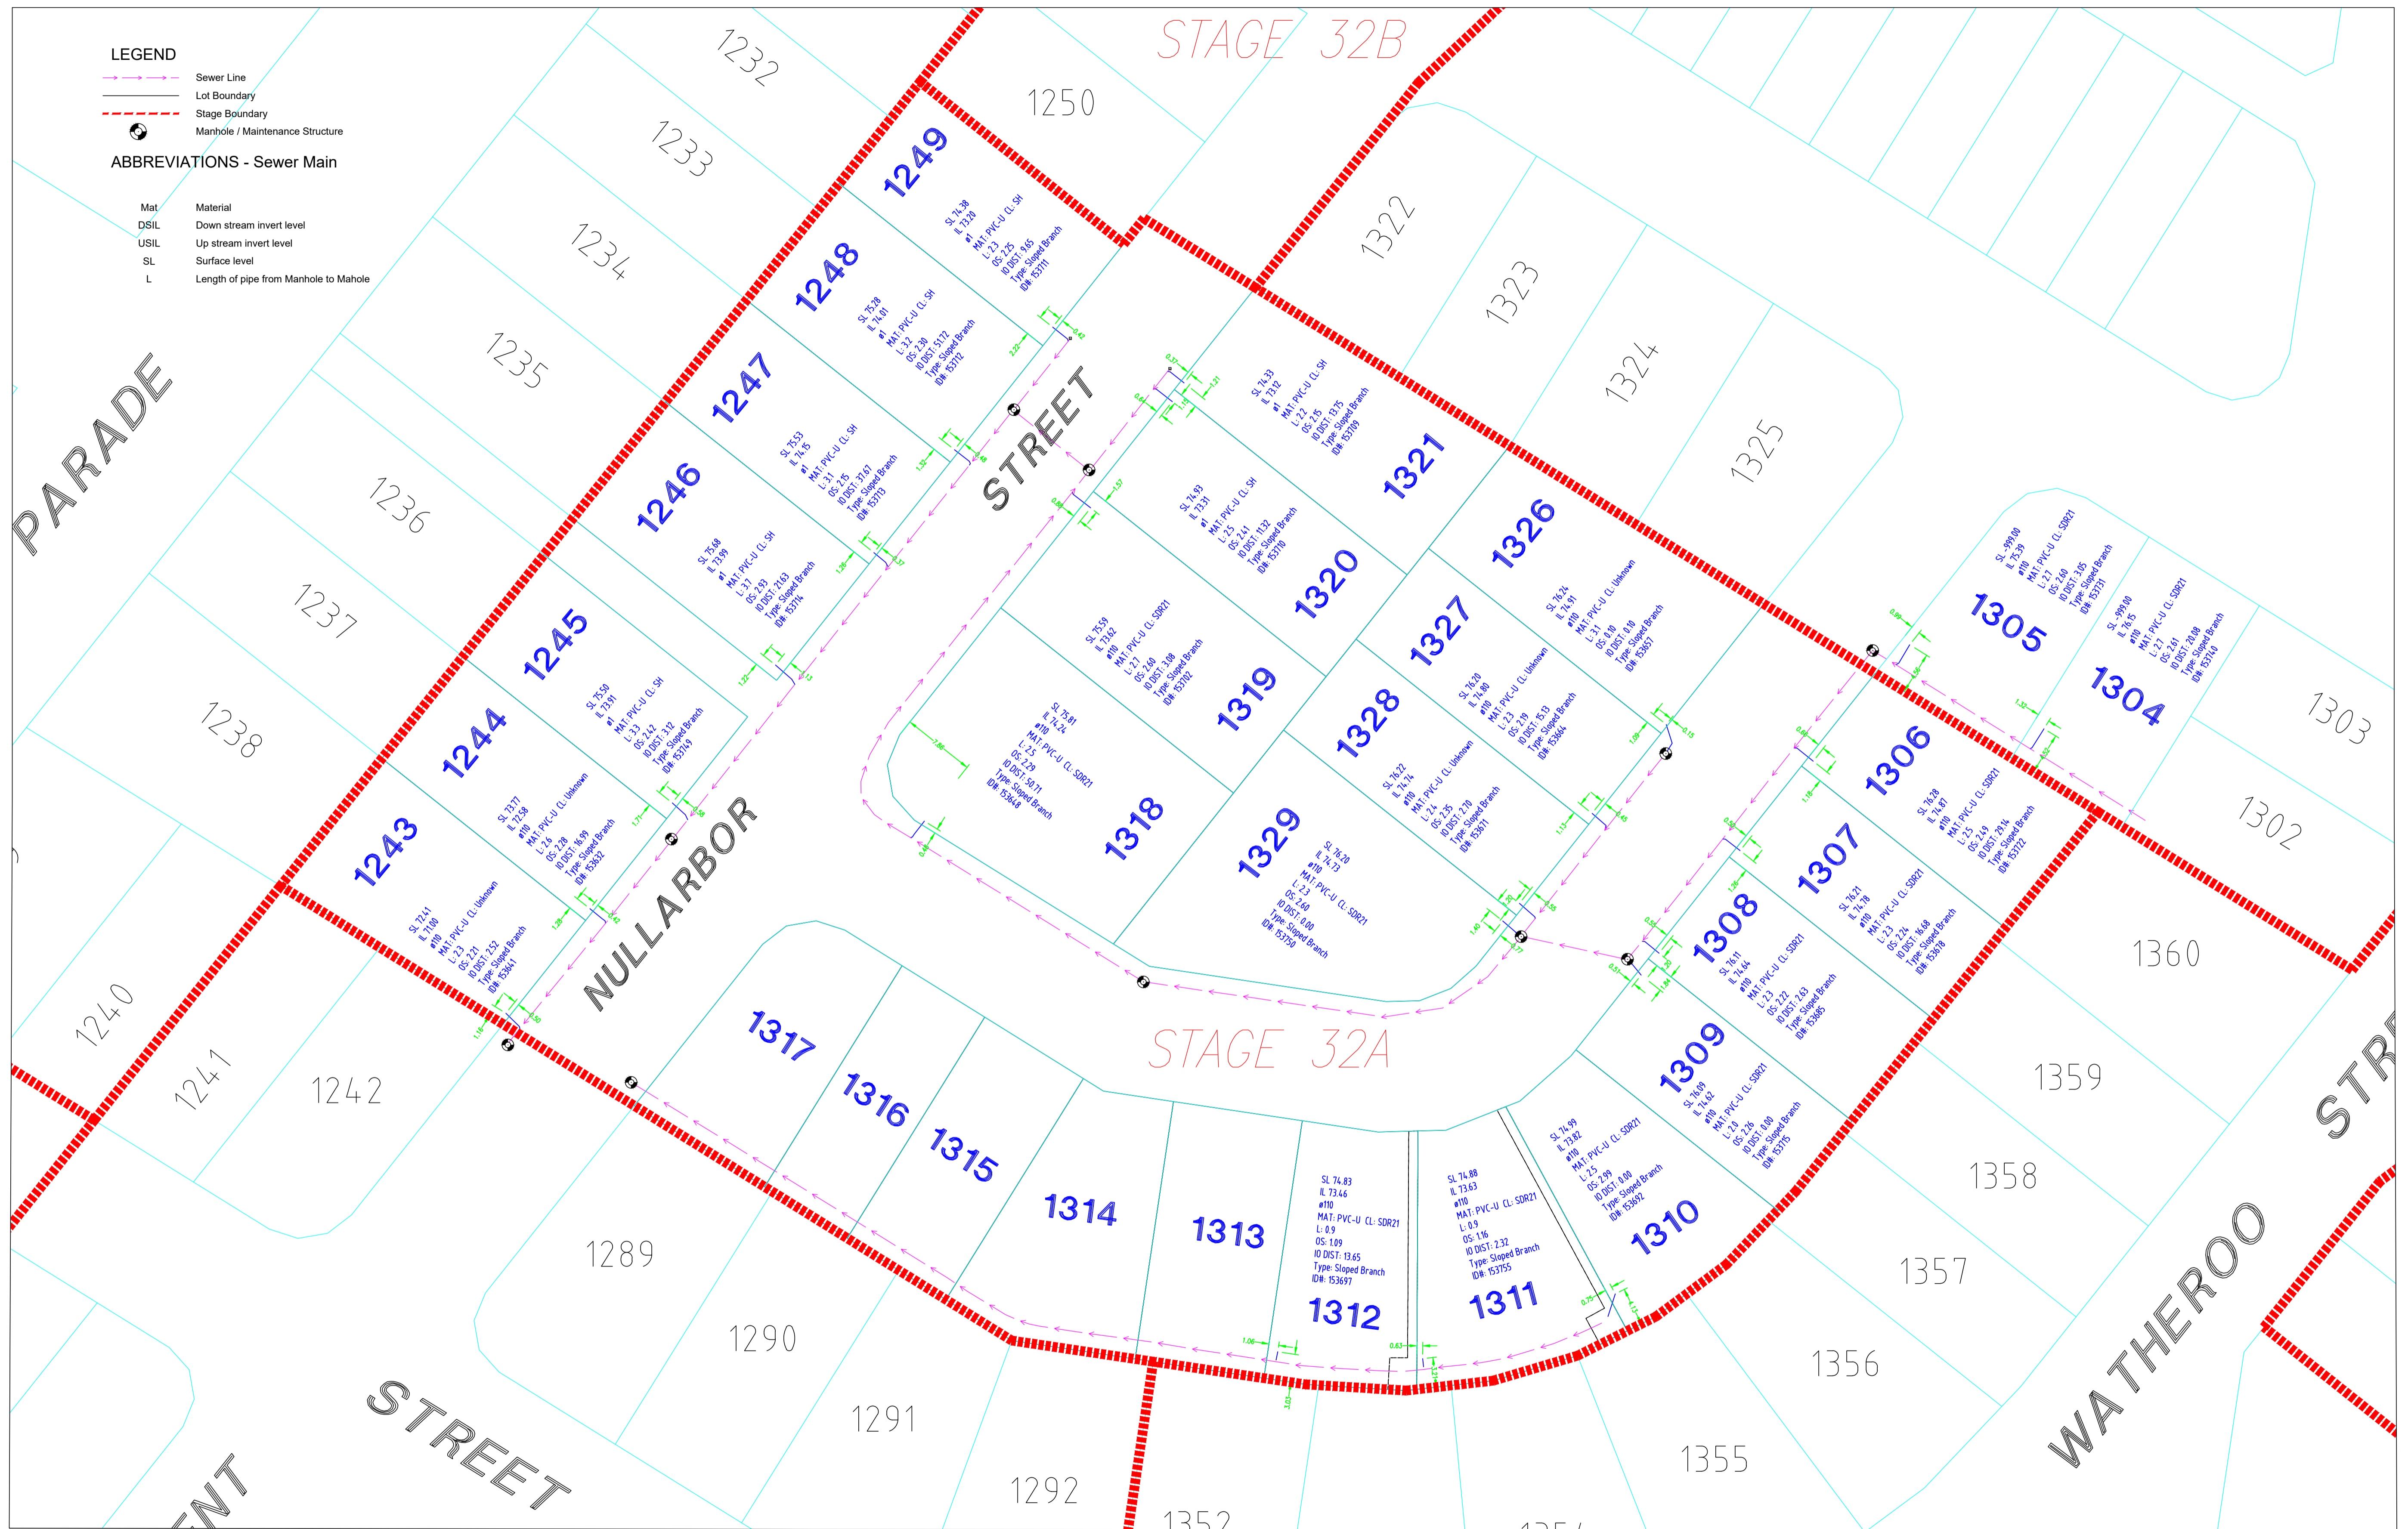

- LEGEND**
- Sewer Line
 - Lot Boundary
 - Stage Boundary
 - Manhole / Maintenance Structure
- ABBREVIATIONS - Sewer Main**
- Mat Material
 - DSIL Down stream invert level
 - USIL Up stream invert level
 - SL Surface level
 - L Length of pipe from Manhole to Mahole



BUILDERS ISSUE

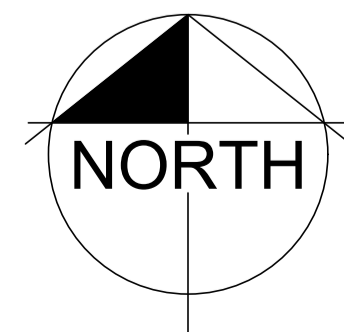

PROJECT Providence, Ripley	
LEVEL DATUM AHD	SCALE 1:350 @ A1
ORIGIN OPM60301 RL 44.315 Barrams RD Sth Ripley	Date: OCTOBER 2017 Surveyed: RPS Comp by: RPS
FB : FLD	LB : DWG. 116052-32 Sewer BUILDERS ISSUE

CLIENT AMEX CORP. PTY LTD	
AS CONSTRUCTED SEWER HOUSE CONNECTIONS STAGE 32	
Parish	Job Ref 116052-34
Authority IPSWICH CITY COUNCIL	

RPS

RPS Australia East Pty Ltd
ACN 140 292 762
ABN 44 140 292 762
160 Brisbane Street
PO Box 341
Ipswich QLD 4305
T +61 7 3437 2000
F +61 7 3434 2099
W rpsgroup.com.au

© COPYRIGHT PROTECTS THIS PLAN
Unauthorized reproduction or amendment
not permitted. Please contact the author.

Reference 116052-216	Rev
--------------------------------	-----