
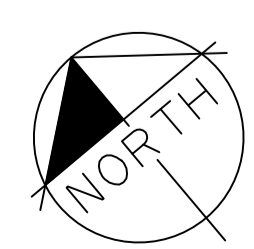
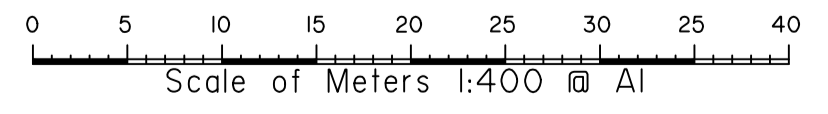


- LEGEND**
- Sewer Line
 - Lot Boundary
 - Stage Boundary
 - Manhole / Maintenance Structure

ABBREVIATIONS - Sewer Main

- | | |
|------|---------------------------------------|
| Mat | Material |
| DSIL | Down stream invert level |
| USIL | Up stream invert level |
| SL | Surface level |
| LGTH | Length of pipe from Manhole to Mahole |

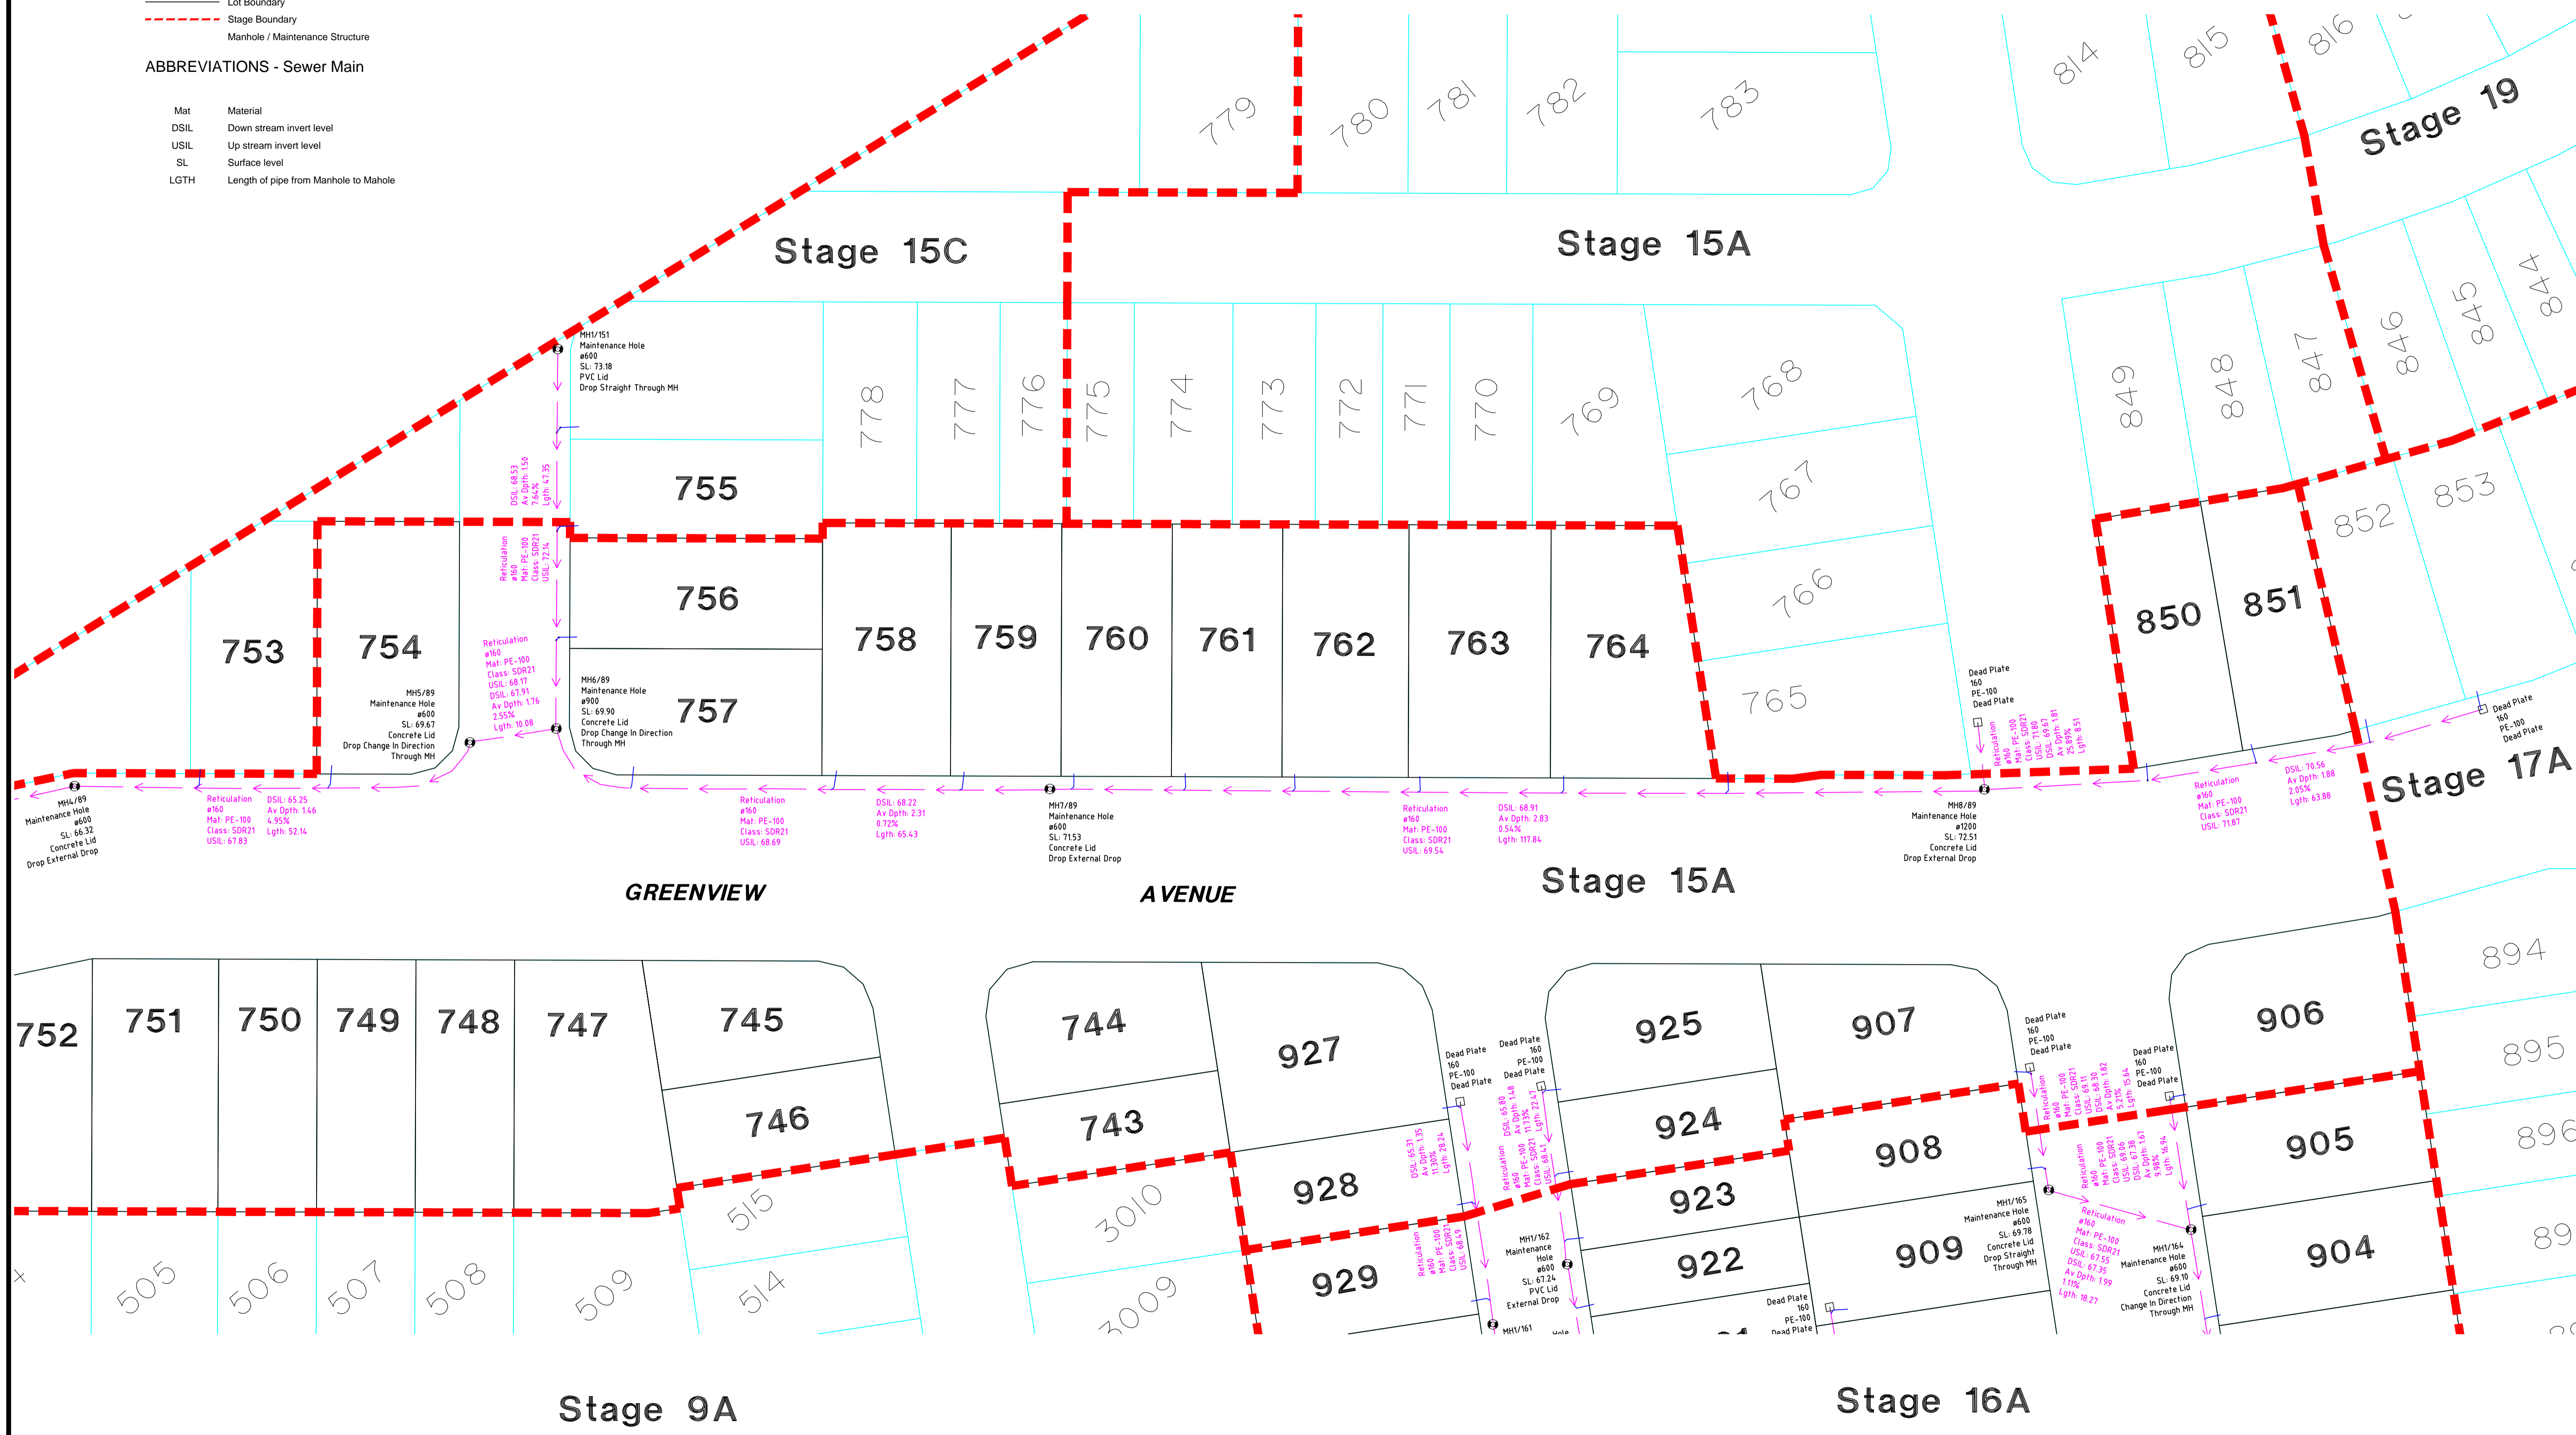

BUILDERS ISSUE

PROJECT Providence, Ripley	
LEVEL DATUM AHD	SCALE 1:400 @ A1
ORIGIN OPM6030I RL 44-315 Barrams Rd Sth Ripley	Date DECEMBER 2016
FB : TSC3	Comp by RPS
LB :	DWG 116052 Sewer Mains

CLIENT AMEX CORP. PTY LTD	
AS CONSTRUCTED SEWER RETICULATION MAIN STAGE 15A	
Parish Local Authority	Job Ref 116052-14

RPS

© COPYRIGHT PROTECTS THIS PLAN
Unauthorized reproduction or amendment
not permitted. Please contact the author.

RPS Australia East Pty Ltd
ACN 140 292 762
ABN 44 140 292 762
180 Brisbane Street
PO Box 341
Ipswich QLD 4305
T +61 7 3437 2000
F +61 7 3434 2099
W rpsgroup.com.au

Reference
116052-111

Rev