
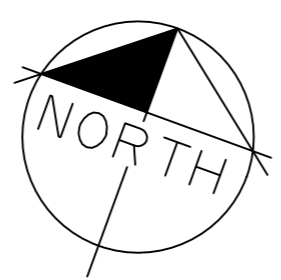


SURVEY DATUM
 Coordinate System: Local Site.
 Horizontal Azimuth: GDA94
 Vertical Datum: AHD71

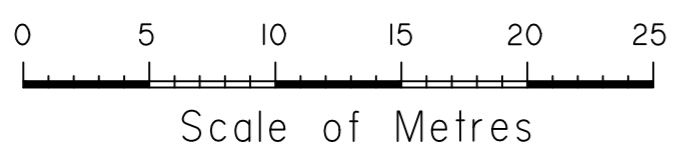

BUILDERS ISSUE

| | |
|--|---|
| PROJECT Providence, Ripley | |
| LEVEL DATUM AHD | SCALE 1:300 @ A1 |
| ORIGIN OPM60301 RL 44-315 Barrams Rd Sth Ripley | Date MAY 2016 Surveyed RPS Comp by DJL |
| FB : TSC3 | LB : DWG: 116052 Sewer Main |

| | |
|--|-------------------|
| CLIENT AMEX CORP. PTY LTD | |
| AS CONSTRUCTED SEWER RETICULATION MAIN STAGE 14 | |
| Parish | Job Ref 116052 |
| Local Authority IPSWICH CITY COUNCIL | |

RPS

©COPYRIGHT PROTECTS THIS PLAN
 Unauthorised reproduction or amendment
 not permitted. Please contact the author.

RPS Australia East Pty Ltd
 ACN 140 292 762
 ABN 44 140 292 762
 180 Brisbane Street
 PO Box 341
 Ipswich QLD 4305
 T +61 7 3437 2000
 F +61 7 3434 2099
 W rpsgroup.com.au

| | |
|-------------------------------|-----|
| Reference 116052-86 | Rev |
|-------------------------------|-----|