


**SURVEY DATUM**

Coordinate System: Local Site.  
Horizontal Azimuth: GDA94  
Vertical Datum: AHD71

0 5 10 15 20 25  
Scale of Metres

**BUILDERS ISSUE**

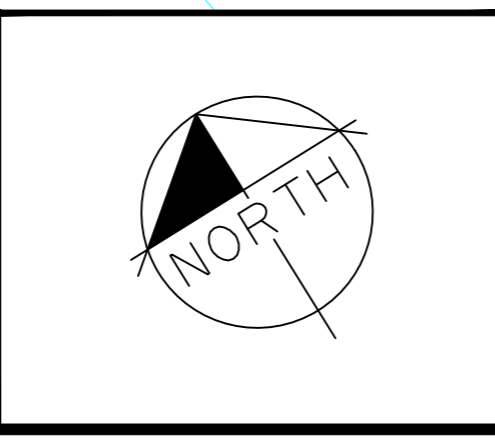

PROJECT <b>Providence, Ripley</b>		CLIENT <b>AMEX CORP. PTY LTD</b>	
LEVEL DATUM AHD	SCALE <b>1:250 @ A1</b>	<b>AS CONSTRUCTED SEWER RETICULATION MAIN STAGE 8A</b>	
ORIGIN OPM60301 RL 44-315 Barrams Rd Sth Ripley	Date MAY 2016 Surveyed RPS Comp by DJL		
FB : TSC3	LB :	DWG 116052 Sewer Mains	Job Ref 116052

Parish	Local Authority IPSWICH CITY COUNCIL
--------	---

**RPS**

©COPYRIGHT PROTECTS THIS PLAN  
Unauthorised reproduction or amendment  
not permitted. Please contact the author.

RPS Australia East Pty Ltd  
ACN 140 292 762  
ABN 44 140 292 762  
180 Brisbane Street  
PO Box 341  
Ipswich QLD 4305  
T +61 7 3437 2000  
F +61 7 3434 2099  
W rpsgroup.com.au

Reference  
**116052-90**

Rev