




**SURVEY DATUM**  
 Coordinate System: MGA94 coordinates  
 Vertical Datum: Australian Height Datum (AHD71)

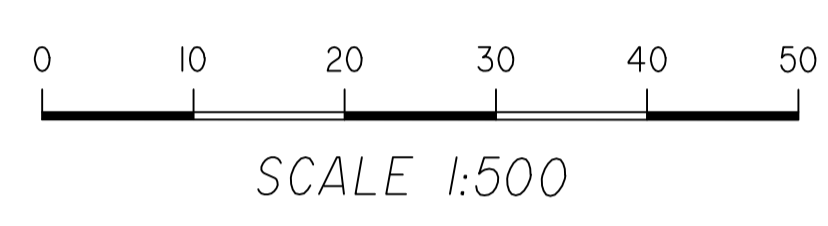

**BUILDERS ISSUE**

PROJECT <b>Providence Ripley</b>		CLIENT <b>AMEX CORP. PTY LTD</b>				
LEVEL DATUM AHD	SCALE <b>1:500 @ A1</b>	<b>AS CONSTRUCTED</b> <b>SEWER MAIN RETICULATION</b> <b>STAGE 6</b>				
ORIGIN OPM60301 RL 44-315 Barrams Rd, S1h Ripley	Date AUG 2015 Surveyed RPS Comp by BR / DJL					
FB : TSC3	LB :	DWG I1605254-6Sewer Mains	Parish Local Authority IPSWICH CITY COUNCIL	Job Ref I16052-12	Reference <b>116052-61</b>	Rev

**RPS**  
 RPS Australia East Pty Ltd  
 ACN 140 292 762  
 ABN 44 140 292 762  
 180 Brisbane Street  
 PO Box 341  
 Ipswich QLD 4305  
 T +61 7 3437 2000  
 F +61 7 3434 2099  
 W rpsgroup.com.au