
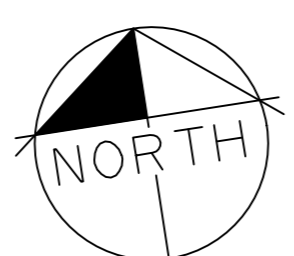


ADDITIONAL HCB INFORMATION

OB 30.009	DIA DN110	
HCSL 72.777	MAT PE100	
HCL 53.096	CL PN8	
HCL 72.777	TYPE C2	
OB 39.333	DIA DN110	
HCSL 72.777	MAT PE100	
HCL 53.035	CL PN8	
HCL 3.870	TYPE C2	
OB 46.999	DIA DN110	
HCSL 72.777	MAT PE100	
HCL 53.888	CL PN8	
HCL 3.886	TYPE C2	
OB 2.701	VIA	
OB 9.900	DIA DN110	
HCSL 72.777	MAT PE100	
HCL 53.551	CL PN8	
HCL 3.863	TYPE C2	
OB 9.900	DIA DN110	
HCSL 72.777	MAT PE100	
HCL 53.610	CL PN8	
HCL 3.787	TYPE B2	
OB 16.381	DIA DN110	
HCSL 72.777	MAT PE100	
HCL 54.048	CL PN8	
HCL 3.890	TYPE B2	

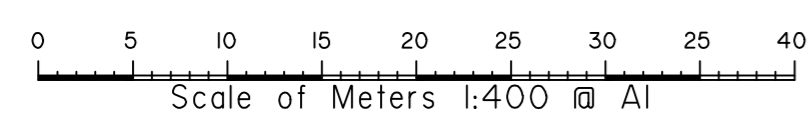

PROJECT Providence, Ripley		CLIENT AMEX CORP. PTY LTD	
LEVEL DATUM AHD	SCALE 1:400 @ A1	AS CONSTRUCTED SEWER RETICULATION MAIN STAGE 8B - SHEET 2	
ORIGIN OPM60301 RL 44-315 Barrams Rd Sth Ripley	Date JULY 2016	Parish	Job Ref 116052-14
FB : TSC3	LB :	DWG 116052 Sewer Mains	Local Authority IPSWICH CITY COUNCIL

RPS

RPS Australia East Pty Ltd
ACN 140 292 762
ABN 44 140 292 762
180 Brisbane Street
PO Box 341
Ipswich QLD 4305
T +61 7 3437 2000
F +61 7 3434 2099
W rpsgroup.com.au

BUILDERS ISSUE