

LEGEND


- House Connection
- Sewer Line
- Subject Lot Boundary
- Adjoining Lot Boundary
- Stage Boundary
- Manhole / Maintenance Structure
- Manhole / Maintenance Structure Construction Not Completed

ABBREVIATIONS - House Connection


- CH Chainage of Obtuse Bend (Distance from Downstream Invert Level)
- SL Surveyed Surface Level (at House Connection)
- LGTH House Connection Length (Horizontal Length)
- IL Invert Level of House Connection
- OS Offset of house connection IL from line
- IO Distance along pipe from inspection opening to Downstream IL



Issue	Description	Date
Original	Original Builders issue	15/05/2017
A	HC Details Added (1229, 1241 & 1265)	30/05/2017

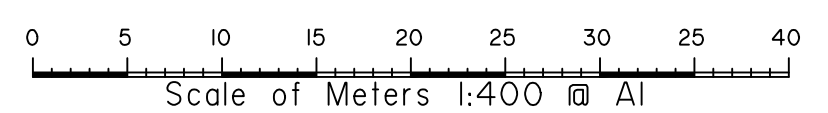

BUILDERS ISSUE

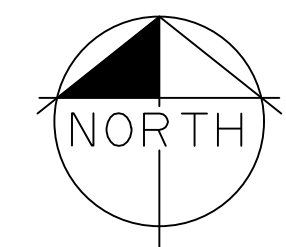

PROJECT Providence South, Ripley	
LEVEL DATUM AHD	SCALE 1:400 @ A1
ORIGIN OPM60301 RL 44-315 Barrams Rd Sth Ripley	Date MAY 2017
FB : TSC3 LB :	Surveyed RPS
	Comp by BR
	DWG I16052 Sewer House

CLIENT AMEX CORPORATION PTY. LTD.	
AS CONSTRUCTED SEWER HOUSE CONNECTIONS STAGE 30	
Local Authority IPSWICH CITY COUNCIL	Job Ref I16052-29

RPS Australia East Pty Ltd
 ACN 140 292 762
 ABN 44 140 292 762
 180 Brisbane Street
 PO Box 341
 Ipswich QLD 4305
 T +61 7 3437 2000
 F +61 7 3434 2099
 W rpsgroup.com.au

Reference 116052-166	Rev A
--------------------------------	-----------------