


SURVEY DATUM


Coordinate System: MGA94 coordinates

Vertical Datum: Australian Height Datum (AHD71)

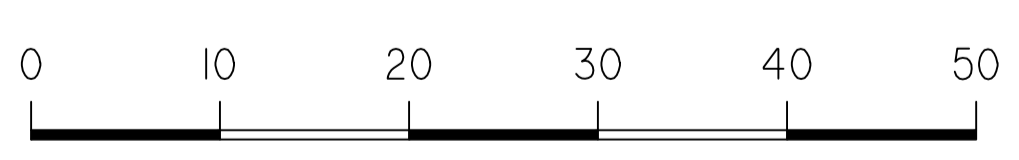

SCALE 1:400

BUILDERS ISSUE

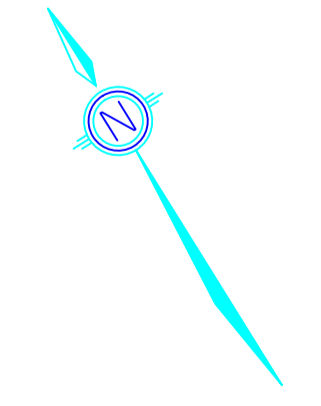

PROJECT Providence, Ripley		CLIENT AMEX CORP. PTY LTD	
LEVEL DATUM AHD	SCALE 1:400 @ A1	AS CONSTRUCTED SEWER HOUSE CONNECTIONS STAGE 6	
ORIGIN OPM60301 RL 44-315 Barrams Rd Sth Ripley	Date AUG 2015 Surveyed RPS		
FB : TSC3	LB :	Comp by BR	Parish IPSWICH CITY COUNCIL
		DWG I16052S4-6SewerHC	Job Ref I16052
Reference 116052-59		Rev	

RPS

© COPYRIGHT PROTECTS THIS PLAN
Unauthorized reproduction or amendment
not permitted. Please contact the author.

RPS Australia East Pty Ltd
ACN 140 292 762
ABN 44 140 292 762
180 Brisbane Street
PO Box 341
Ipswich QLD 4305
T +61 7 3437 2000
F +61 7 3434 2099
W rpsgroup.com.au