


AS CONSTRUCTED
 S.G. LONG & ASSOCIATES PTY LTD
 Engineering Surveyors, hereby
 certify this drawing as a true
 and correct representation
 of the As-constructed Works.

Signature.....
 SUNSTATE ENGINEERING SURVEYS

BUNDAMBA CREEK

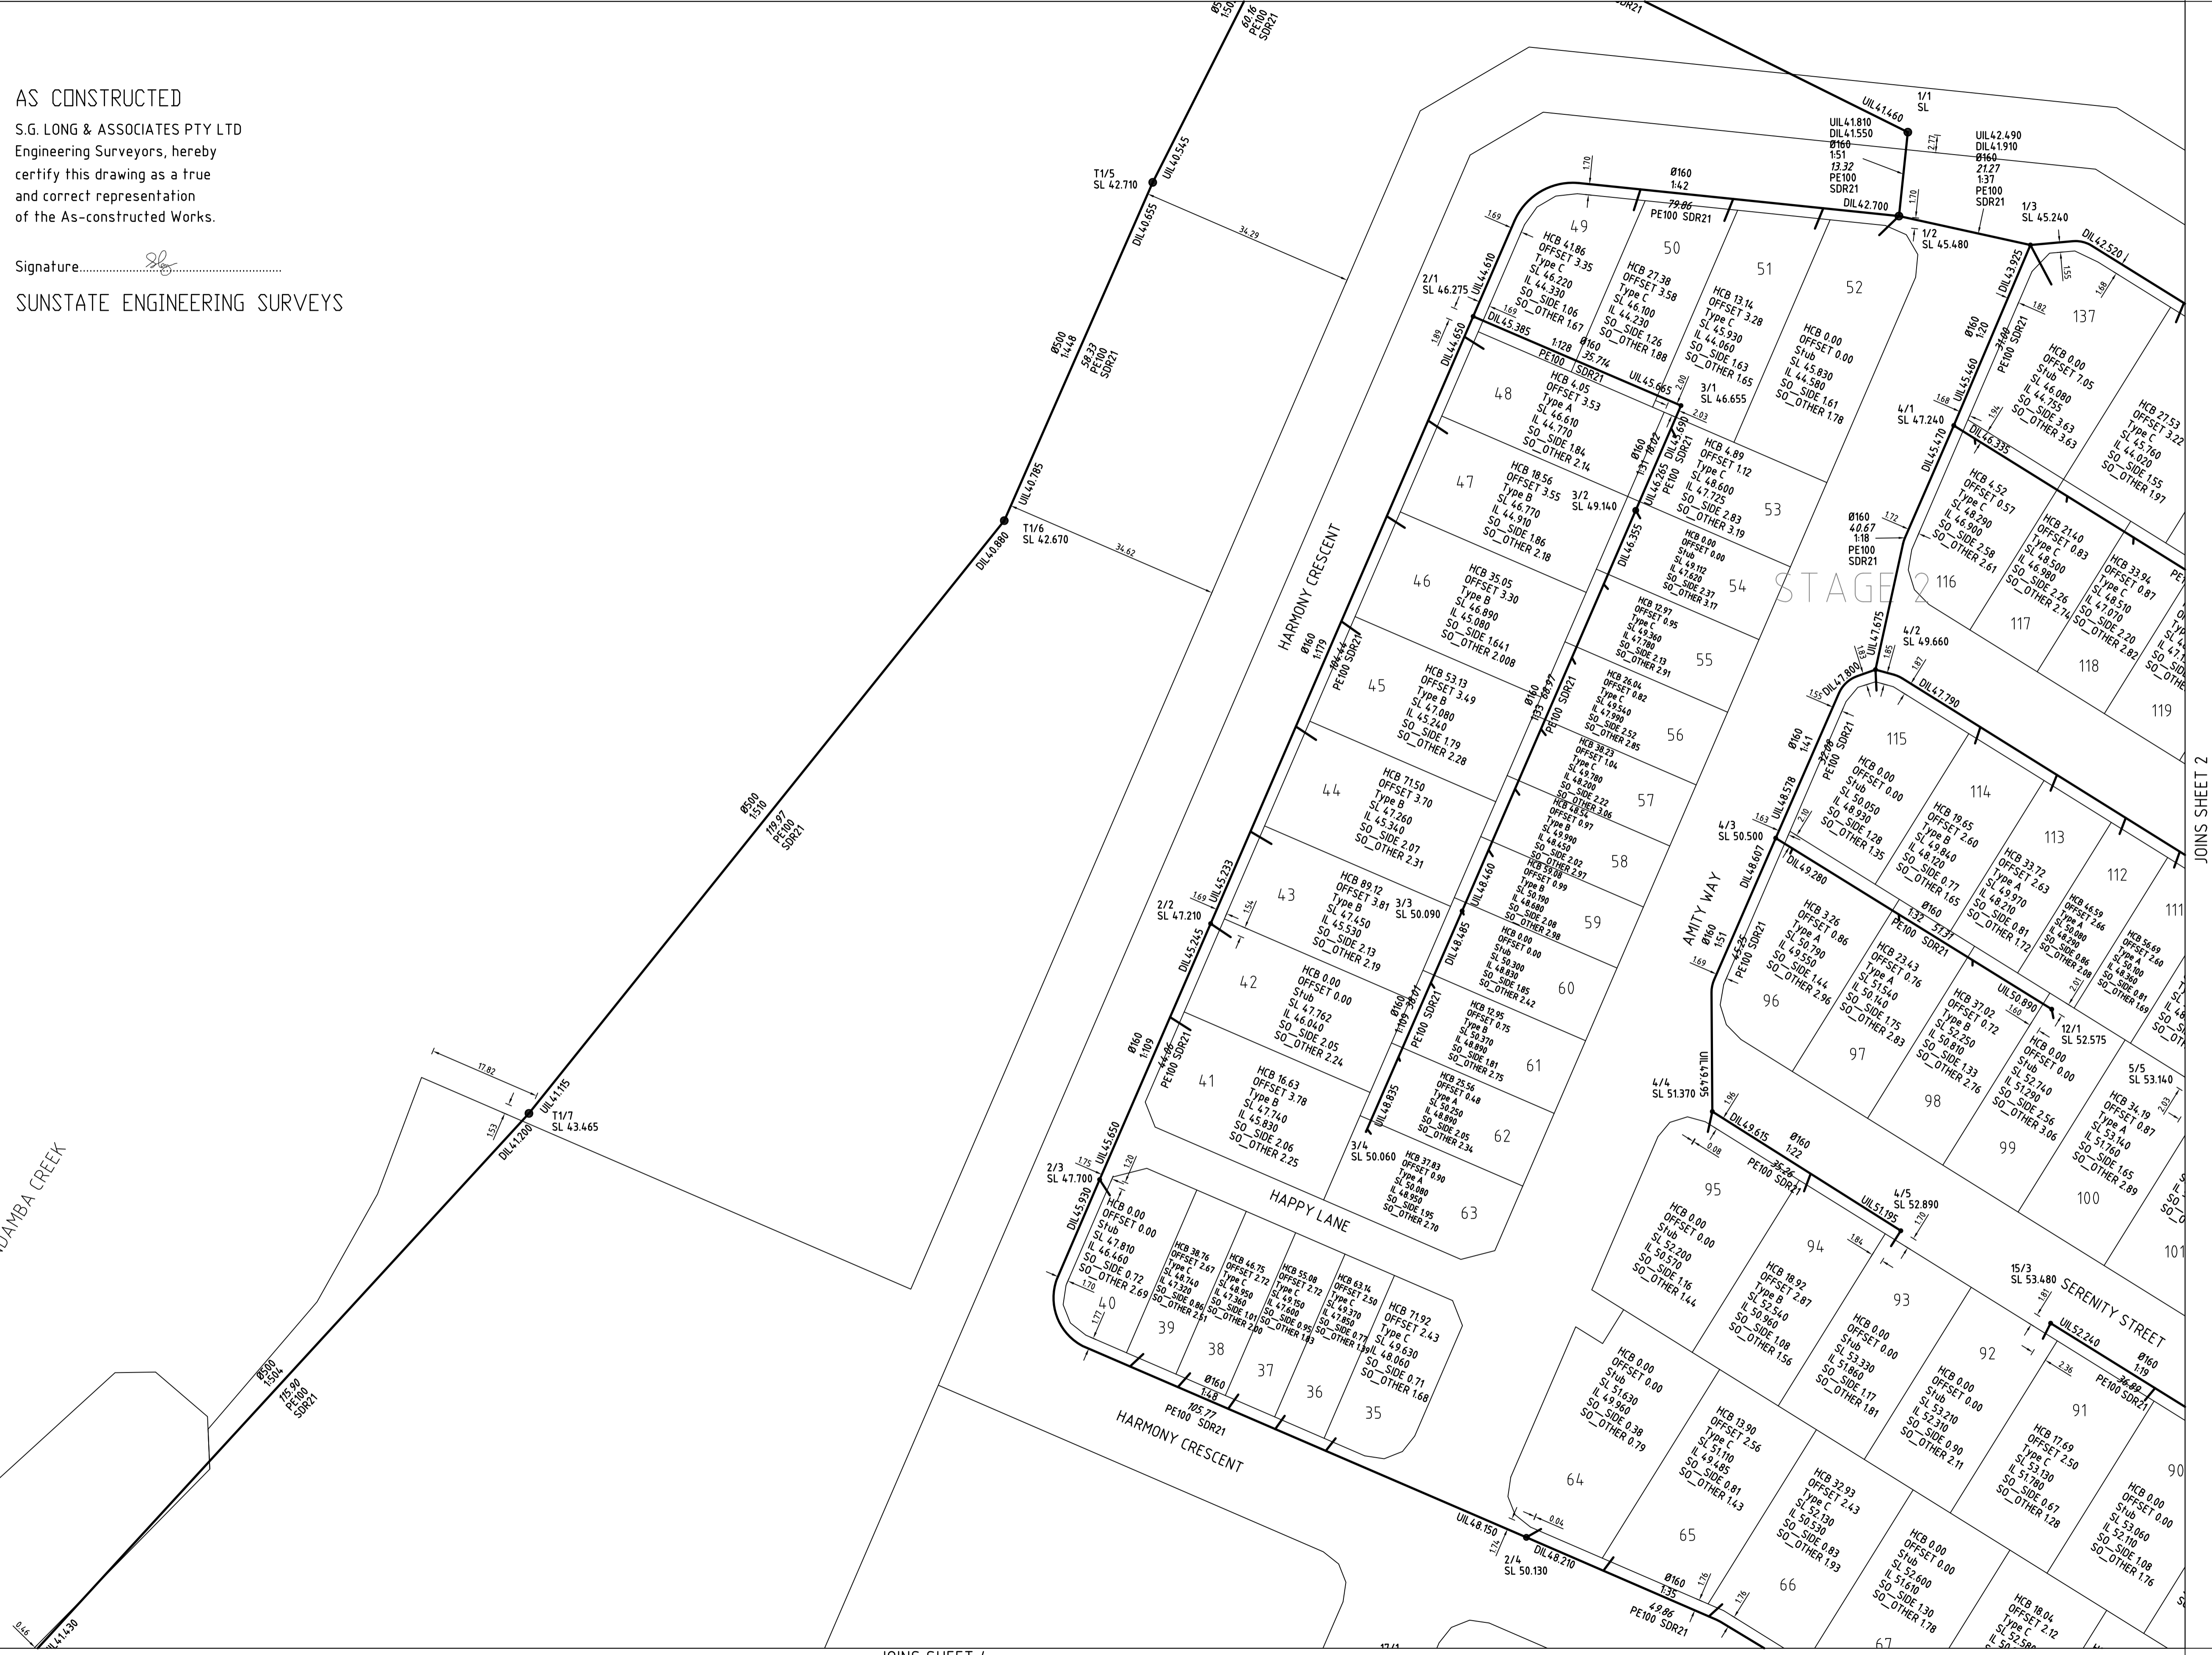



SUNSTATE ENGINEERING SURVEYS A.B.N. 33 011 008 521 Unit 2/44 Storie Street, CLONTARF, Q. 4019 Phone: (07) 3283 7611 Fax: (07) 3283 7633 Mobile: 0411 171 322 Email: shane@sunstatesurveys.com.au		SURVEYED DK DRAWN GH CHECKED	No. 1 OF 5 SHEETS DATUM: A.H.D.	BMD URBAN 25 Cambridge Parade MANLY, QLD Ph: (07) 3893 7000 Fax: (07) 3893 4088	RIPLEY - SUCE AS-CONSTRUCTED SEWER RETICULATION STAGES 1, 2 and 3	DRAWING No. 14020-020 SCALE: 1 : 500 at A1	REV. A
--	--	------------------------------------	------------------------------------	---	--	---	--------

AS CONSTRUCTED

S.G. LONG & ASSOCIATES PTY LTD
Engineering Surveyors, hereby
certify this drawing as a true
and correct representation
of the As-constructed Works.

Signature.....


SUNSTATE ENGINEERING SURVEYS

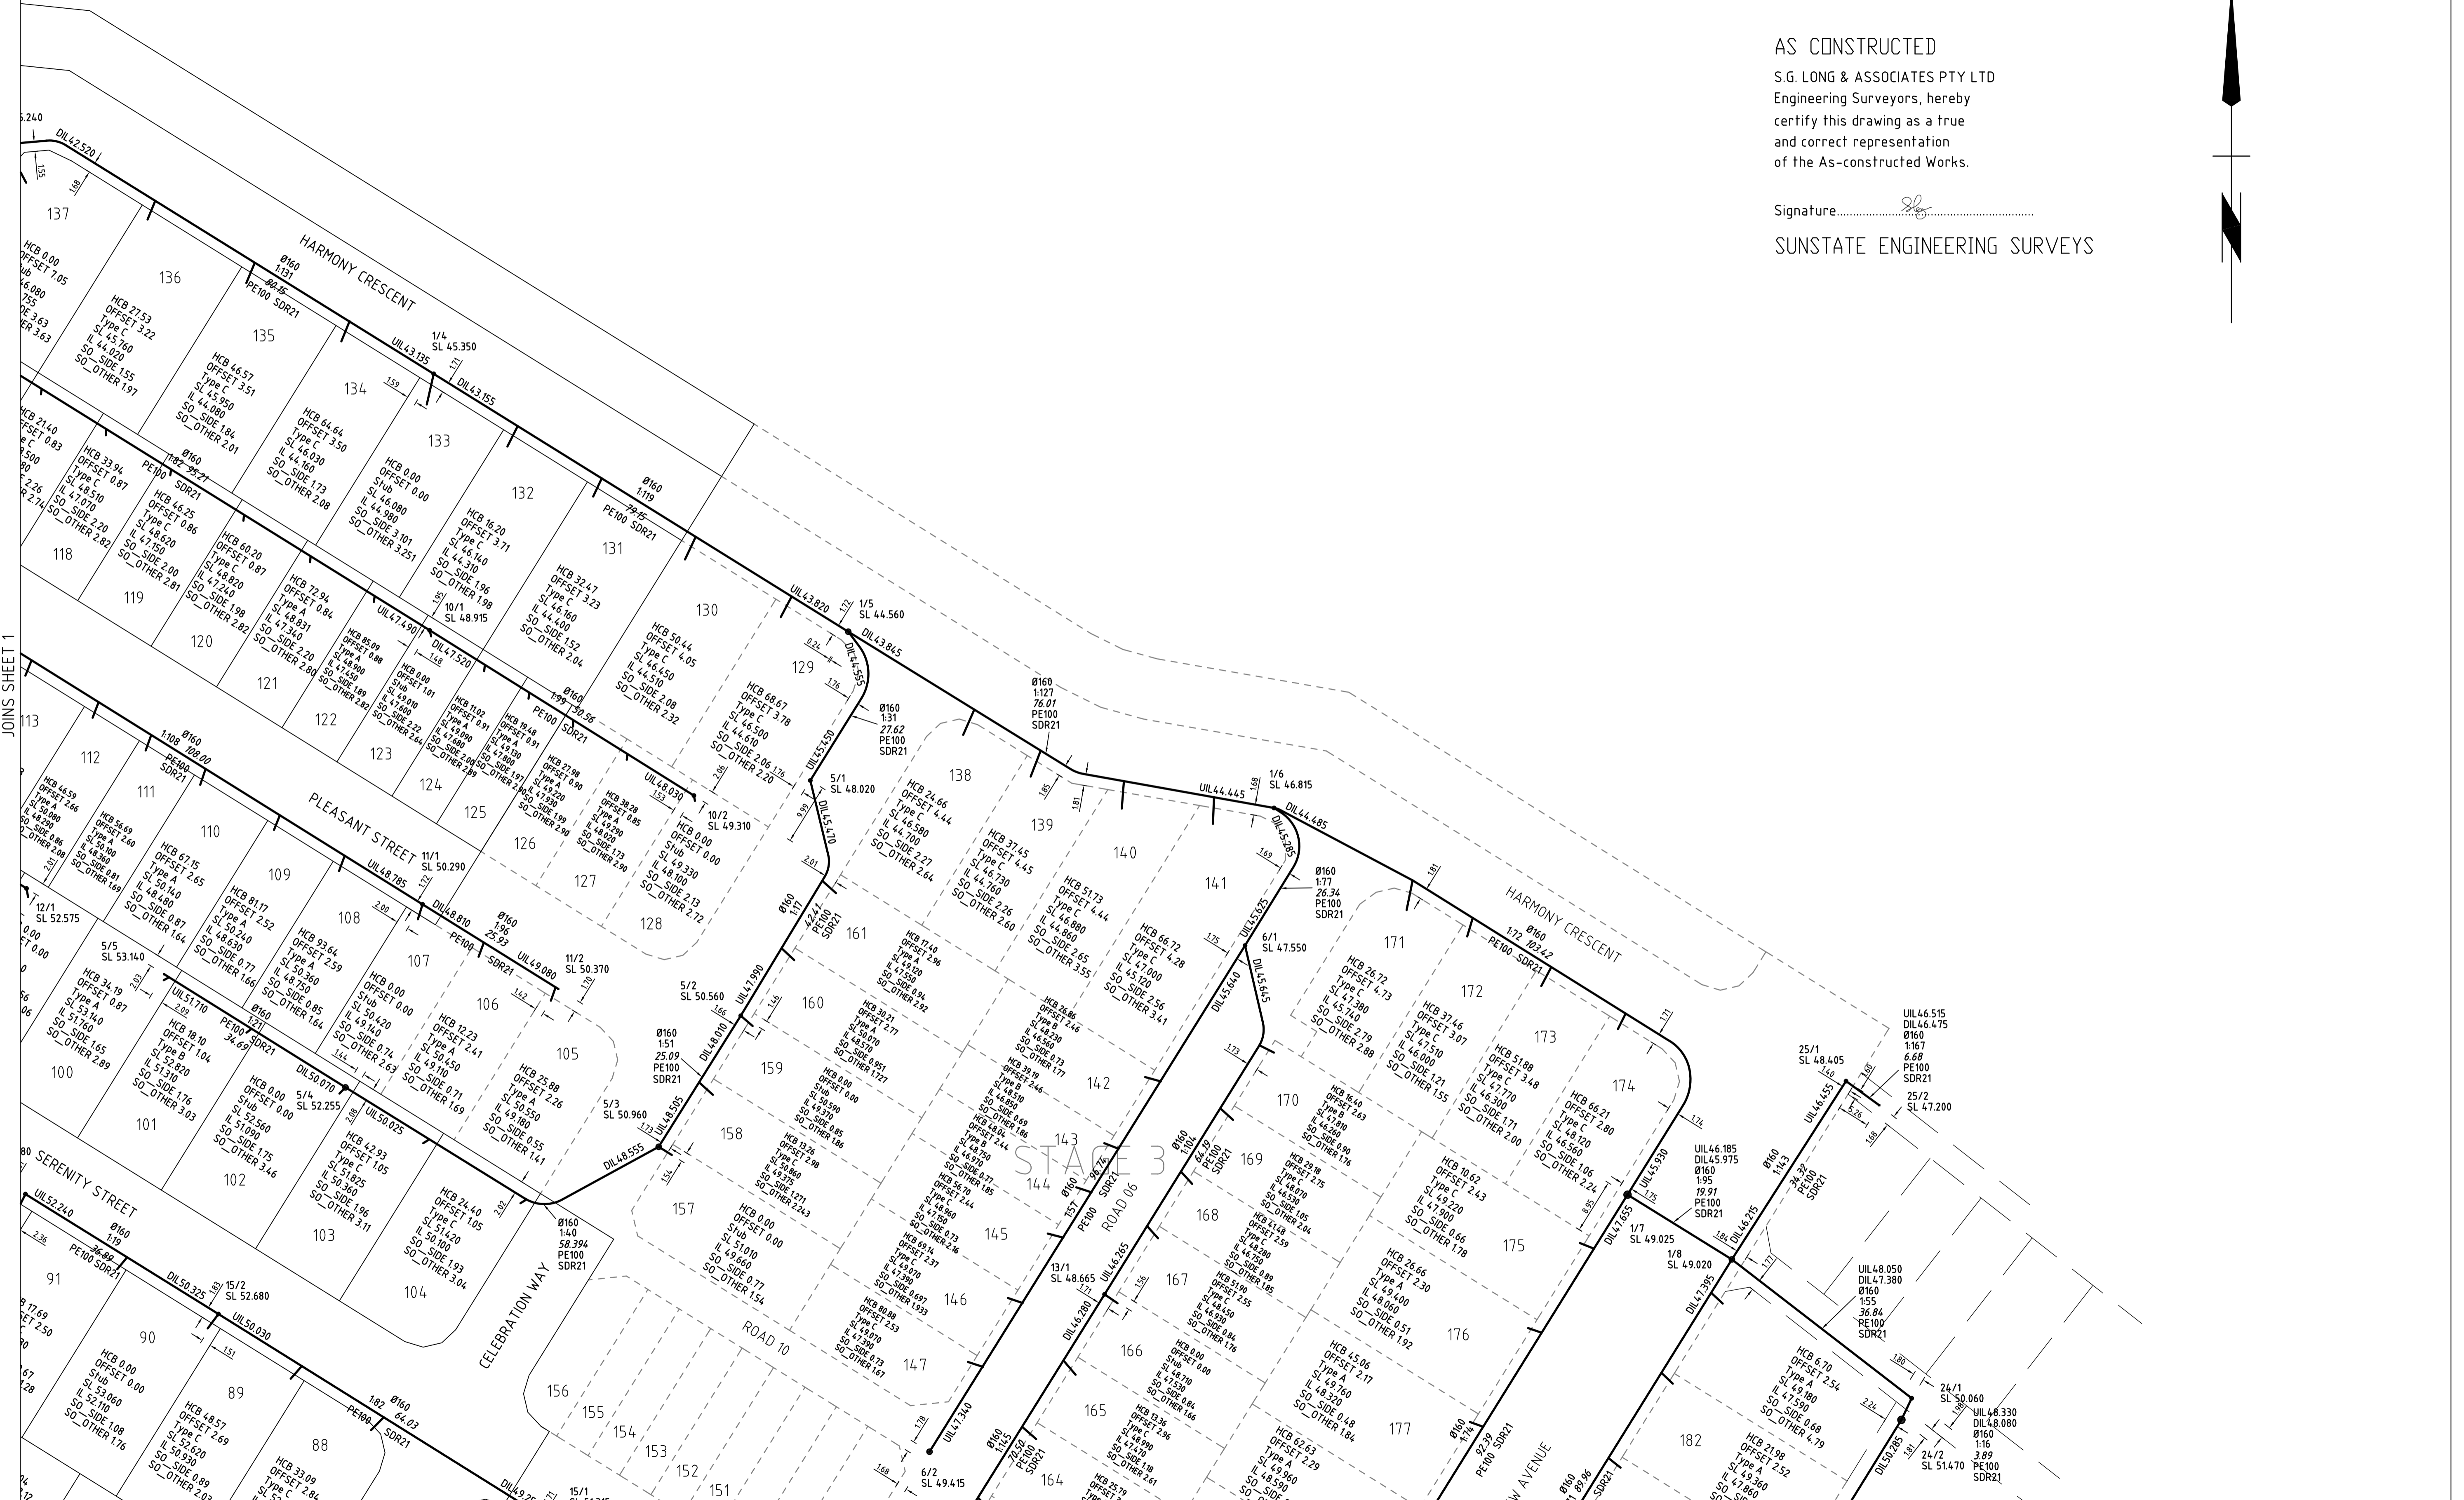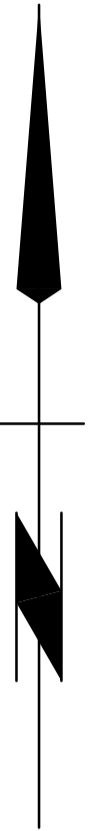

JOINS SHEET 1

JOINS SHEET 3

SUNSTATE ENGINEERING SURVEYS A.B.N. 33 011 008 521 Unit 2/44 Storie Street, CLONTARF, Q. 4019 Phone: (07) 3283 7611 Fax: (07) 3283 7633 Mobile: 0411 171 322 Email: shane@sunstatesurveys.com.au		SURVEYED DK DRAWN GH CHECKED	No. 2 OF 5 SHEETS DATUM: A.H.D.	BMD URBAN 25 Cambridge Parade MANLY, QLD Ph: (07) 3893 7000 Fax: (07) 3893 4088	RIPLEY - SUCE AS-CONSTRUCTED SEWER RETICULATION STAGES 1, 2 and 3	DRAWING No. 14020-020 SCALE: 1 : 500 at A1	REV. A
--	--	------------------------------------	------------------------------------	---	--	--	-----------

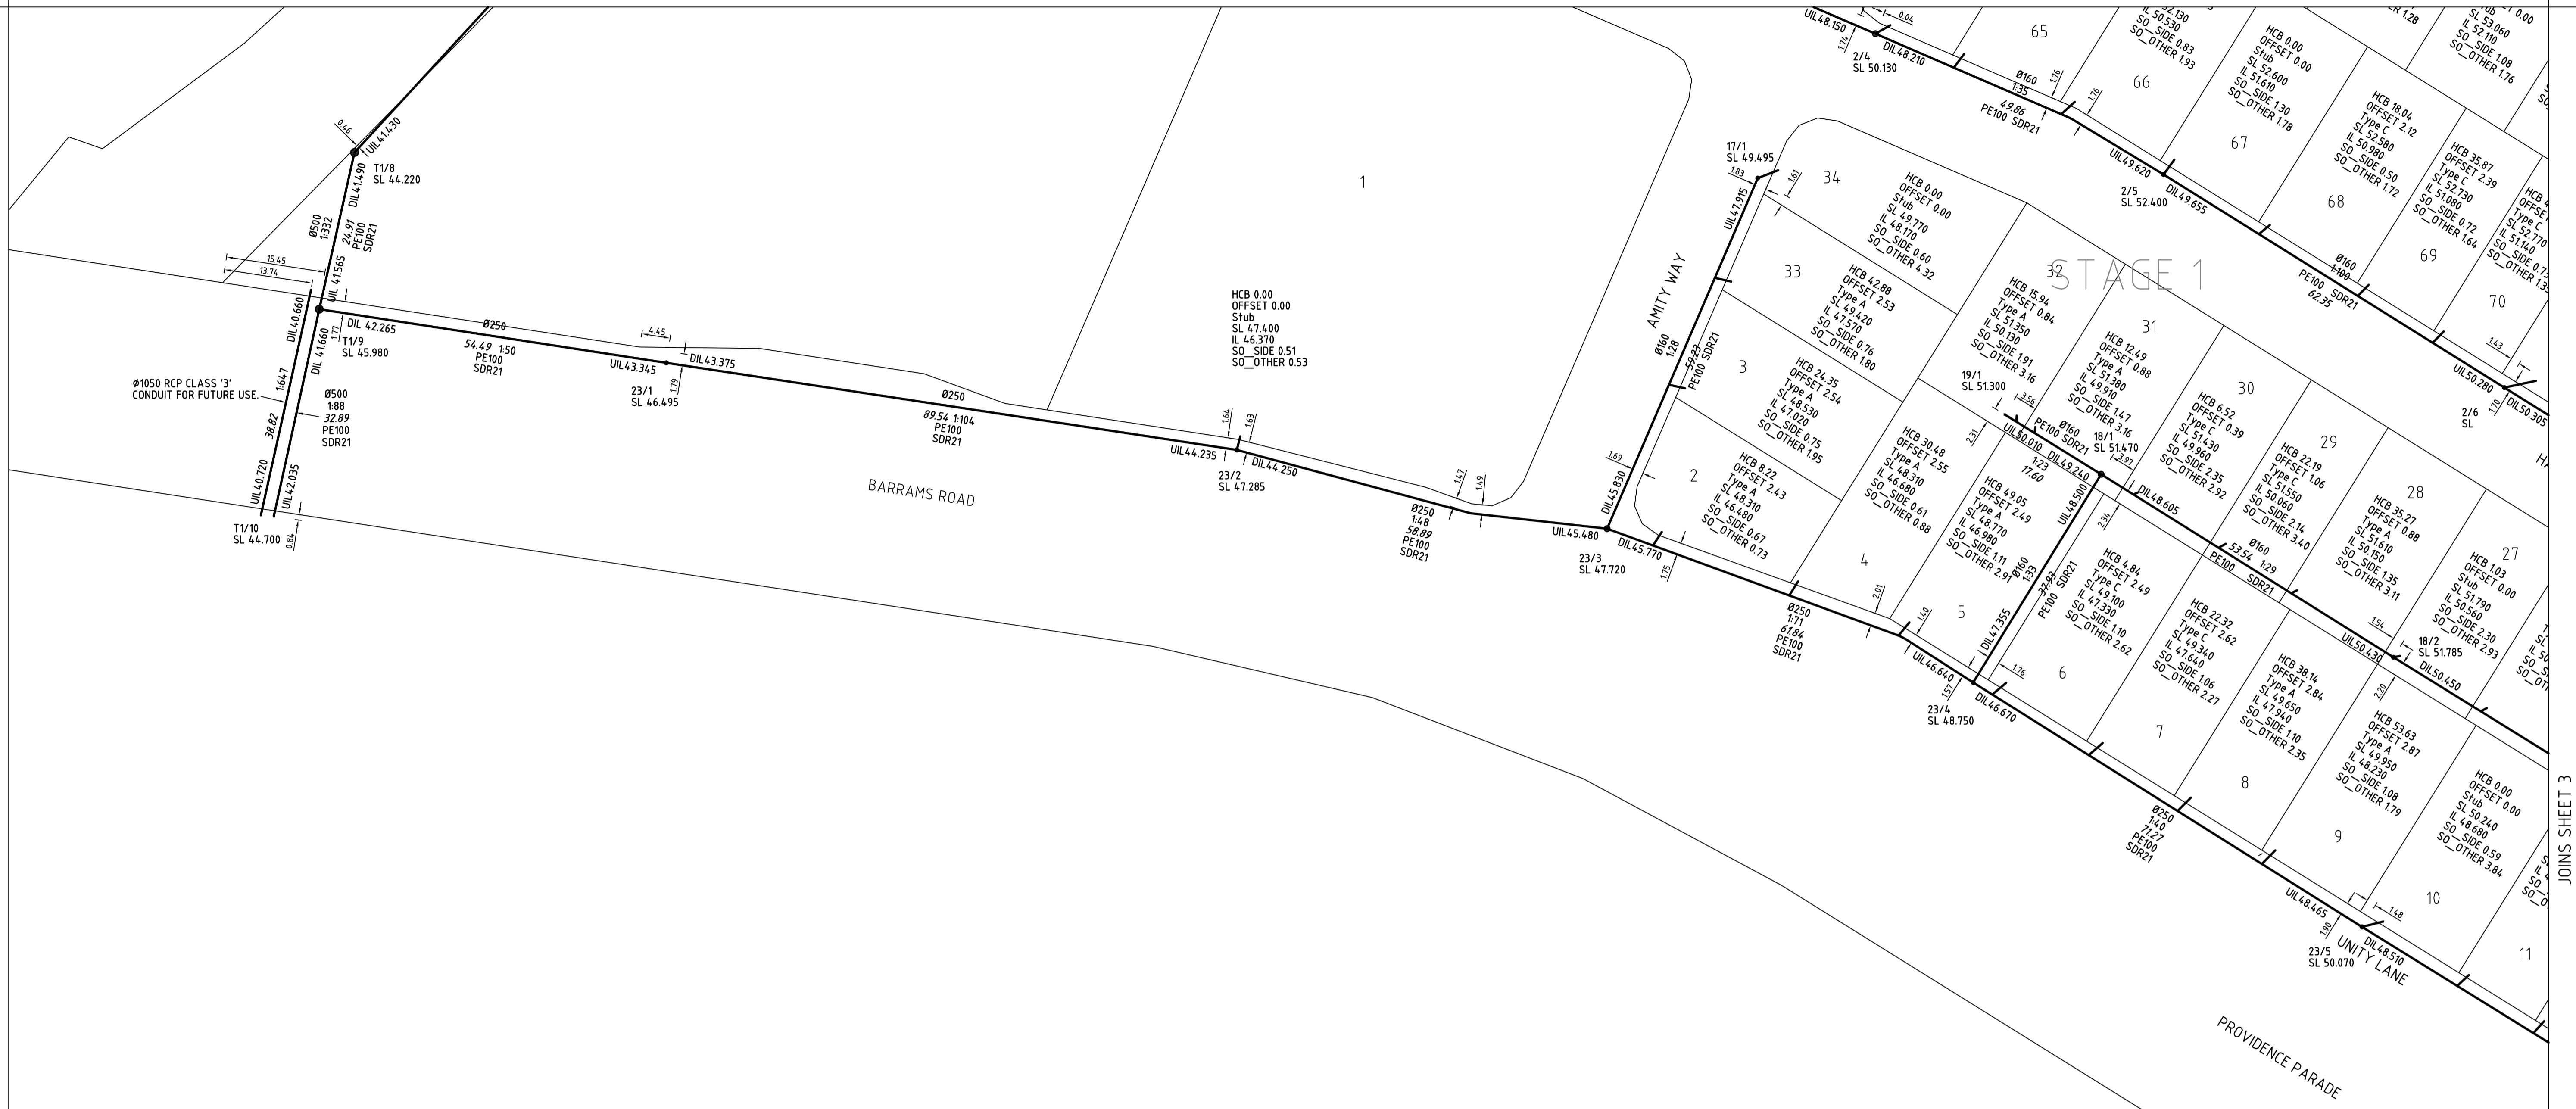

AS CONSTRUCTED

S.G. LONG & ASSOCIATES PTY LTD
 Engineering Surveyors, hereby
 certify this drawing as a true
 and correct representation
 of the As-constructed Works.

Signature: *[Signature]*

SUNSTATE ENGINEERING SURVEYS

SUNSTATE ENGINEERING SURVEYS	
A.B.N. 33 011 008 521	
Unit 2/44 Storie Street, CLONTARF, Q. 4019	
Phone: (07) 3283 7611 Fax: (07) 3283 7633 Mobile: 0411 171 322	
Email: shane@sunstatesurveys.com.au	
A	02.03.2015 AS-CONSTRUCTED

SURVEYED	DK	No. 4 OF
DRAWN	GH	5 SHEETS
CHECKED		DATUM: A.H.D.

BMD URBAN	Ph: (07) 3893 7000
25 Cambridge Parade	Fax: (07) 3893 4088
MANLY, QLD	

RIPLEY - SUCE
AS-CONSTRUCTED
SEWER RETICULATION
STAGES 1, 2 and 3

DRAWING No.	REV.
14020-020	A
SCALE: 1 : 500 at A1	

