




PRELIMINARY
COPY

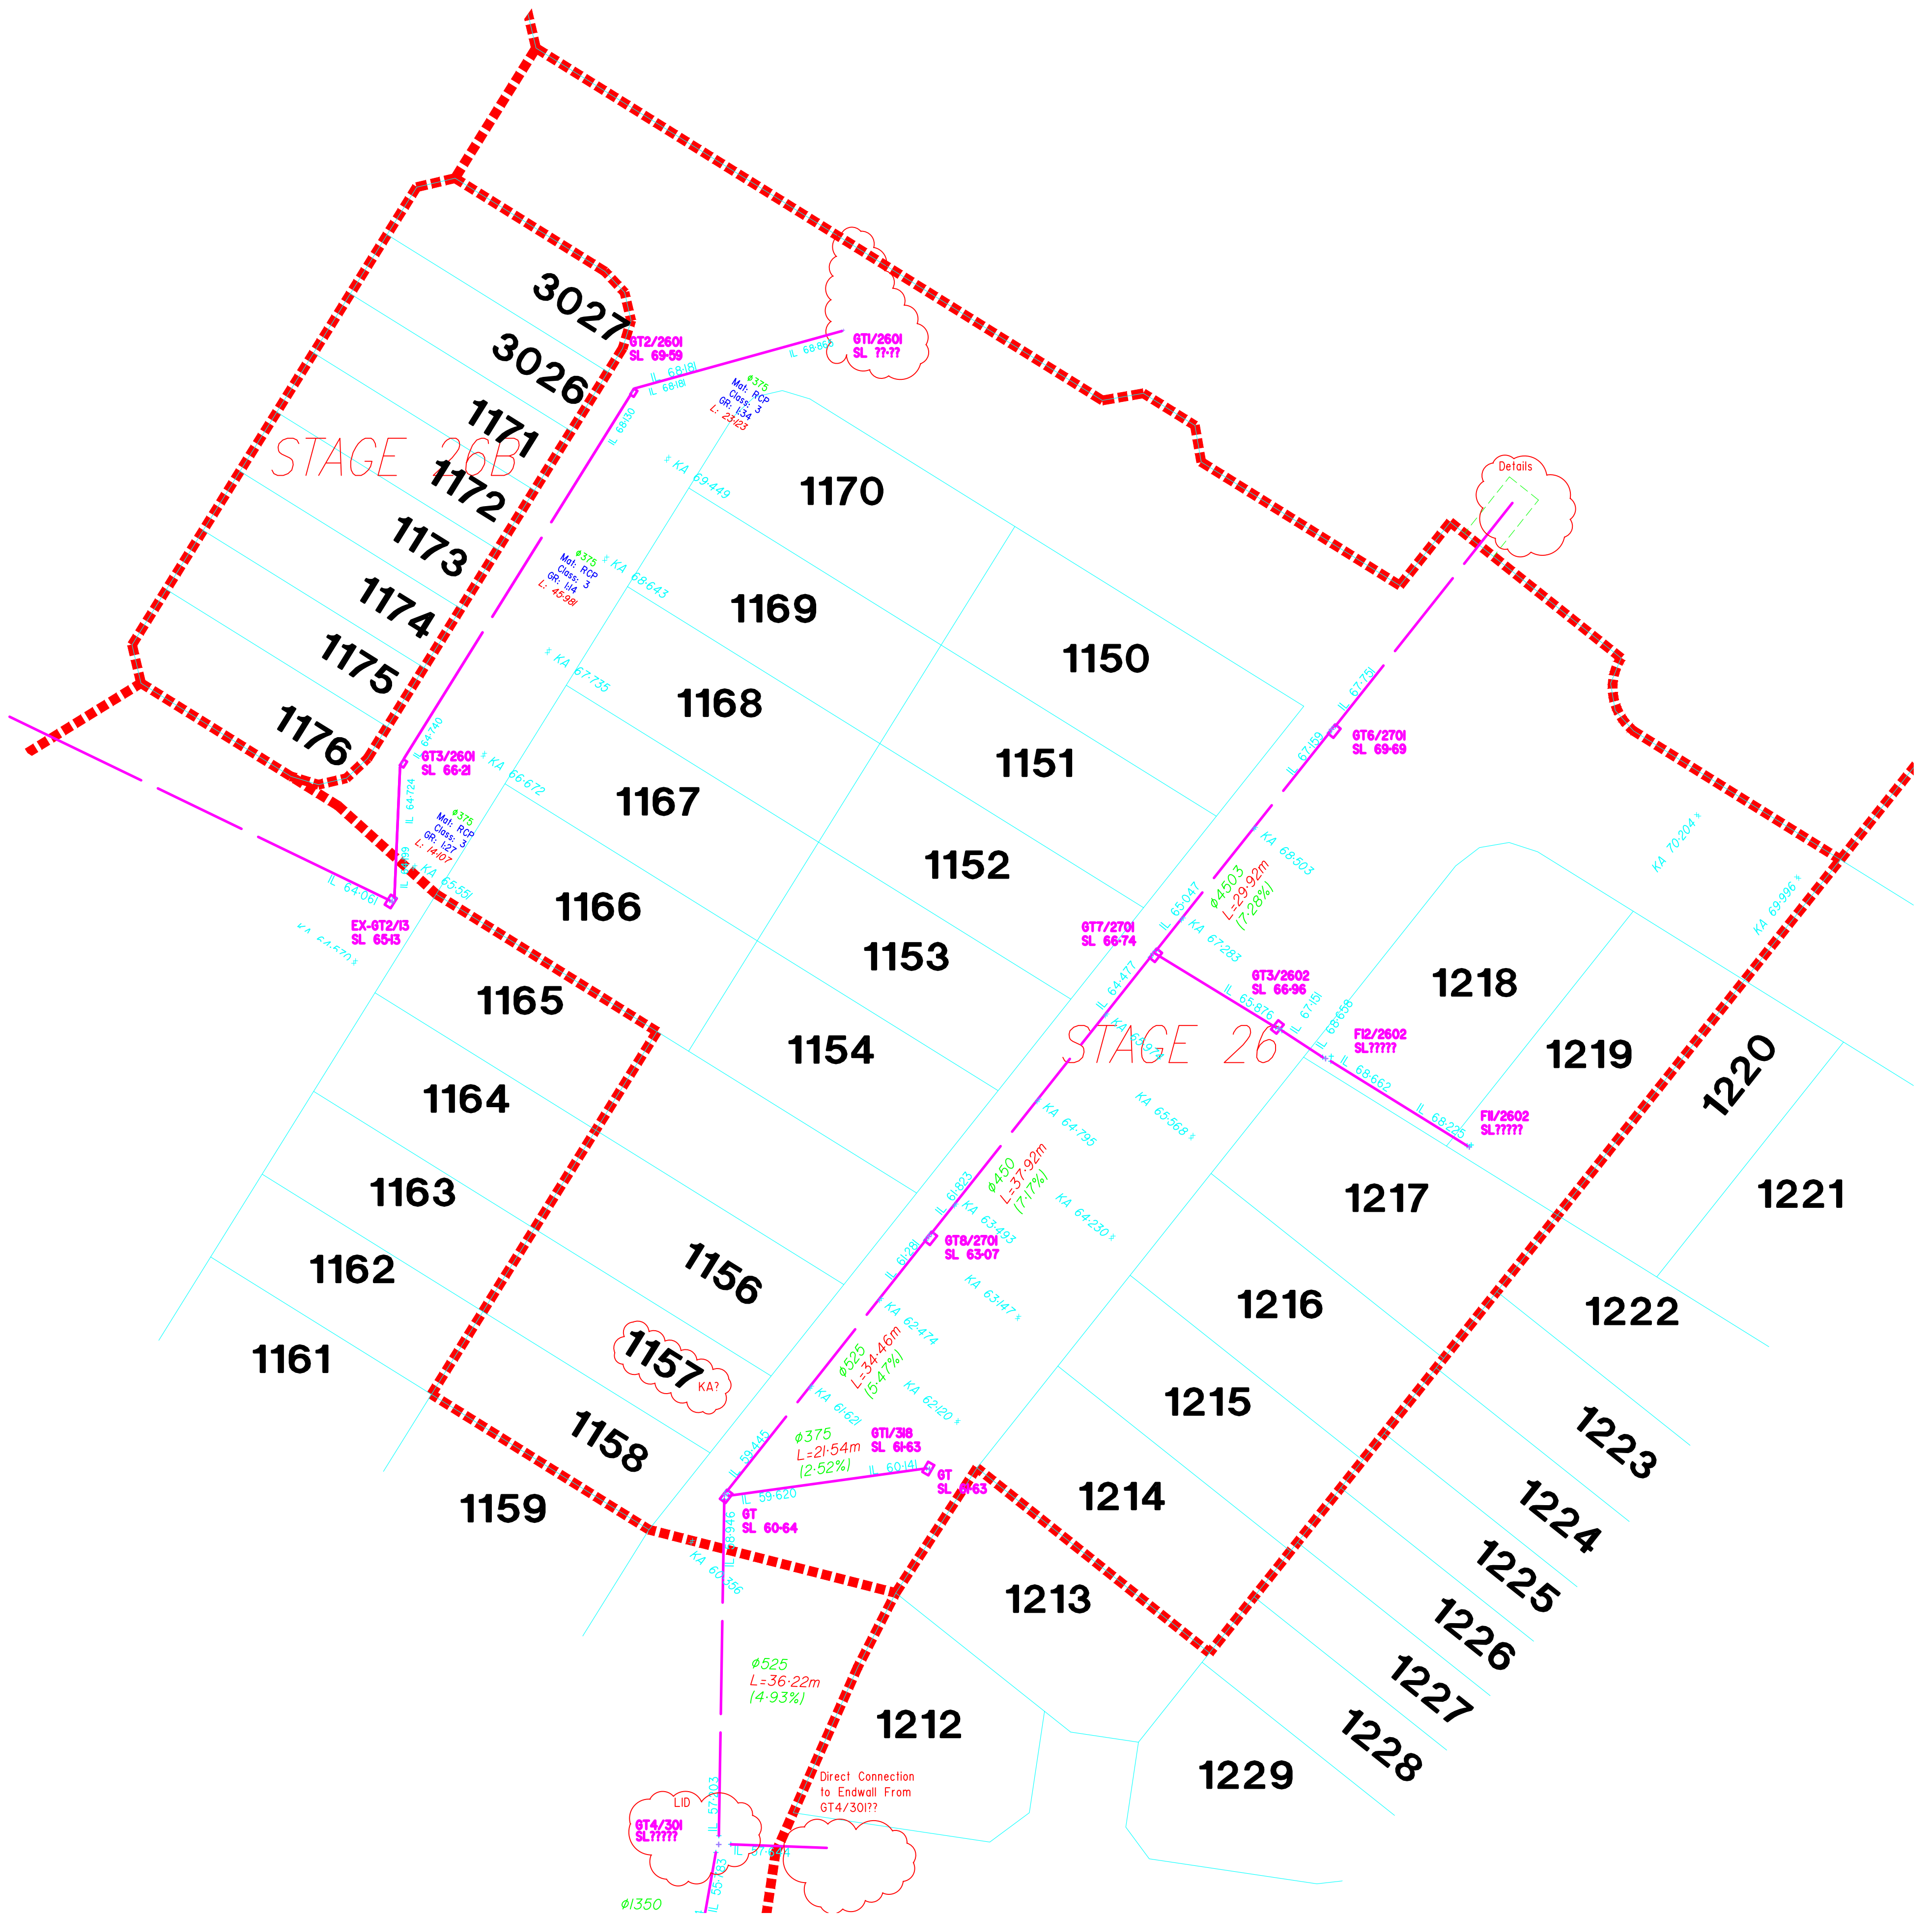

BUILDERS ISSUE

SURVEY DATUM

Coordinate System: Local Site.
Horizontal Azimuth: GDA94
Vertical Datum: AHD71

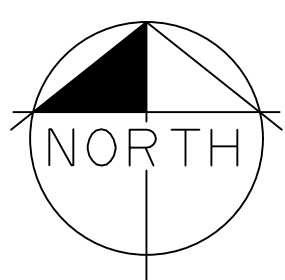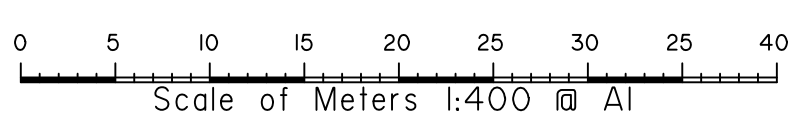

PROJECT Providence, Ripley		CLIENT AMEX CORP. PTY LTD	
LEVEL DATUM AHD	SCALE 1:400 @ A1	AS CONSTRUCTED STORMWATER MAINS STAGE 26	
ORIGIN OPM60301 RL 44-315 Barrams Rd Sth Ripley	Date DEC 2016 Surveyed RPS Comp by DJL		
FB : TSC3	LB :	Parish	Job Ref 116052
DWG Stage 26 27 Storm		Local Authority IPSWICH CITY COUNCIL	



RPS Australia East Pty Ltd
ACN 140 292 762
ABN 44 140 292 762
180 Brisbane Street
PO Box 341
Ipswich QLD 4305
T +61 7 3437 2000
F +61 7 3434 2099
W rpsgroup.com.au

© COPYRIGHT PROTECTS THIS PLAN
Unauthorized reproduction or amendment
not permitted. Please contact the author.

Reference 116052-142	Rev
--------------------------------	-----