


REFER SHEET 2 FOR CONTINUATION

SURVEY DATUM

0 5 10 15 20 25 30 35
Scale of Meters 1:300 @ A1

Coordinate System: Local Site.
Horizontal Azimuth: GDA94
Vertical Datum: AHD71

BUILDERS ISSUE

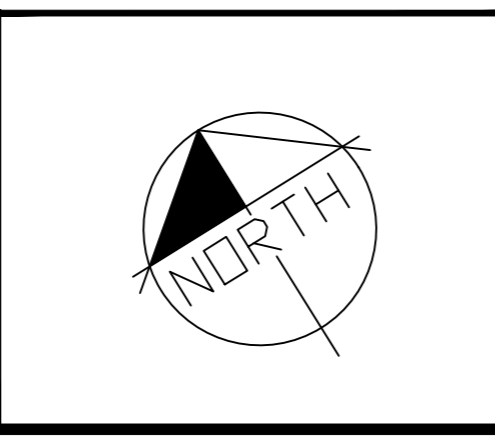

PROJECT Providence, Ripley		CLIENT AMEX CORP. PTY LTD	
LEVEL DATUM AHD	SCALE 1:300 @ A1	AS CONSTRUCTED STORMWATER HOUSE CONNECTIONS STAGE 21 - SHEET 1	
ORIGIN OPM60301 RL 44-315 Barrams Rd Sth Ripley	Date SEPTEMBER 2016 Surveyed RPS Comp by DJL		
FB : TSC3	LB :	DWG 116052S20-21Storm	Parish Local Authority IPSWICH CITY COUNCIL



Job Ref 116052

RPS

RPS Australia East Pty Ltd
ACN 140 292 762
ABN 44 140 292 762
180 Brisbane Street
PO Box 341
Ipswich QLD 4305
T +61 7 3437 2000
F +61 7 3434 2099
W rpsgroup.com.au

©COPYRIGHT PROTECTS THIS PLAN
Unauthorized reproduction or amendment
not permitted. Please contact the author.

Reference 116052-122	Rev
--------------------------------	-----

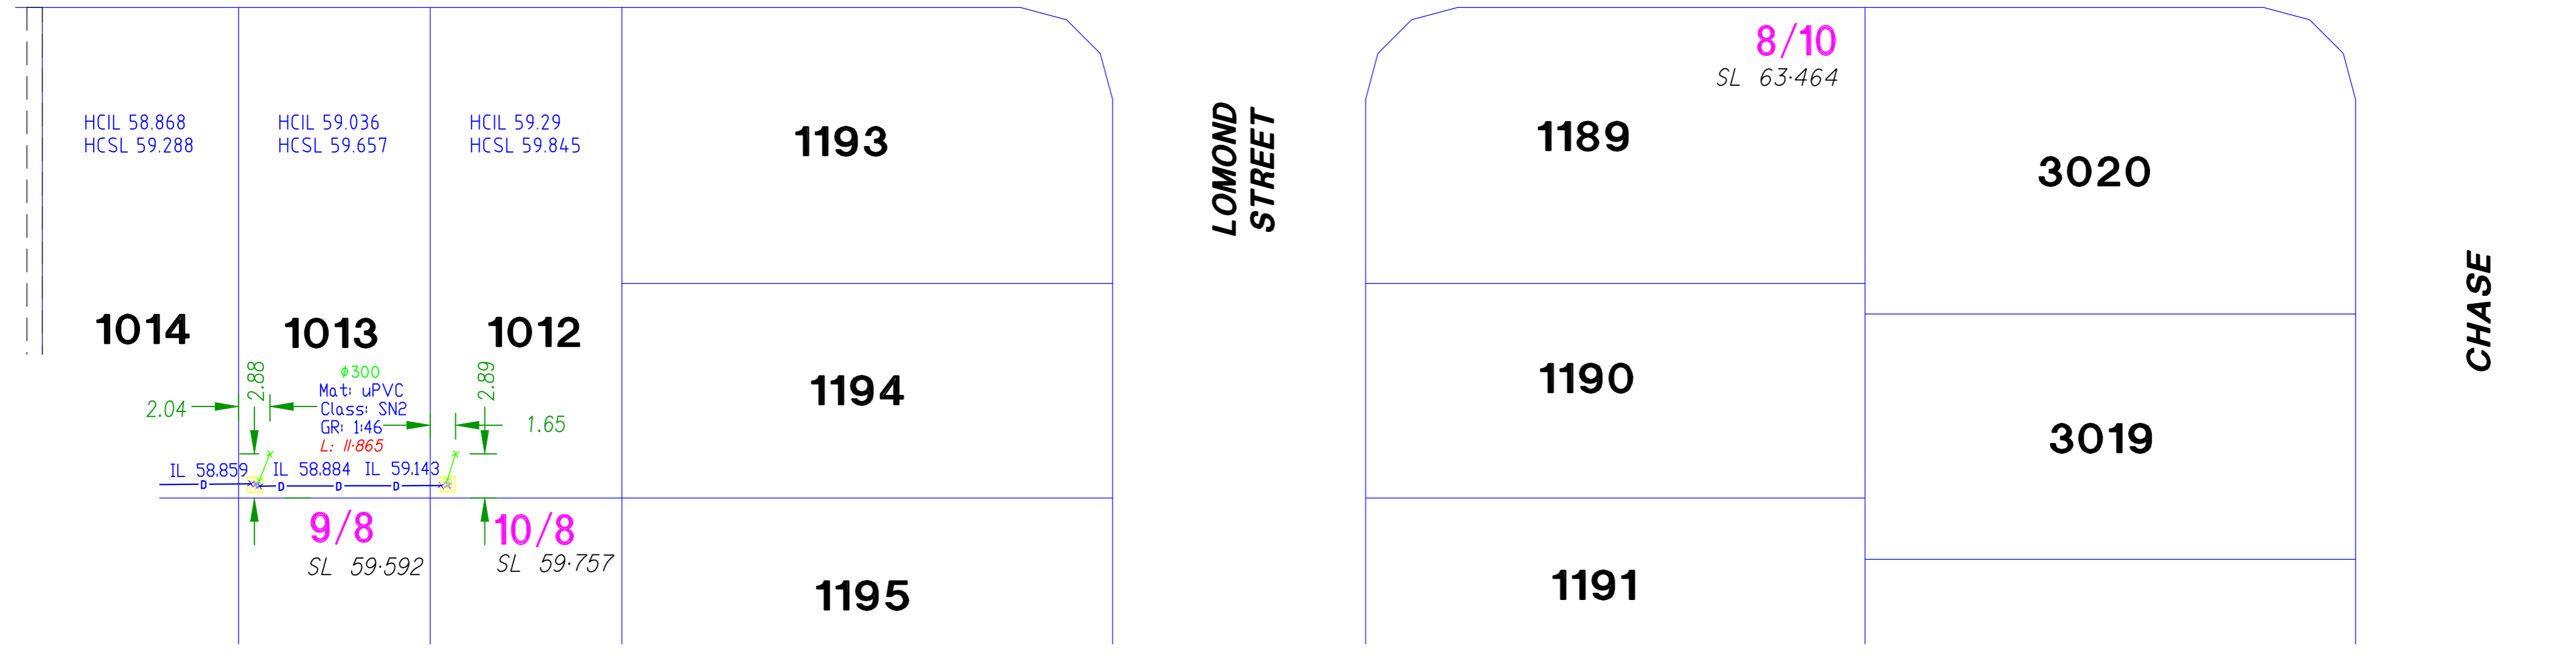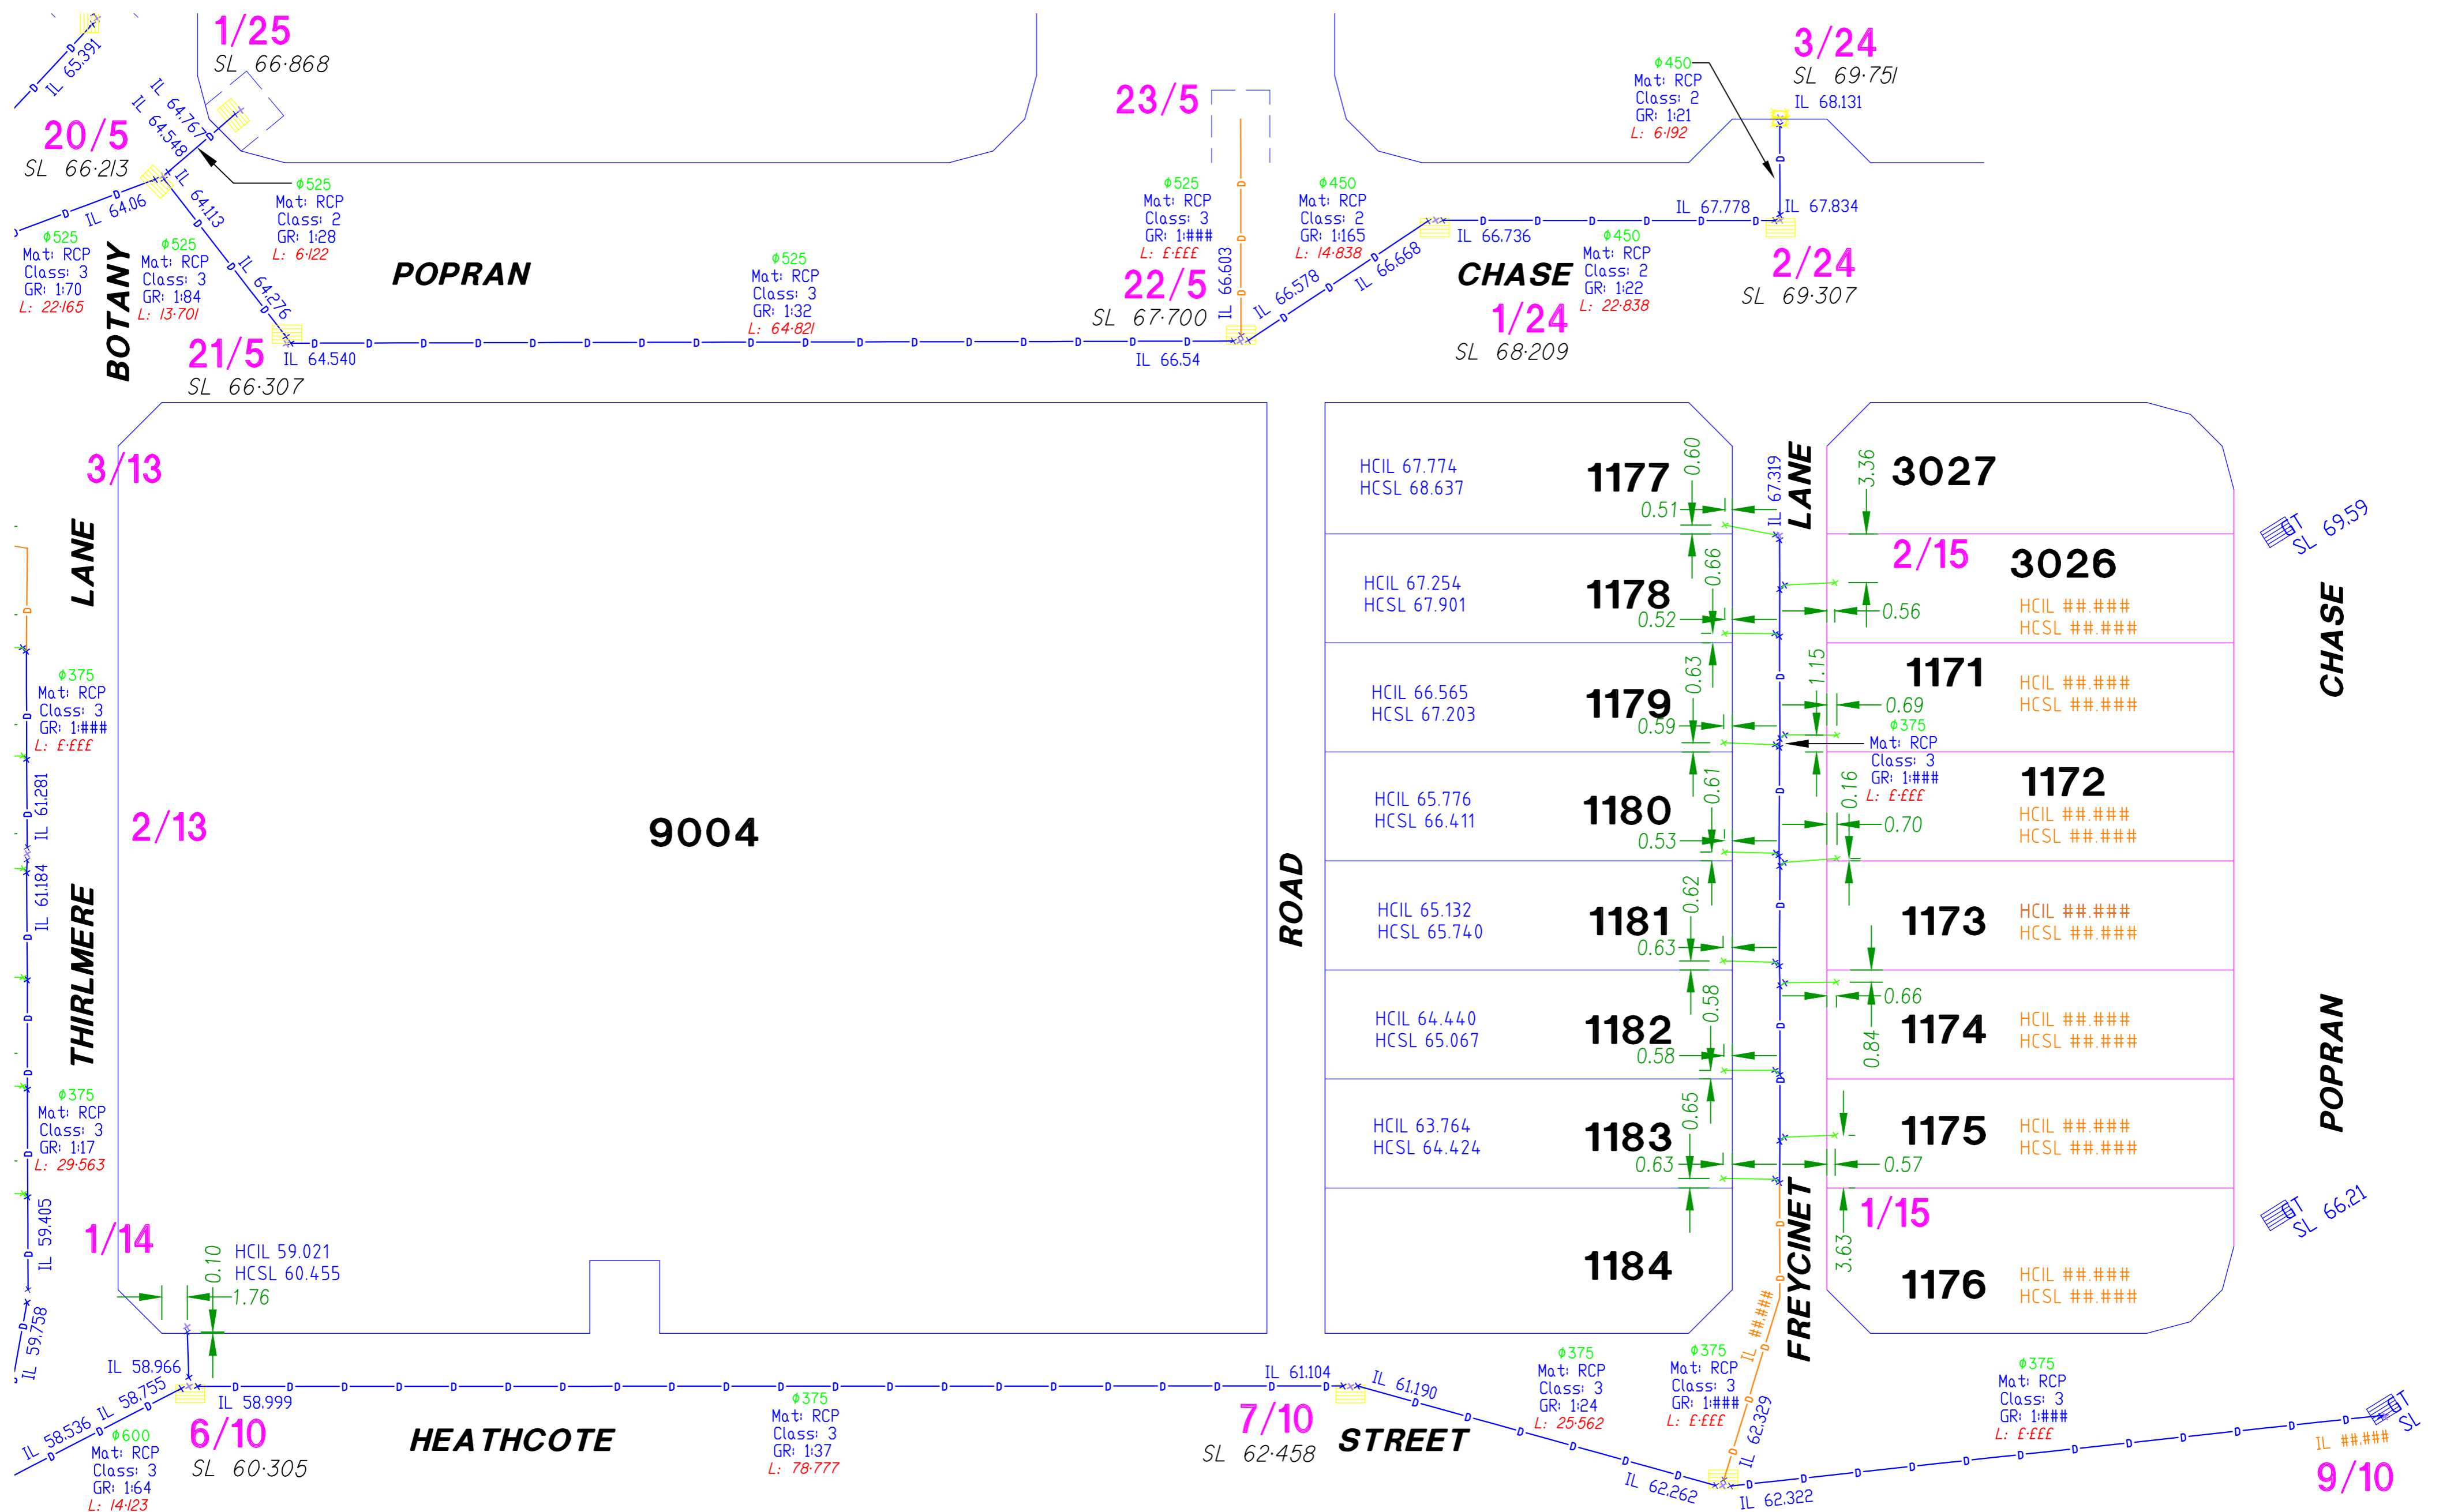


REFER SHEET 2 FOR CONTINUATION

BUILDERS ISSUE

SURVEY DATUM

0 5 10 15 20 25 30 35
Scale of Meters 1:300

Coordinate System: Local Site.
Horizontal Azimuth: GDA94
Vertical Datum: AHD71

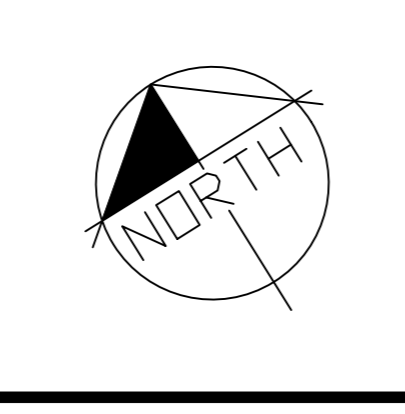

PROJECT Providence, Ripley		CLIENT AMEX CORP. PTY LTD	
LEVEL DATUM AHD	SCALE 1:300 @ A1	AS CONSTRUCTED STORMWATER HOUSE CONNECTIONS STAGE 20 - SHEET 1	
ORIGIN OPM60301 RL 44-315 Barrams Rd Sth Ripley	Date AUGUST 2016 Surveyed RPS Comp by DJL		
FB : TSC3	LB :	DWG 116052S20-21Storm	Parish Local Authority IPSWICH CITY COUNCIL

JOB REF 116052	
-------------------	--

RPS

RPS Australia East Pty Ltd
ACN 140 292 762
ABN 44 140 292 762
180 Brisbane Street
PO Box 341
Ipswich QLD 4305
T +61 7 3437 2000
F +61 7 3434 2099
W rpsgroup.com.au

©COPYRIGHT PROTECTS THIS PLAN
Unauthorised reproduction or amendment
not permitted. Please contact the author.

Reference 116052-	Rev
-----------------------------	-----