












LEGEND


-  Sewer Line
-  Lot Boundary
-  Stage Boundary
-  Valve
-  Water Meter
-  Fire Hydrant
-  Fitting (Tee / End Cap)
-  Bend
-  Tapping Band

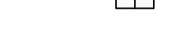

| Issue | Description | Date |
|-------|-------------------------|------------|
| | Original Builders issue | 17/07/2017 |
| | | |
| | | |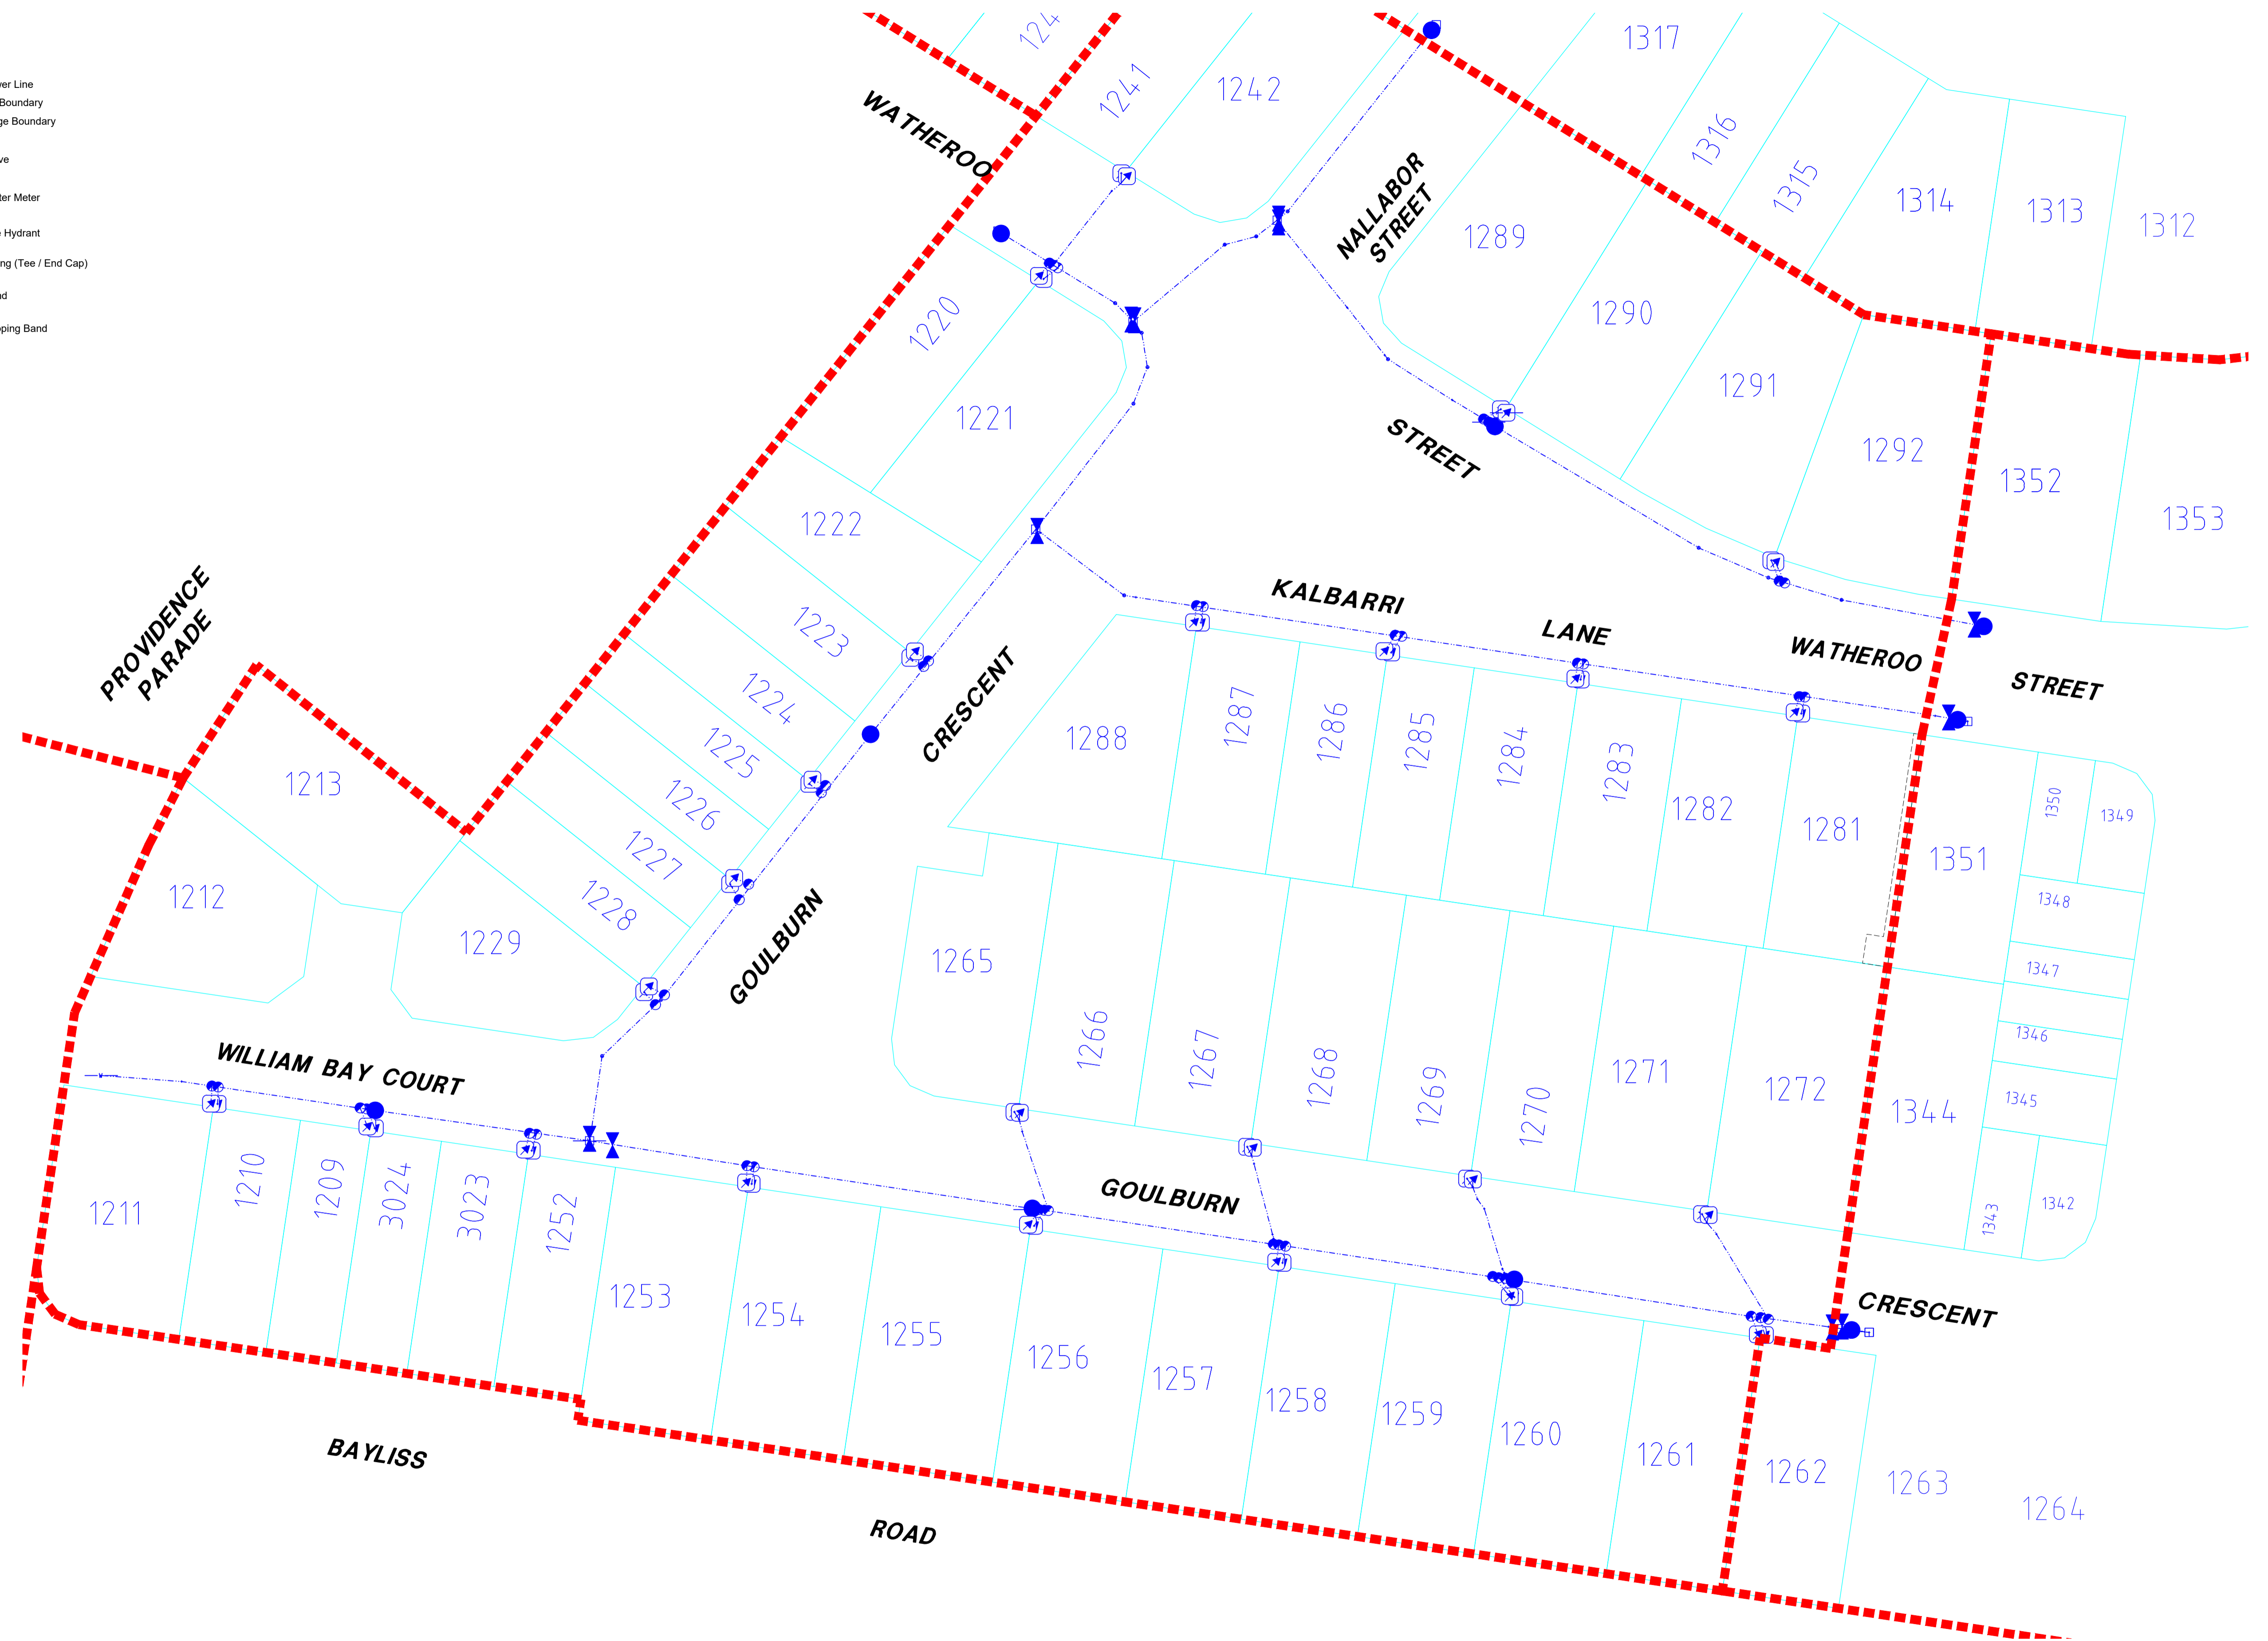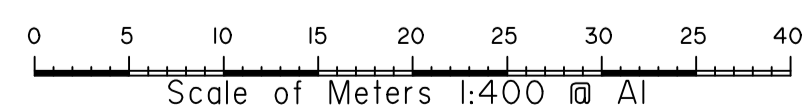
BUILDERS ISSUE

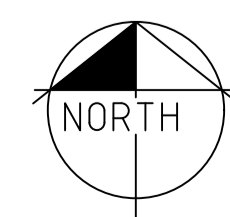

| | |
|--|---------------------------------|
| PROJECT <i>Providence, Ripley</i> | |
| LEVEL DATUM AHD | SCALE 1:400 @ A1 |
| ORIGIN OPM60301 RL 44.315 Barrams Rd Sth Ripley | Date: MAY 2017 Surveyed: RPS |
| FB : TSC3 LB : | Comp by: BR DWG: 116052 |

| | |
|--|-----------|
| CLIENT AMEX CORP. PTY LTD | |
| AS CONSTRUCTED WATER MAINS STAGE 30 | |
| Parish | Job Ref |
| Local Authority IPSWICH CITY COUNCIL | 116052-29 |



©COPYRIGHT PROTECTS THIS PLAN
Unauthorized reproduction or amendment
not permitted. Please contact the author.

RPS Australia East Pty Ltd
ACN 140 292 762
ABN 44 140 292 762
743 Ann Street
PO Box 1559
Fortitude Valley QLD 4006
T +61 7 3237 8899
F +61 7 3237 8833
W rpsgroup.com.au

| | |
|--------------------------------|-----|
| Reference 116052-168 | Rev |
|--------------------------------|-----|