


AS CONSTRUCTED

S.G. LONG & ASSOCIATES PTY LTD
 Engineering Surveyors, hereby
 certify this drawing as a true
 and correct representation
 of the As-constructed Works.

Signature.....*[Signature]*.....

SUNSTATE ENGINEERING SURVEYS

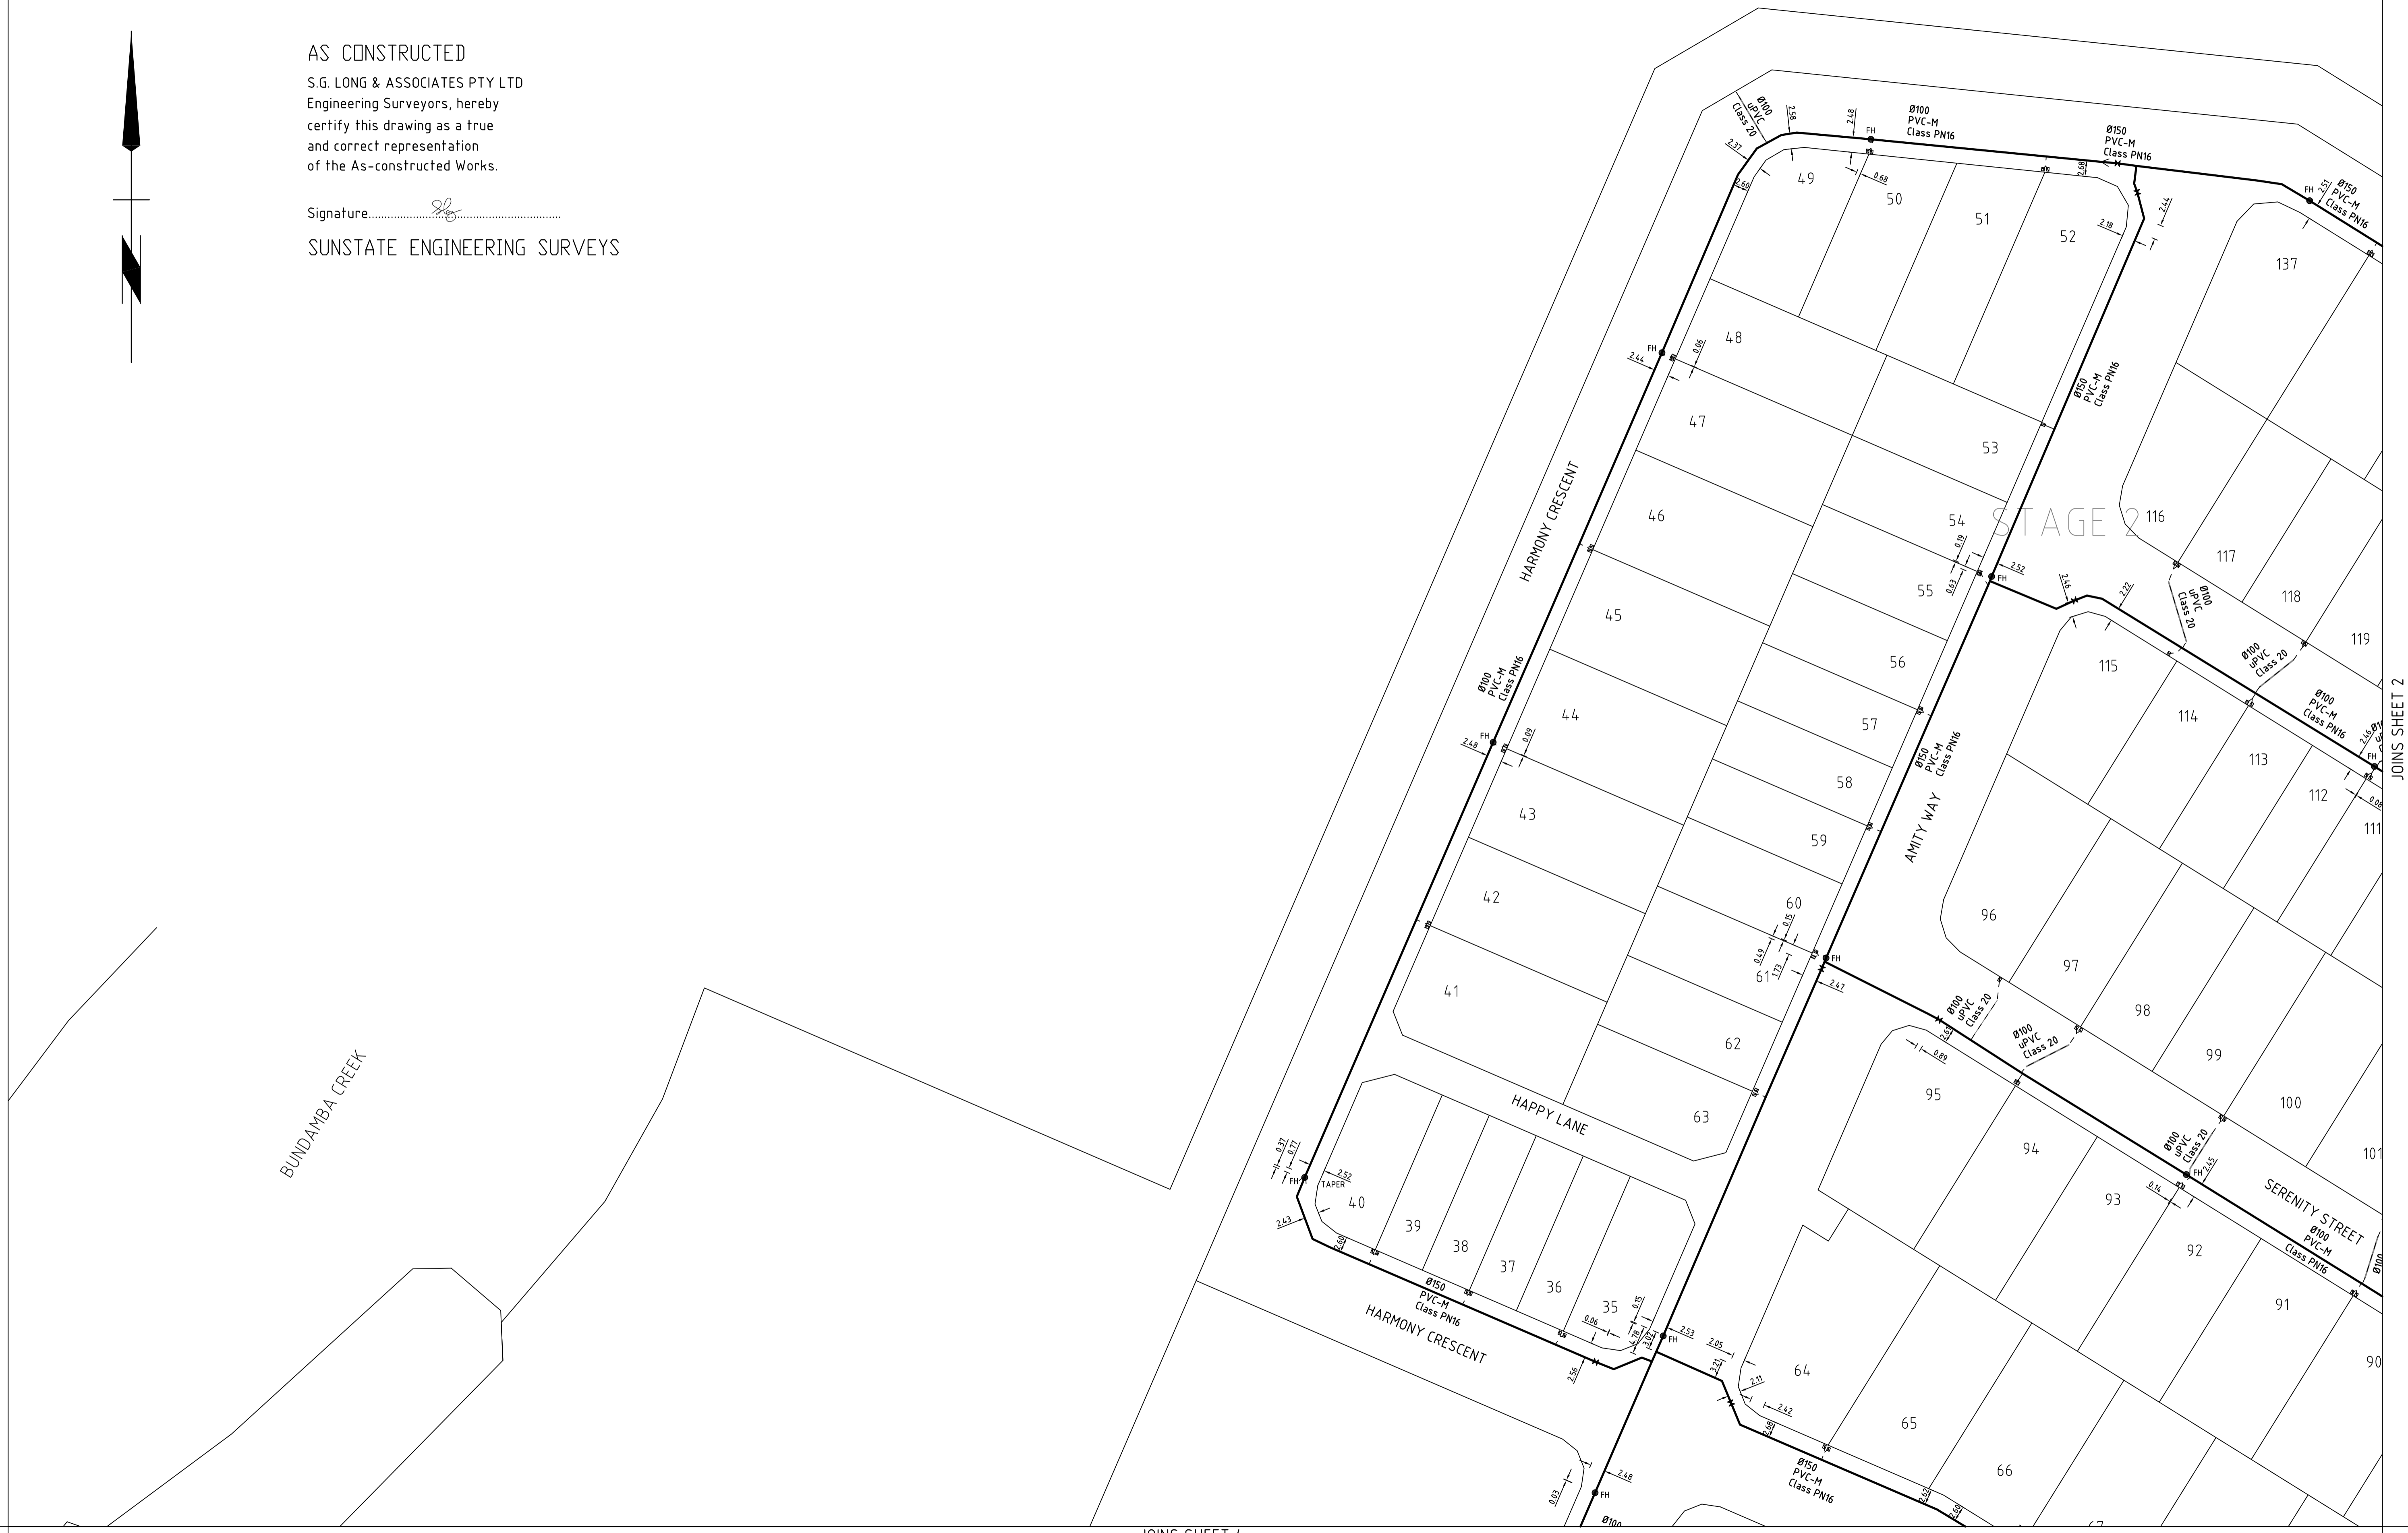


JOINS SHEET 4

JOINS SHEET 2

SUNSTATE ENGINEERING SURVEYS A.B.N. 33 011 008 521 Unit 2/44 Storie Street, CLONTARF, Q. 4019 Phone: (07) 3283 7611 Fax: (07) 3283 7633 Mobile: 0411 171 322 Email: shane@sunstatesurveys.com.au		SURVEYED DK DRAWN GH CHECKED	No. 1 OF 4 SHEETS DATUM: A.H.D.	BMD URBAN 25 Cambridge Parade MANLY, QLD Ph: (07) 3893 7000 Fax: (07) 3893 4088	RIPLEY - SUCE AS-CONSTRUCTED WATER RETICULATION STAGES 1, 2 and 3	DRAWING No. 14020-021 SCALE: 1 : 500 at A1	REV. A
A	10.04.2015	AS-CONSTRUCTED	GH	CADFILE: 14.020-500			

AS CONSTRUCTED
 S.G. LONG & ASSOCIATES PTY LTD
 Engineering Surveyors, hereby
 certify this drawing as a true
 and correct representation
 of the As-constructed Works.

Signature.....
 SUNSTATE ENGINEERING SURVEYS

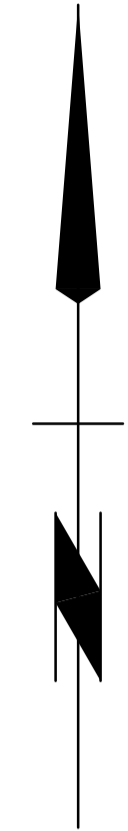

JOINS SHEET 1

JOINS SHEET 3

SUNSTATE ENGINEERING SURVEYS A.B.N. 33 011 008 521 Unit 2/44 Storie Street, CLONTARF, Q. 4019 Phone: (07) 3283 7611 Fax: (07) 3283 7633 Mobile: 0411 171 322 Email: shane@sunstatesurveys.com.au		SURVEYED DK DRAWN GH CHECKED	No. 2 OF 4 SHEETS DATUM: A.H.D.	BMD URBAN 25 Cambridge Parade MANLY, QLD Ph: (07) 3893 7000 Fax: (07) 3893 4088	RIPLEY - SUCE AS-CONSTRUCTED WATER RETICULATION STAGES 1, 2 and 3	DRAWING No. 14020-021 SCALE: 1 : 500 at A1	REV. A
A	14.04.2015	AS-CONSTRUCTED	GH	CADFILE: 14.020-500			





AS CONSTRUCTED
 S.G. LONG & ASSOCIATES PTY LTD
 Engineering Surveyors, hereby
 certify this drawing as a true
 and correct representation
 of the As-constructed Works.

Signature.....
 SUNSTATE ENGINEERING SURVEYS

JOINS SHEET 4

SUNSTATE ENGINEERING SURVEYS A.B.N. 33 011 008 521 Unit 2/44 Storie Street, CLONTARF, Q. 4019 Phone: (07) 3283 7611 Fax: (07) 3283 7633 Mobile: 0411 171 322 Email: shane@sunstatesurveys.com.au		SURVEYED DK DRAWN GH CHECKED	No. 3 OF 4 SHEETS DATUM: A.H.D.	BMD URBAN 25 Cambridge Parade MANLY, QLD Ph: (07) 3893 7000 Fax: (07) 3893 4088	RIPLEY - SUCE AS-CONSTRUCTED WATER RETICULATION STAGES 1, 2 and 3	DRAWING No. 14020-021 SCALE: 1 : 500 at A1	REV. A
A	27.03.2015	AS-CONSTRUCTED	GH	CADFILE: 14020-500			

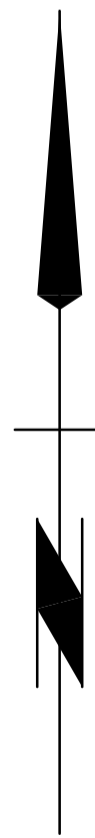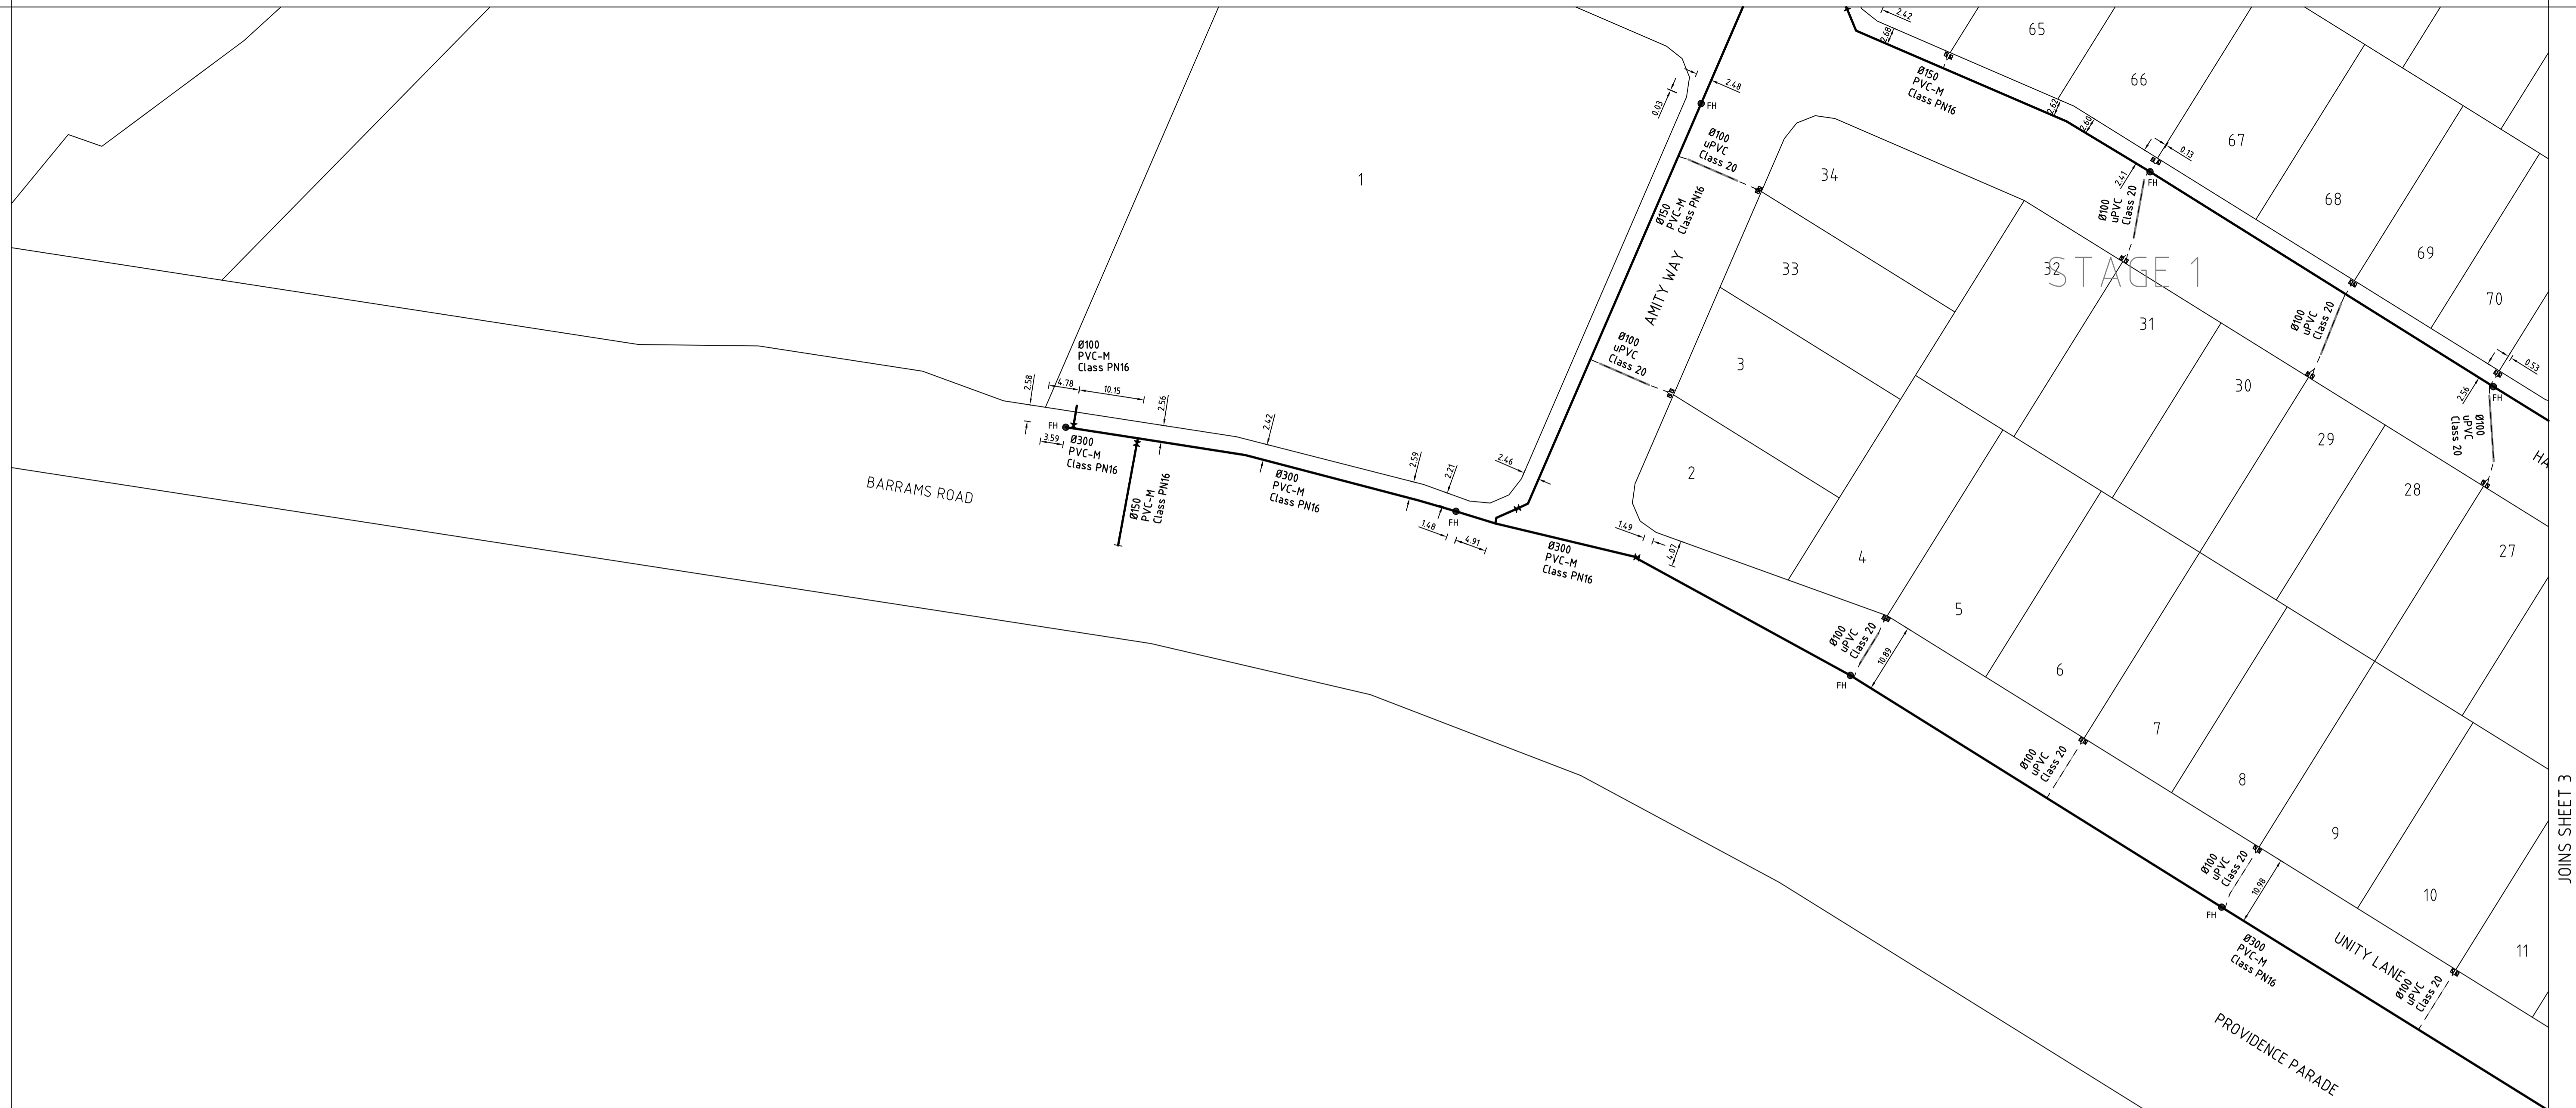

AS CONSTRUCTED
 S.G. LONG & ASSOCIATES PTY LTD
 Engineering Surveyors, hereby
 certify this drawing as a true
 and correct representation
 of the As-constructed Works.

Signature.....*SL*.....

SUNSTATE ENGINEERING SURVEYS

SUNSTATE ENGINEERING SURVEYS		A.B.N. 33 011 008 521	
Unit 2/44 Storie Street, CLONTARF, Q. 4019		Phone: (07) 3283 7611 Fax: (07) 3283 7633 Mobile: 0411 171 322	
Email: shane@sunstatesurveys.com.au		CADFILE: 14.020-500	
A	10.04.2015	AS-CONSTRUCTED	GH

SURVEYED	DK	No. 4 OF
DRAWN	GH	4 SHEETS
CHECKED		DATUM: A.H.D.

BMD URBAN
 25 Cambridge Parade
 MANLY, QLD
 Ph: (07) 3893 7000
 Fax: (07) 3893 4088

RIPLEY - SUCE
 AS-CONSTRUCTED
 WATER RETICULATION
 STAGES 1, 2 and 3

DRAWING No.	REV.
14020-021	A
SCALE: 1 : 500 at A1	