


LEGEND

- House Connection
- Sewer Line
- Lot Boundary
- Stage Boundary
- Manhole / Maintenance Structure

ABBREVIATIONS - House Connection

- CH Chainage of Obtuse Bend (Distance from Downstream Invert Level)
- SL Surveyed Surface Level (at House Connection)
- LGTH House Connection Length (Horizontal Length)
- IL Invert Level of House Connection
- OS Offset of house Connection IL from line
- IO Distance along pipe from inspection opening to Downstream IL

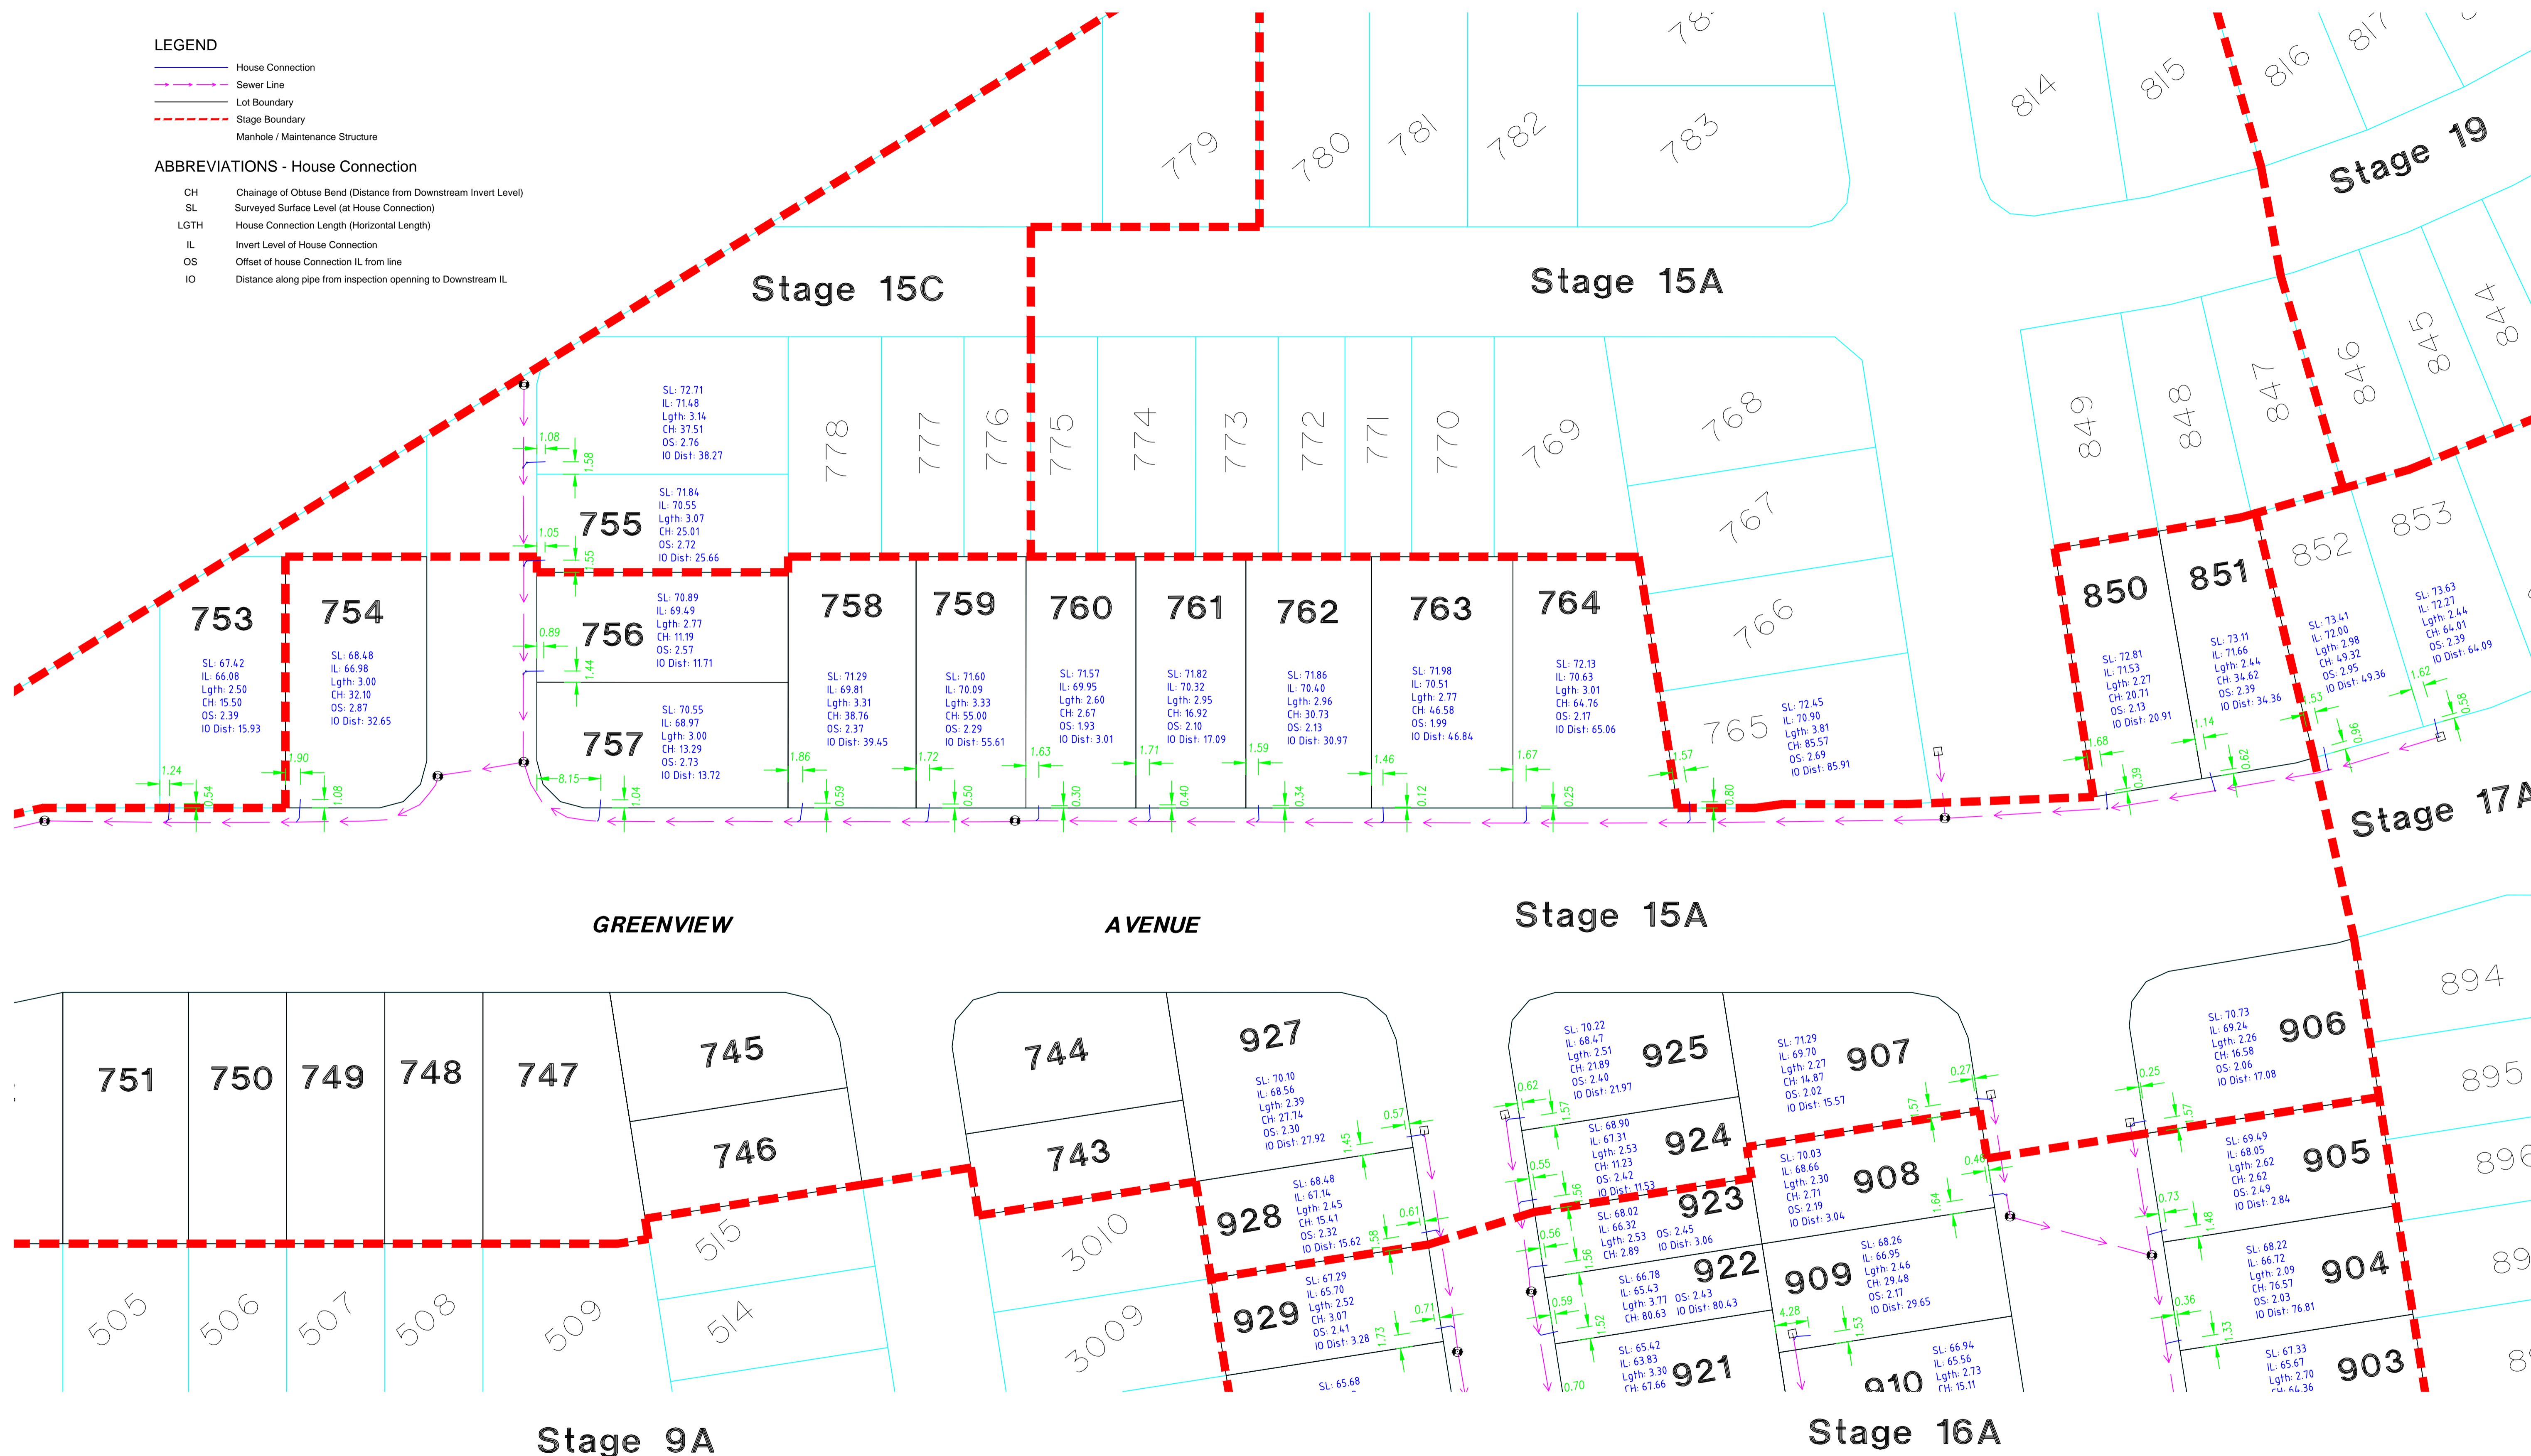

Stage 9A

Stage 15A


Stage 16A

Stage 17A

Stage 19

GREENVIEW

AVENUE

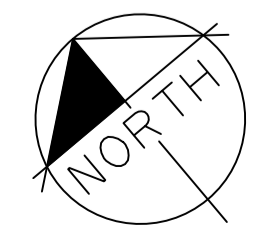

BUILDERS ISSUE

PROJECT <i>Providence, Ripley</i>	
LEVEL DATUM AHD	SCALE 1:400 @ A1
ORIGIN OPM60301 RL 44-315 Barrams Rd Sth Ripley	Date DECEMBER 2016
FB : TSC3 LB :	Surveyed RPS
DWG I16052 Sewer House	Comp by BR

CLIENT AMEX CORP. PTY LTD	
AS CONSTRUCTED	
SEWER RETICULATION MAIN	
STAGE 15A	
Parish	Job Ref
Local Authority IPSWICH CITY COUNCIL	I16052-14

RPS Australia East Pty Ltd
ACN 140 292 762
ABN 44 140 292 762
180 Brisbane Street
PO Box 341
Ipswich QLD 4305
T +61 7 3437 2000
F +61 7 3434 2099
W rpsgroup.com.au

© COPYRIGHT PROTECTS THIS PLAN
Unauthorized reproduction or amendment
not permitted. Please contact the author.

Reference 116052-111	Rev
--------------------------------	-----