
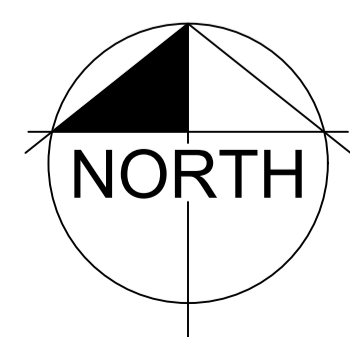


LEGEND
 — Stormwater Line
 — Lot Boundary
 - - - Stage Boundary
 ● Manhole

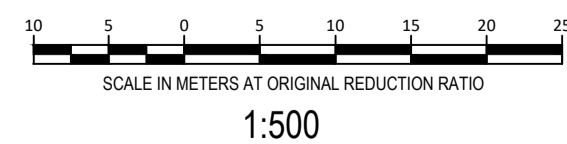

PROJECT Providence, Ripley	
LEVEL DATUM	SCALE 1:500 @ A1
ORIGIN	Date: MAY 2018 Surveyed: RPS Comp by: RPS
FB :	LB : DWG: 116052-42 Stormwater

CLIENT AMEX CORP. PTY LTD	
AS CONSTRUCTED STORMWATER RETICULATION STAGE BUILT TO DATE	
Parish	Job Ref
Local Authority: IPSWICH CITY COUNCIL	116052-44

RPS Australia East Pty Ltd
 ACN 140 292 762
 ABN 44 140 292 762
 180 Brisbane Street
 PO Box 341
 Ipswich QLD 4305
 T +61 7 3437 2000
 F +61 7 3434 2099
 W rpsgroup.com.au

©COPYRIGHT PROTECTS THIS PLAN. Unauthorised reproduction or amendment not permitted. Please contact the author.

Reference 116052-239	Rev
--------------------------------	-----