


**LEGEND**


Sewer Line  
 Lot Boundary  
 Stage Boundary  
 Manhole / Maintenance Structure

**ABBREVIATIONS - Sewer Main**

Mat Material  
 DSIL Down stream invert level  
 USIL Up stream invert level  
 SL Surface level  
 L Length of pipe from Manhole to Mahole

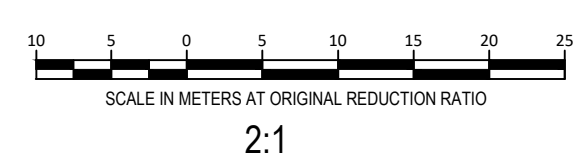

**FINAL ISSUE**

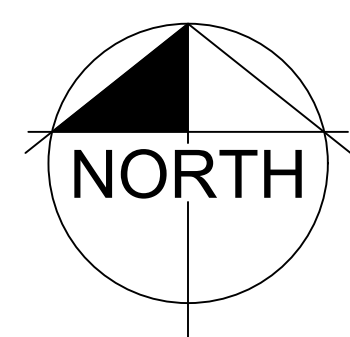

PROJECT <b>Providence, Ripley</b>	
LEVEL DATUM AHD	SCALE <b>1:500 @ A1</b>
ORIGIN	Date: SEPTEMBER 2018
	Surveyed: RPS
	Comp by: RPS
FB :	DWG. 116052S33Sewer

CLIENT <b>AMEX CORP. PTY LTD</b>	
<b>AS CONSTRUCTED SEWER RETICULATION STAGE 33</b>	
Parish	Job Ref
Local Authority IPSWICH CITY COUNCIL	116052

**RPS**

RPS Australia East Pty Ltd  
 ACN 140 292 762  
 ABN 44 140 292 762  
 180 Brisbane Street  
 Ipswich QLD 4305  
 T +61 7 3437 2000  
 F +61 7 3434 2099  
 W rpsgroup.com.au

Reference **116052** Rev