

ENGINEER'S CERTIFICATION



I, **Willie Maherbe**, hereby certify that:
 1. The information contained in this drawing / document is in compliance with approved drawings and design.
 2. The new water and sewerage works defined by this drawing have been designed and constructed in accordance with the SEQ Code.
 3. This represents an accurate record of as-constructed works.
 4. I accept responsibility for the information contained in this drawing / document.

RPEQ (signature) RPEQ No. **8112** Date:

REGISTERED SURVEYOR'S CERTIFICATION


We RPS Australia East Pty Ltd, Registered Surveyor - Land hereby certify that the Levels and Dimensions shown hereon are a correct record of our survey which was performed in accordance with Council Accuracy Standards.

26 Feb 2019
 Authorised Delegate Date

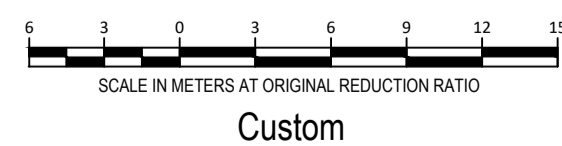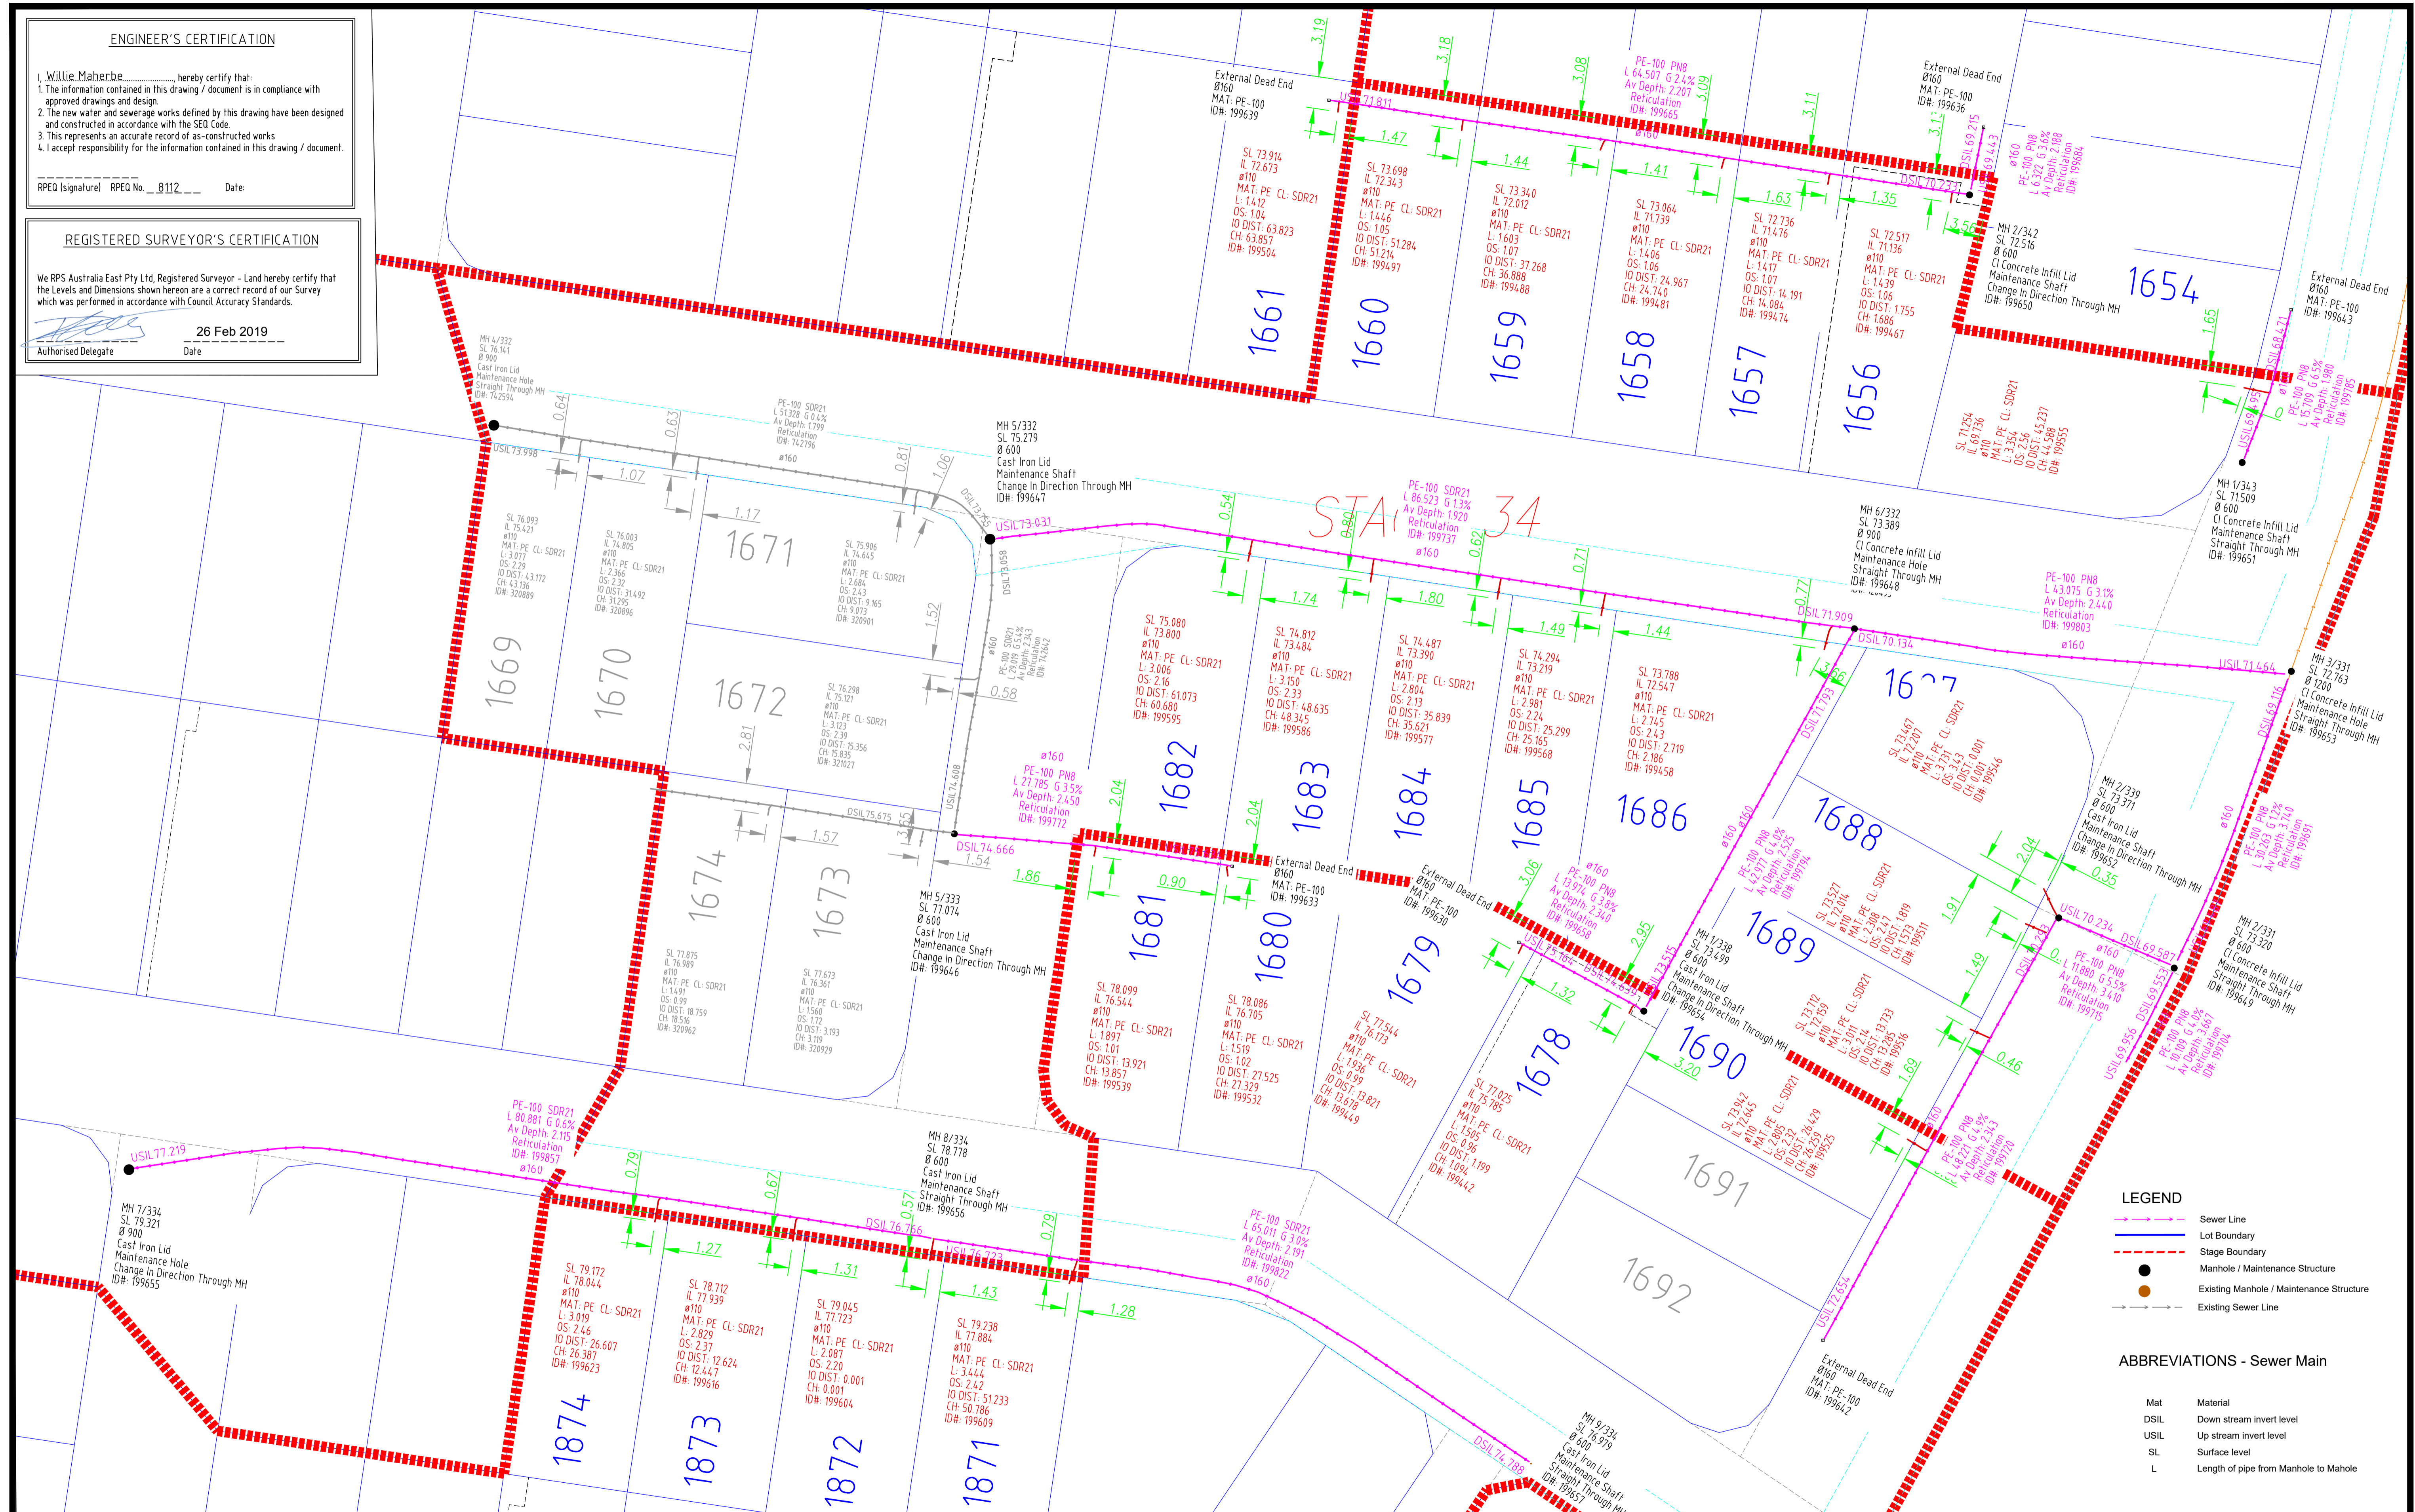

FINAL ISSUE

| Issue | Description | Date |
|-------|---------------------------------|------------|
| A | Preliminary sewer built to date | 05/09/2018 |
| B | Sewer HC Lot 1655 updated | 19/11/2018 |
| C | Surface levels added | 19/01/2019 |
| D | Ascon for review | 31/01/2019 |
| E | Ascon amended | 05/02/2019 |
| F | 6/332 & 3/331 ILS amended | 07/02/2019 |
| G | Missing line added | 08/02/2019 |
| H | Final ascon issue | 15/02/2019 |

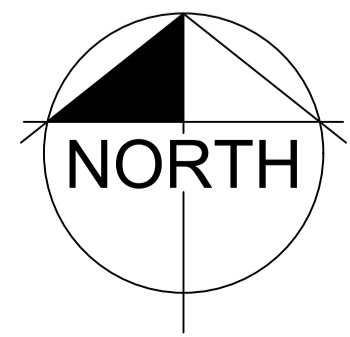

| | |
|--------------------------------------|--|
| PROJECT Providence, Ripley | |
| LEVEL DATUM AHD | SCALE 1:300 @ A1 |
| ORIGIN | Date: FEBRUARY 2019 |
| | Surveyed: RPS |
| | Comp by: RPS |
| FB : | LB : |
| DWG: 116052s34Sewer | Parish: Local Authority IPSWICH CITY COUNCIL |

| | |
|---|--------|
| CLIENT AMEX CORP. PTY LTD | |
| AS CONSTRUCTED SEWER RETICULATION STAGE 34 | |
| Job Ref: 116052 | Rev: H |

RPS
 RPS Australia East Pty Ltd
 ACN 140 252 762
 ABN 14 140 252 762
 180 Brisbane Street
 PO Box 341
 Ipswich QLD 4305
 T +61 7 3437 2000
 F +61 7 3434 2099
 W rpsgroup.com.au

Reference **116052** Rev H