

- LEGEND**
- Sewer Line
 - Lot Boundary
 - Stage Boundary
 - Manhole / Maintenance Structure
 - Existing Manhole / Maintenance Structure
 - Existing Sewer Line

- ABBREVIATIONS - Sewer Main**
- Mat Material
 - DSIL Down stream invert level
 - USIL Up stream invert level
 - SL Surface level
 - L Length of pipe from Manhole to Mahole

ENGINEER'S CERTIFICATION


I, Willie Maherbe, hereby certify that:
 1. The information contained in this drawing / document is in compliance with approved drawings and design.
 2. The new water and sewerage works defined by this drawing have been designed and constructed in accordance with the SEQ Code.
 3. This represents an accurate record of as-constructed works
 4. I accept responsibility for the information contained in this drawing / document.

RPEQ (signature) RPEQ No. 8112 Date: _____


REGISTERED SURVEYOR'S CERTIFICATION

We RPS Australia East Pty Ltd, Registered Surveyor - Land hereby certify that the Levels and Dimensions shown hereon are a correct record of our Survey which was performed in accordance with Council Accuracy Standards.

Authorised Delegate Date: _____

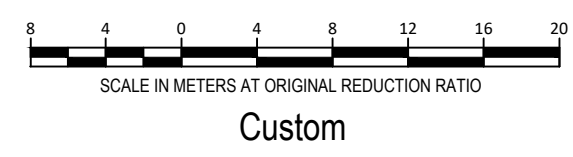

Issue	Description	Date
A	Preliminary sewer built to date	05/09/2018
B	Preliminary sewer built to date	17/09/2018
C	Preliminary sewer built to date	09/10/2018
D	Preliminary sewer built to date	23/11/2018
E	Preliminary sewer built to date	15/02/2019

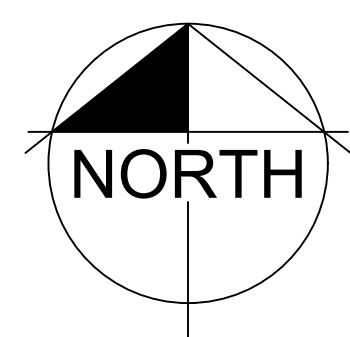

PROJECT Providence, Ripley	
LEVEL DATUM AHD	SCALE 1:400 @ A1
ORIGIN	Date, FEBRUARY 2019
	Surveyed, RPS
	Comp by, RPS
FB :	DWG. 116052s35Sewer
LB :	

CLIENT AMEX CORP. PTY LTD	
AS CONSTRUCTED SEWER RETICULATION STAGE 35	
Parish	Job Ref
Local Authority IPSWICH CITY COUNCIL	116052

RPS Australia East Pty Ltd
 ACN 140 292 762
 ABN 44 140 292 762
 180 Brisbane Street
 Ipswich QLD 4305
 T +61 7 3437 2000
 F +61 7 3434 2099
 W rpsgroup.com.au

Reference **116052** Rev E