

ENGINEER'S CERTIFICATION

I, Willie Maherbe, hereby certify that:


- The information contained in this drawing / document is in compliance with approved drawings and design.
- The new water and sewerage works defined by this drawing have been designed and constructed in accordance with the SEQ Code.
- This represents an accurate record of as-constructed works
- I accept responsibility for the information contained in this drawing / document.

RPEQ (signature) RPEQ No. 8112 Date: _____


REGISTERED SURVEYOR'S CERTIFICATION

We RPS Australia East Pty Ltd, Registered Surveyor - Land hereby certify that the Levels and Dimensions shown hereon are a correct record of our Survey which was performed in accordance with Council Accuracy Standards.

Authorised Delegate _____ Date _____

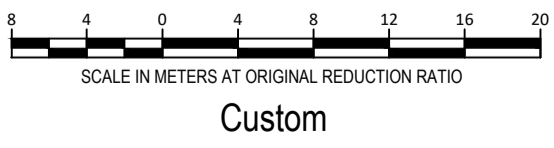

Issue	Description	Date
A	Preliminary stormwater built to date	05/09/2018
B	Preliminary stormwater built to date	17/09/2018
C	Preliminary stormwater built to date	09/10/2018
D	Preliminary stormwater built to date	15/02/2019

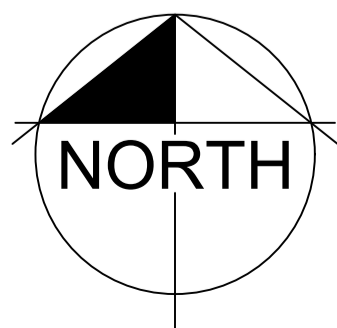

PROJECT <i>Providence, Ripley</i>	
LEVEL DATUM AHD	SCALE 1:400 @ A1
ORIGIN	Date: FEBRUARY 2019
	Surveyed: RPS
	Comp by: RPS
FB :	DWG. 11605235Stormwater
LB :	

CLIENT AMEX CORP. PTY LTD	
AS CONSTRUCTED STORMWATER RETICULATION STAGE 35	
Parish	Job Ref
Local Authority: IPSWICH CITY COUNCIL	116052

RPS Australia East Pty Ltd
ACN 140 292 762
ABN 44 140 292 762
160 Brisbane Street
PO Box 341
Ipswich QLD 4305
T +61 7 3437 2000
F +61 7 3434 2099
W rpsgroup.com.au

Reference **116052** Rev **D**