


PAGE 41C

STAGE 40

AS CONSTRUCTED

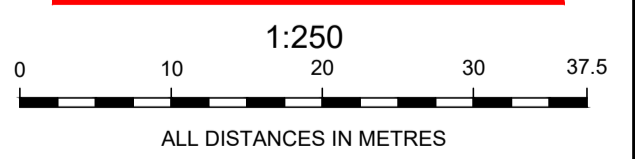

ENGINEER'S CERTIFICATION

I, Willie Maherbe, hereby certify that:

- The information contained in this drawing / document is in compliance with approved drawings and design.
- The new water and sewerage works defined by this drawing have been designed and constructed in accordance with the SEQ Code.
- This represents an accurate record of as-constructed works
- I accept responsibility for the information contained in this drawing / document.

RPEQ (signature) RPEQ No. 8112 Date: _____

REGISTERED SURVEYOR'S CERTIFICATION

We RPS Australia East Pty Ltd, Registered Surveyor - Land hereby certify that the Levels and Dimensions shown hereon are a correct record of our Survey which was performed in accordance with Council Accuracy Standards.

Authorised Delegate Date: _____

A1									
	B	18/04/2019	Stormwater for review	JG	RPS	RPS	RPS	RPS	RPS
A	29/03/2019	Preliminary stormwater surveyed to date	JG	RPS	RPS	RPS	RPS	RPS	RPS
INDEX	DATE	REVISIONS	DRAWN	CHECKED	PASSED	INITIALS	DATE	PASSED	DATE

RPS Australia Asia Pacific 180 Brisbane Street Ipswich QLD 4305 (07) 3437 2000 www.rpsgroup.com.au	RPS	<p style="font-size: 8px;">NORTH</p>	
---	-----	--------------------------------------	--

Ipswich City Council	SCALE 1:250
PROVIDENCE RIPLEY STORMWATER RETICULATION STAGE 40	SHEET 1 OF 1 DRAWING NO. 116052