
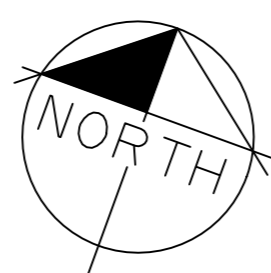


**SURVEY DATUM**  
 Coordinate System: Local Site.  
 Horizontal Azimuth: GDA94  
 Vertical Datum: AHD71

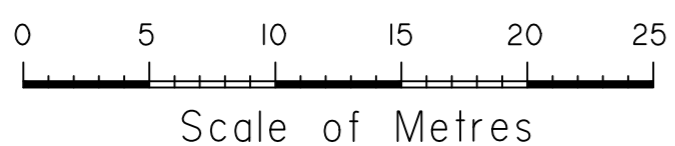

**BUILDERS ISSUE**

<b>PROJECT</b> Providence, Ripley		<b>CLIENT</b> AMEX CORP. PTY LTD	
<b>LEVEL DATUM</b> AHD	<b>SCALE</b> 1:300 @ A1	<b>AS CONSTRUCTED</b> <b>SEWER HOUSE CONNECTIONS</b> <b>STAGE 14</b>	
<b>ORIGIN</b> OPM60301 RL 44-315 Barrams Rd Sth Ripley	Date NOV 2015 Surveyed RPS Comp by JG DWG I1605254-13SewerHC		
<b>FB : TSC3</b>	<b>LB :</b>	<b>Parish</b> Local Authority	<b>Job Ref</b> I16052

<b>Parish</b> Local Authority	<b>Job Ref</b> I16052
----------------------------------	--------------------------

**RPS**  
 RPS Australia East Pty Ltd  
 ACN 140 292 762  
 ABN 44 140 292 762  
 180 Brisbane Street  
 PO Box 341  
 Ipswich QLD 4305  
 T +61 7 3437 2000  
 F +61 7 3434 2099  
 W rpsgroup.com.au

Reference **116052-76** Rev