


SURVEY DATUM

Coordinate System: MGA94 coordinates

Vertical Datum: Australian Height Datum (AHD71)



Scale of Metres

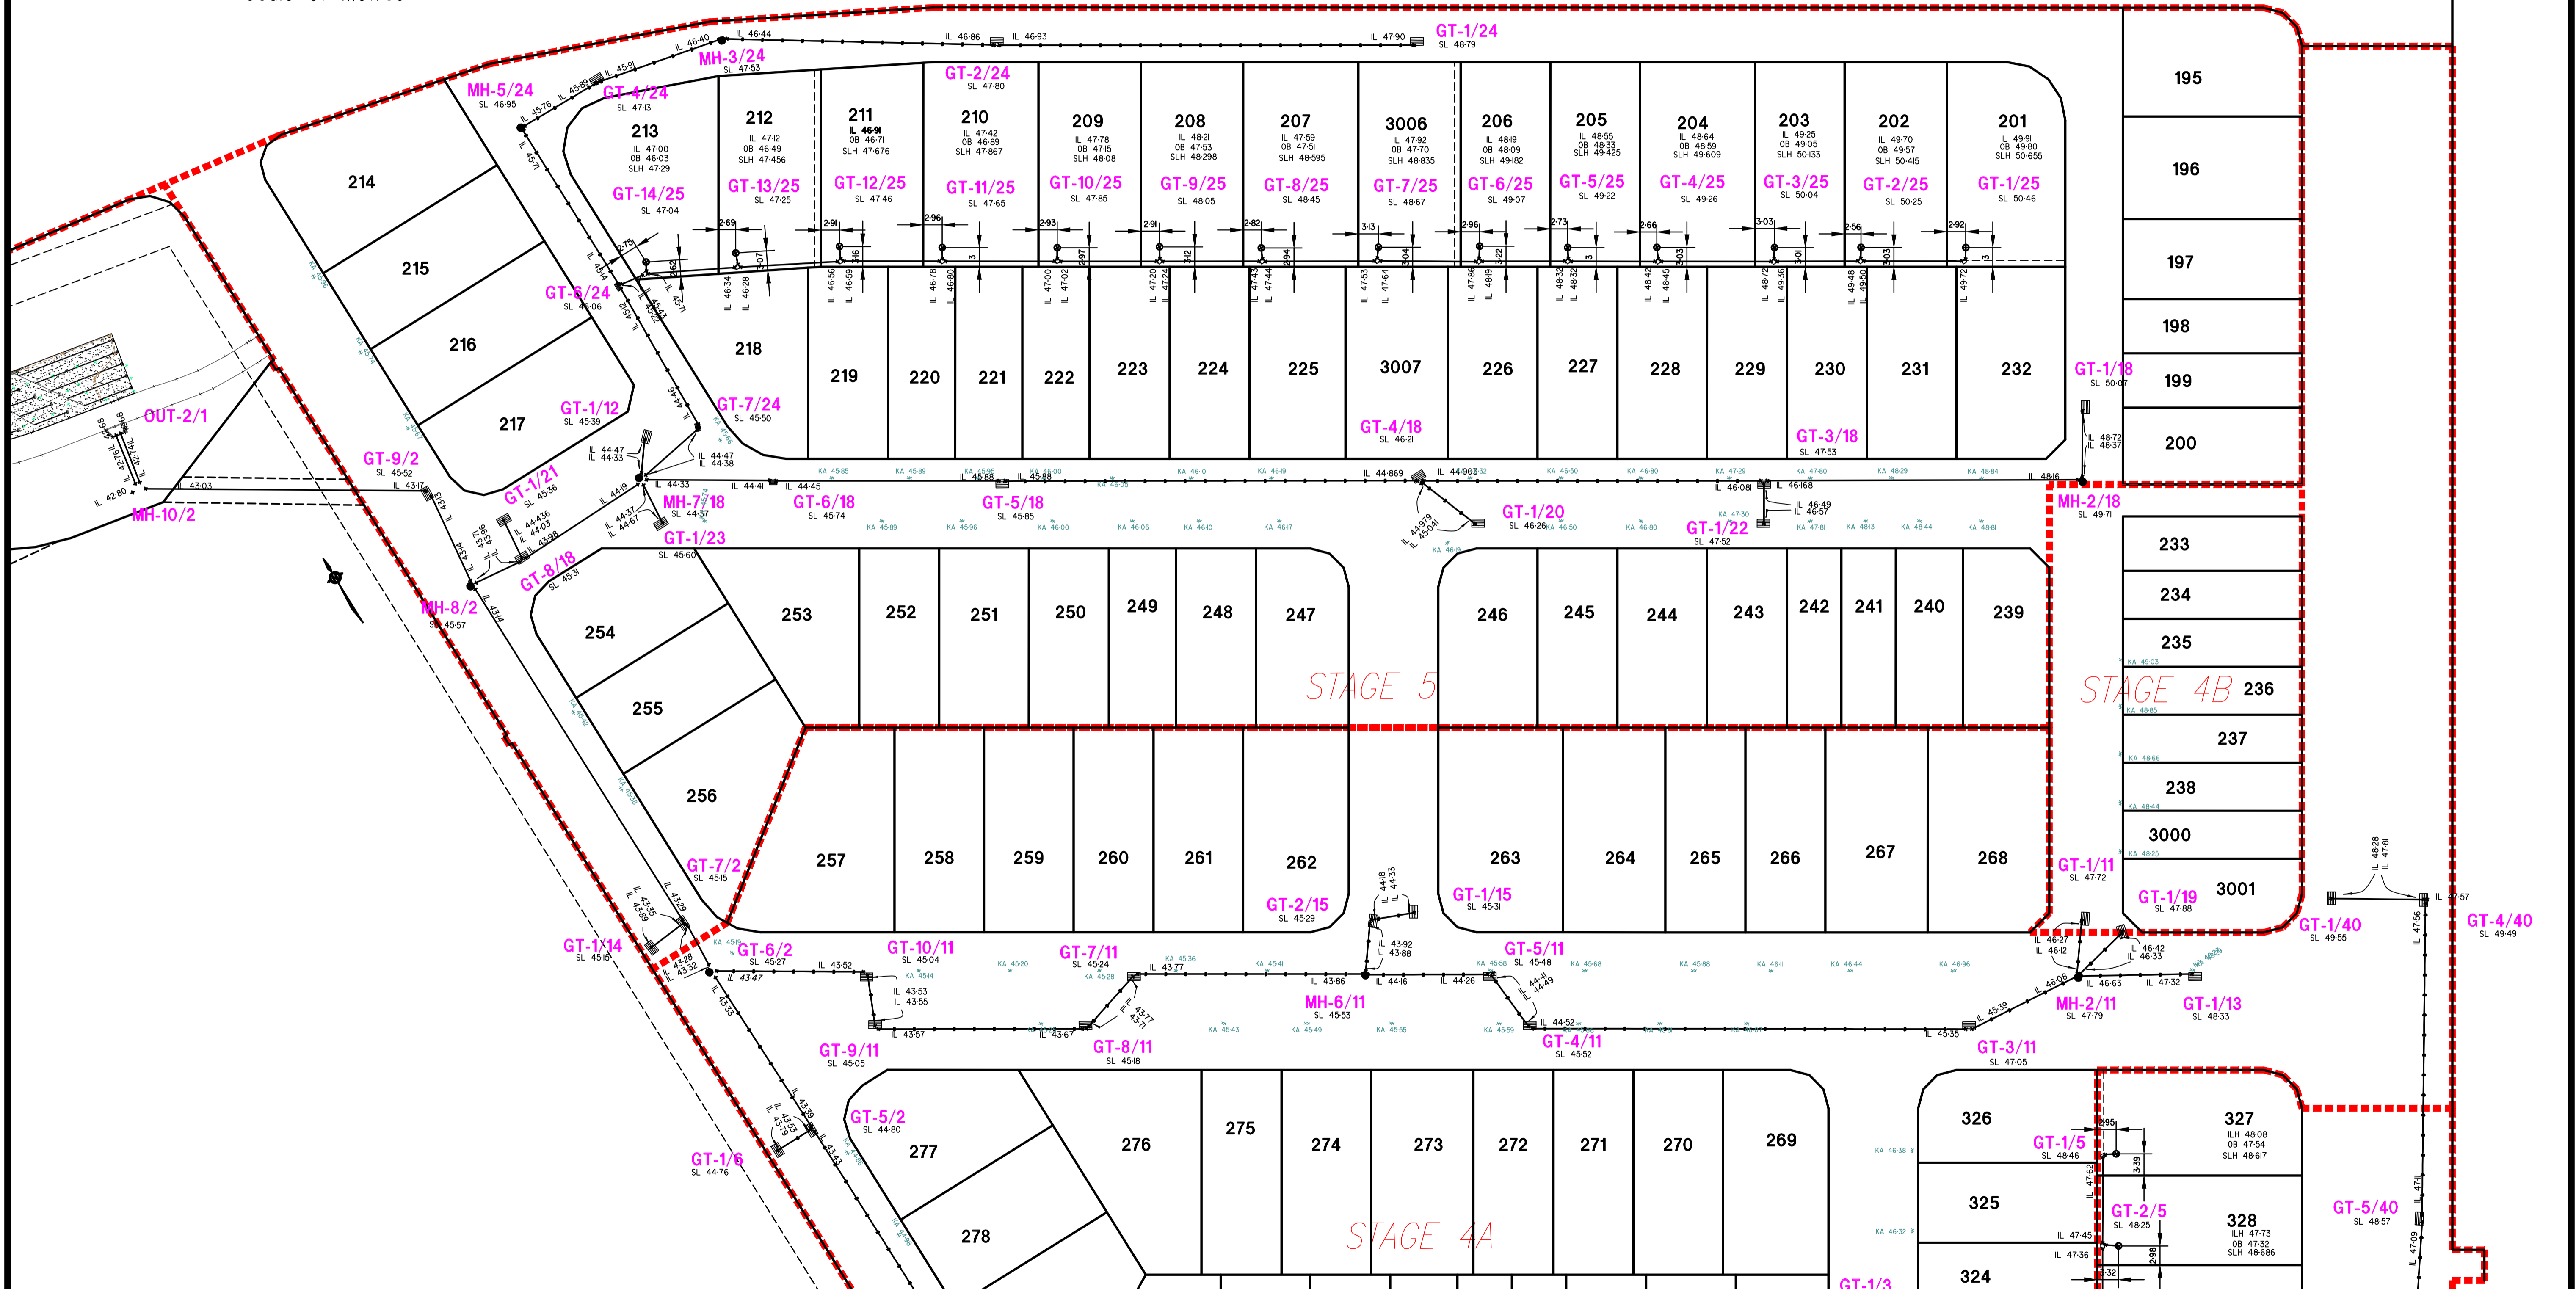

BUILDERS ISSUE

PROJECT Providence, Ripley		CLIENT AMEX CORP. PTY LTD	
LEVEL DATUM AHD	SCALE 1:500 @ A1	AS CONSTRUCTED STORM WATER RETICULATION STAGE 5	
ORIGIN OPM60301 RL 44.315 Barrams Rd Sth Ripley	Date SEPT 2015 Surveyed RPS Comp by BR		
FB: TSC3	LB:	DWG 116052S5 Storm	Local Authority IPSWICH CITY COUNCIL
Job Ref 116052		Reference 116052-63	

RPS
RPS Australia East Pty Ltd
ACN 140 292 762
ABN 44 140 292 762
180 Brisbane Street
PO Box 341
Ipswich QLD 4305
T +61 7 3437 2000
F +61 7 3434 2099
w rpsgroup.com.au

Rev