
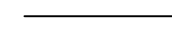







**LEGEND**

-  Stormwater Line
-  Lot Boundary
-  Stage Boundary
-  Manhole



**BUILDERS ISSUE**

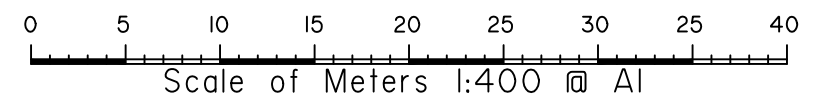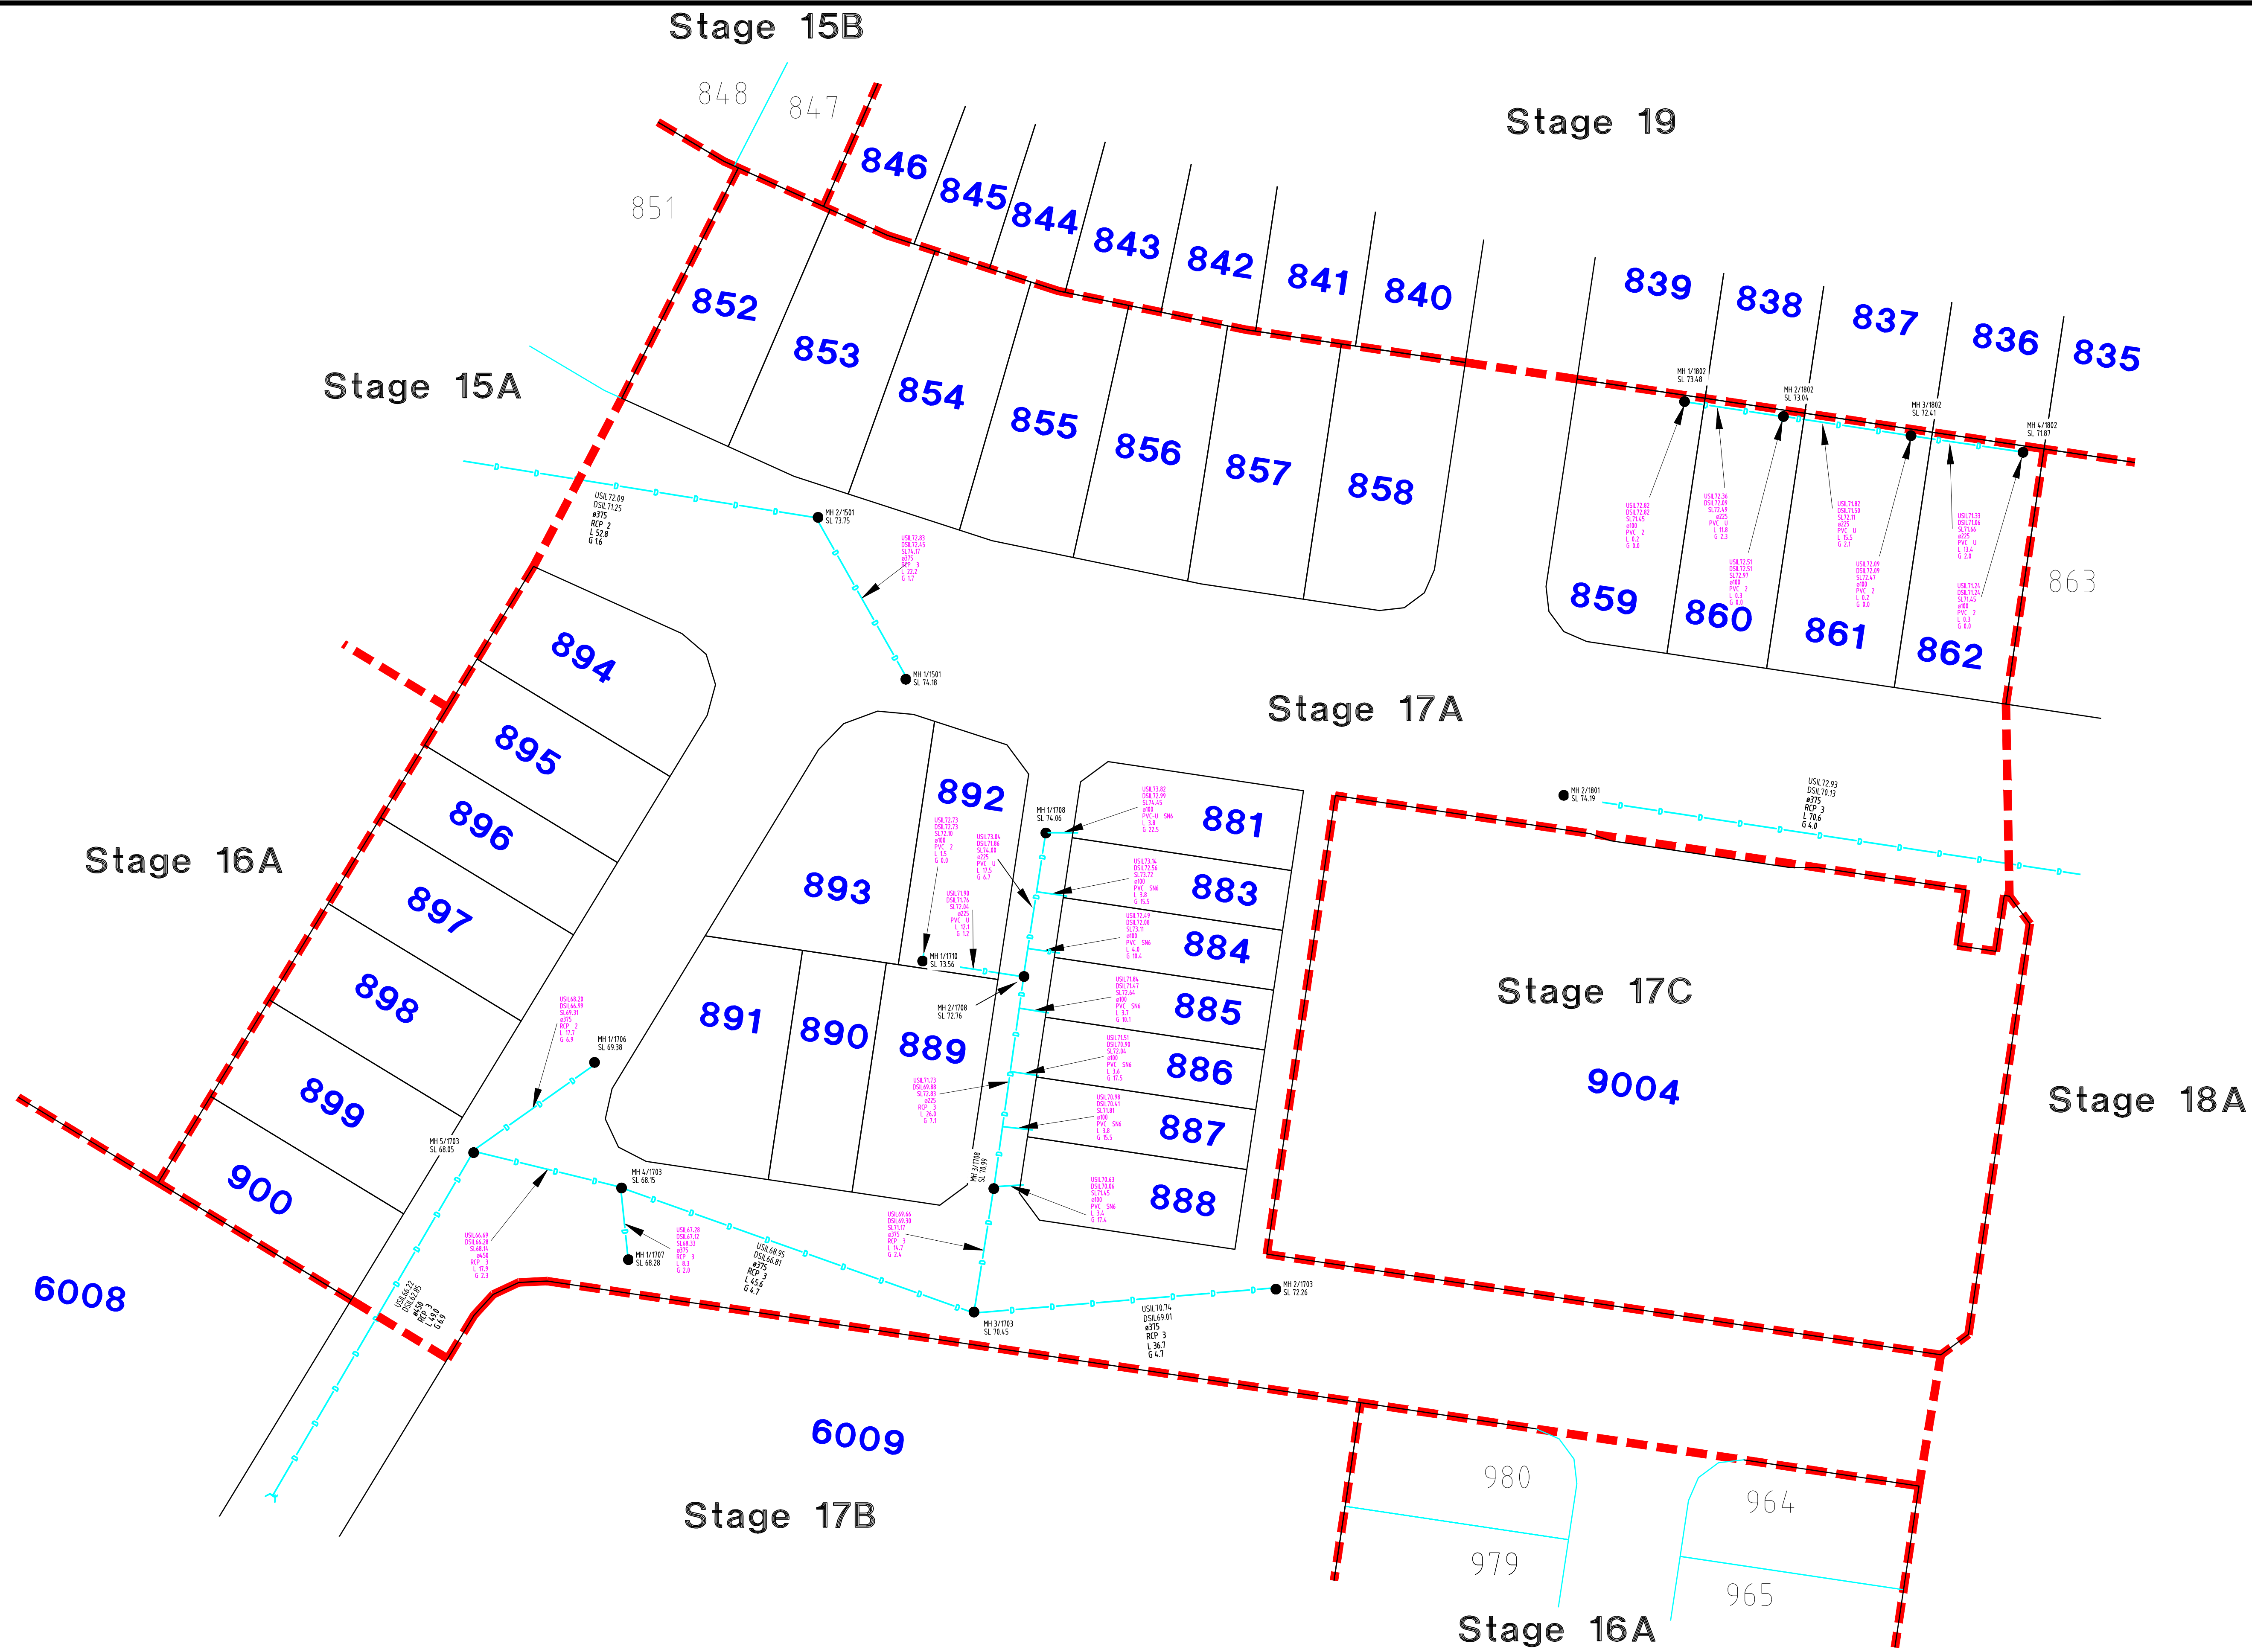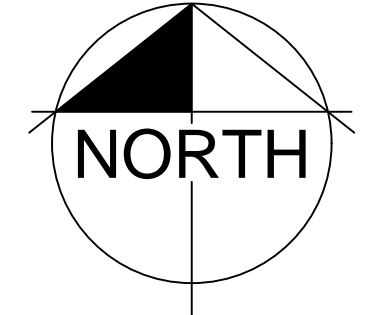

PROJECT <b>Providence, Ripley</b>	
LEVEL DATUM AHD	SCALE <b>1:400 @ A1</b>
ORIGIN OPM60301 RL 44.315 Barrams Rd Sth Ripley	Date November 2017
FB : TSC3 LB :	Surveyed by RPS
	Comp by RPS
	DWG 116052 s17s19 Storm

CLIENT <b>AMEX CORP. PTY LTD</b>	
<b>AS CONSTRUCTED</b>	
<b>STORMWATER RETICULATION MAIN</b>	
<b>STAGE 17</b>	
Parish Local Authority	Job Ref 116052-35
IPSWICH CITY COUNCIL	

**RPS**

©COPYRIGHT PROTECTS THIS PLAN  
Unauthorized reproduction or amendment  
not permitted. Please contact the author.




RPS Australia East Pty Ltd  
ACN 140 292 762  
ABN 44 140 292 762  
180 Brisbane Street  
PO Box 341  
Ipswich QLD 4305  
T +61 7 3437 2000  
F +61 7 3434 2099  
W rpsgroup.com.au

Reference <b>116052-209</b>	Rev
--------------------------------	-----



- LEGEND**
- Stormwater Line
  - Lot Boundary
  - Stage Boundary
  - Manhole
  - Grated Pit

- ABBREVIATIONS**
- GT Surface Level of Grated Pit (at invert of kerb)
  - IL Invert Level
  - KA Kerb Adaptor
  - LID Surface Level of Manhole Lid (at lid centre)

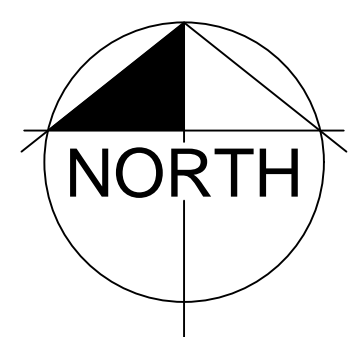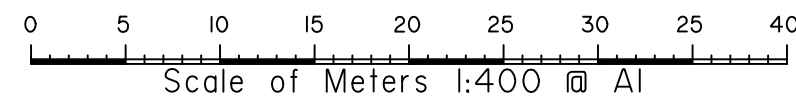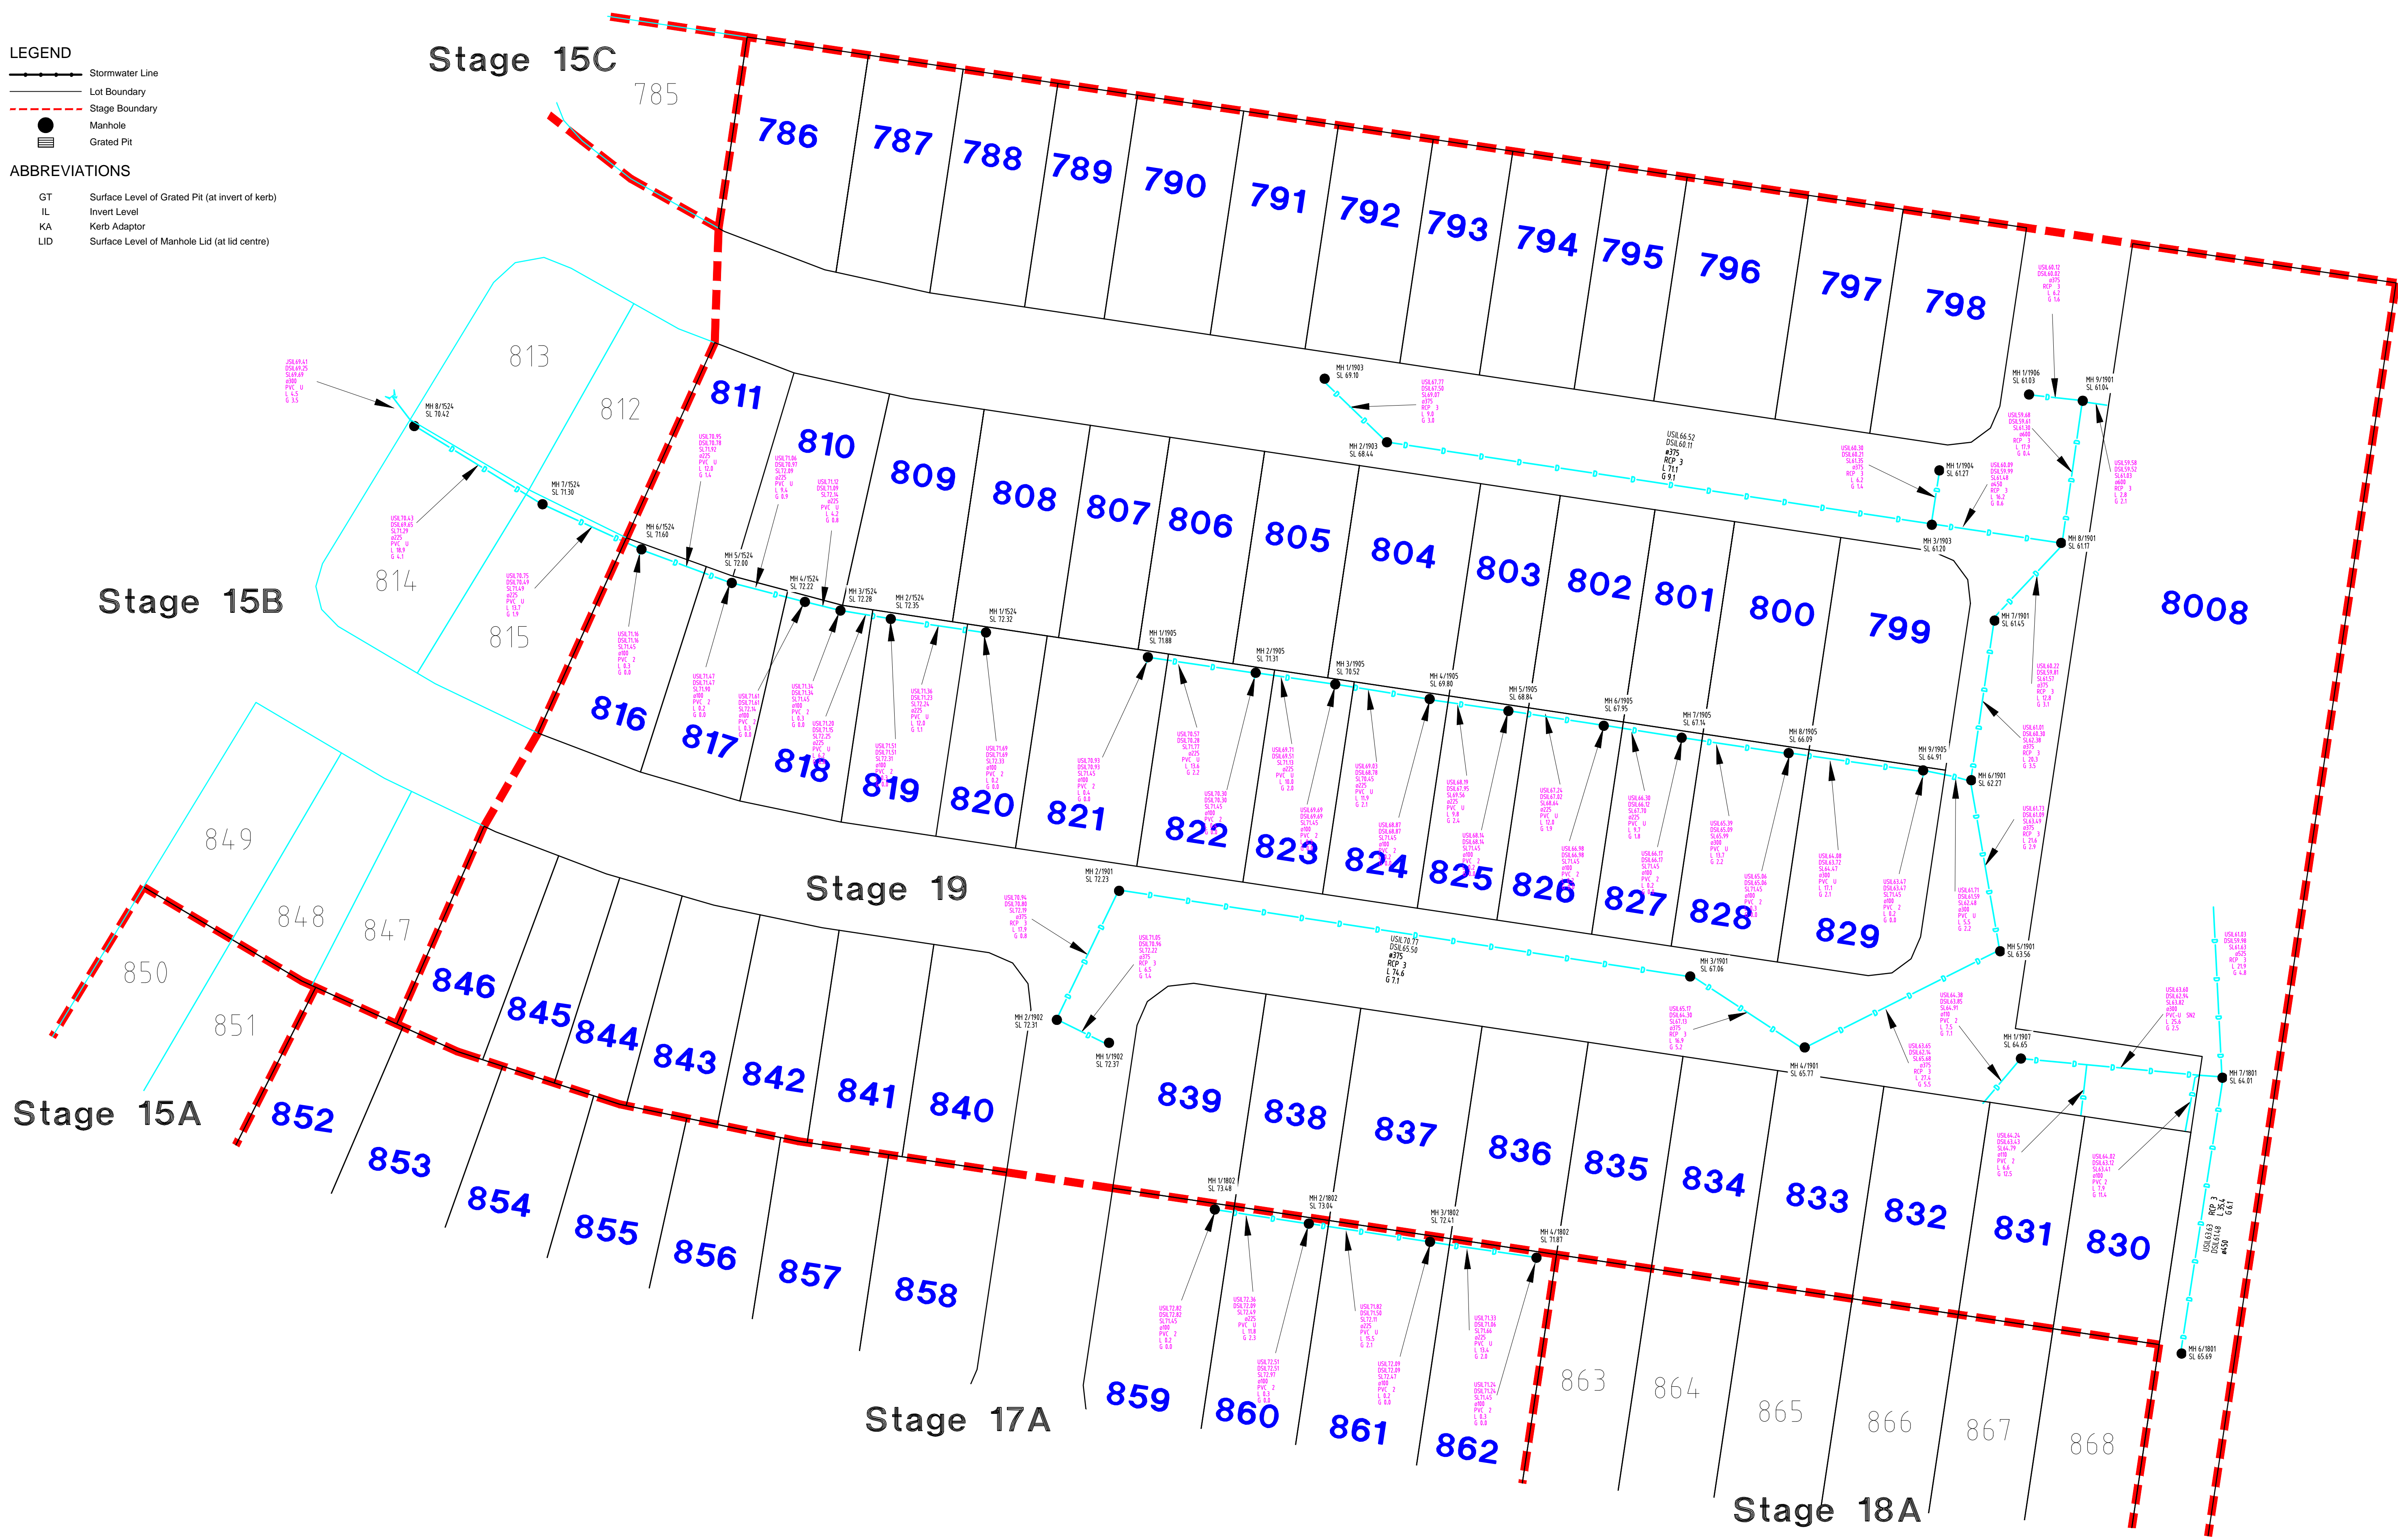

**BUILDERS ISSUE**

<b>PROJECT</b> <i>Providence, Ripley</i>	
LEVEL DATUM AHD	SCALE <b>1:400 @ A1</b>
ORIGIN OPM60301 RL 44.315 Barrams Rd Sth Ripley	Date November 2017
FB : TSC3	Comp by RPS
LB :	DWG 116052 s17s19 Storm

<b>CLIENT</b> <b>AMEX CORP. PTY LTD</b>	
<b>AS CONSTRUCTED</b> <b>STORMWATER RETICULATION MAIN</b> <b>STAGE 19</b>	
Parish	Job Ref
Local Authority IPSWICH CITY COUNCIL	116052-37

©COPYRIGHT PROTECTS THIS PLAN  
Unauthorized reproduction or amendment  
not permitted. Please contact the author.

RPS Australia East Pty Ltd  
ACN 140 292 762  
ABN 44 140 292 762  
180 Brisbane Street  
PO Box 345  
Ipswich QLD 4305  
T +61 7 3437 2000  
F +61 7 3434 2099  
W rpsgroup.com.au

Reference <b>116052-210</b>	Rev
--------------------------------	-----