
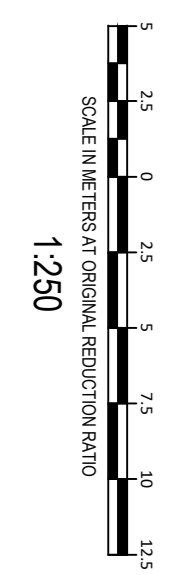


Stage 19


Stage 17A

Stage 17C

Stage 18B

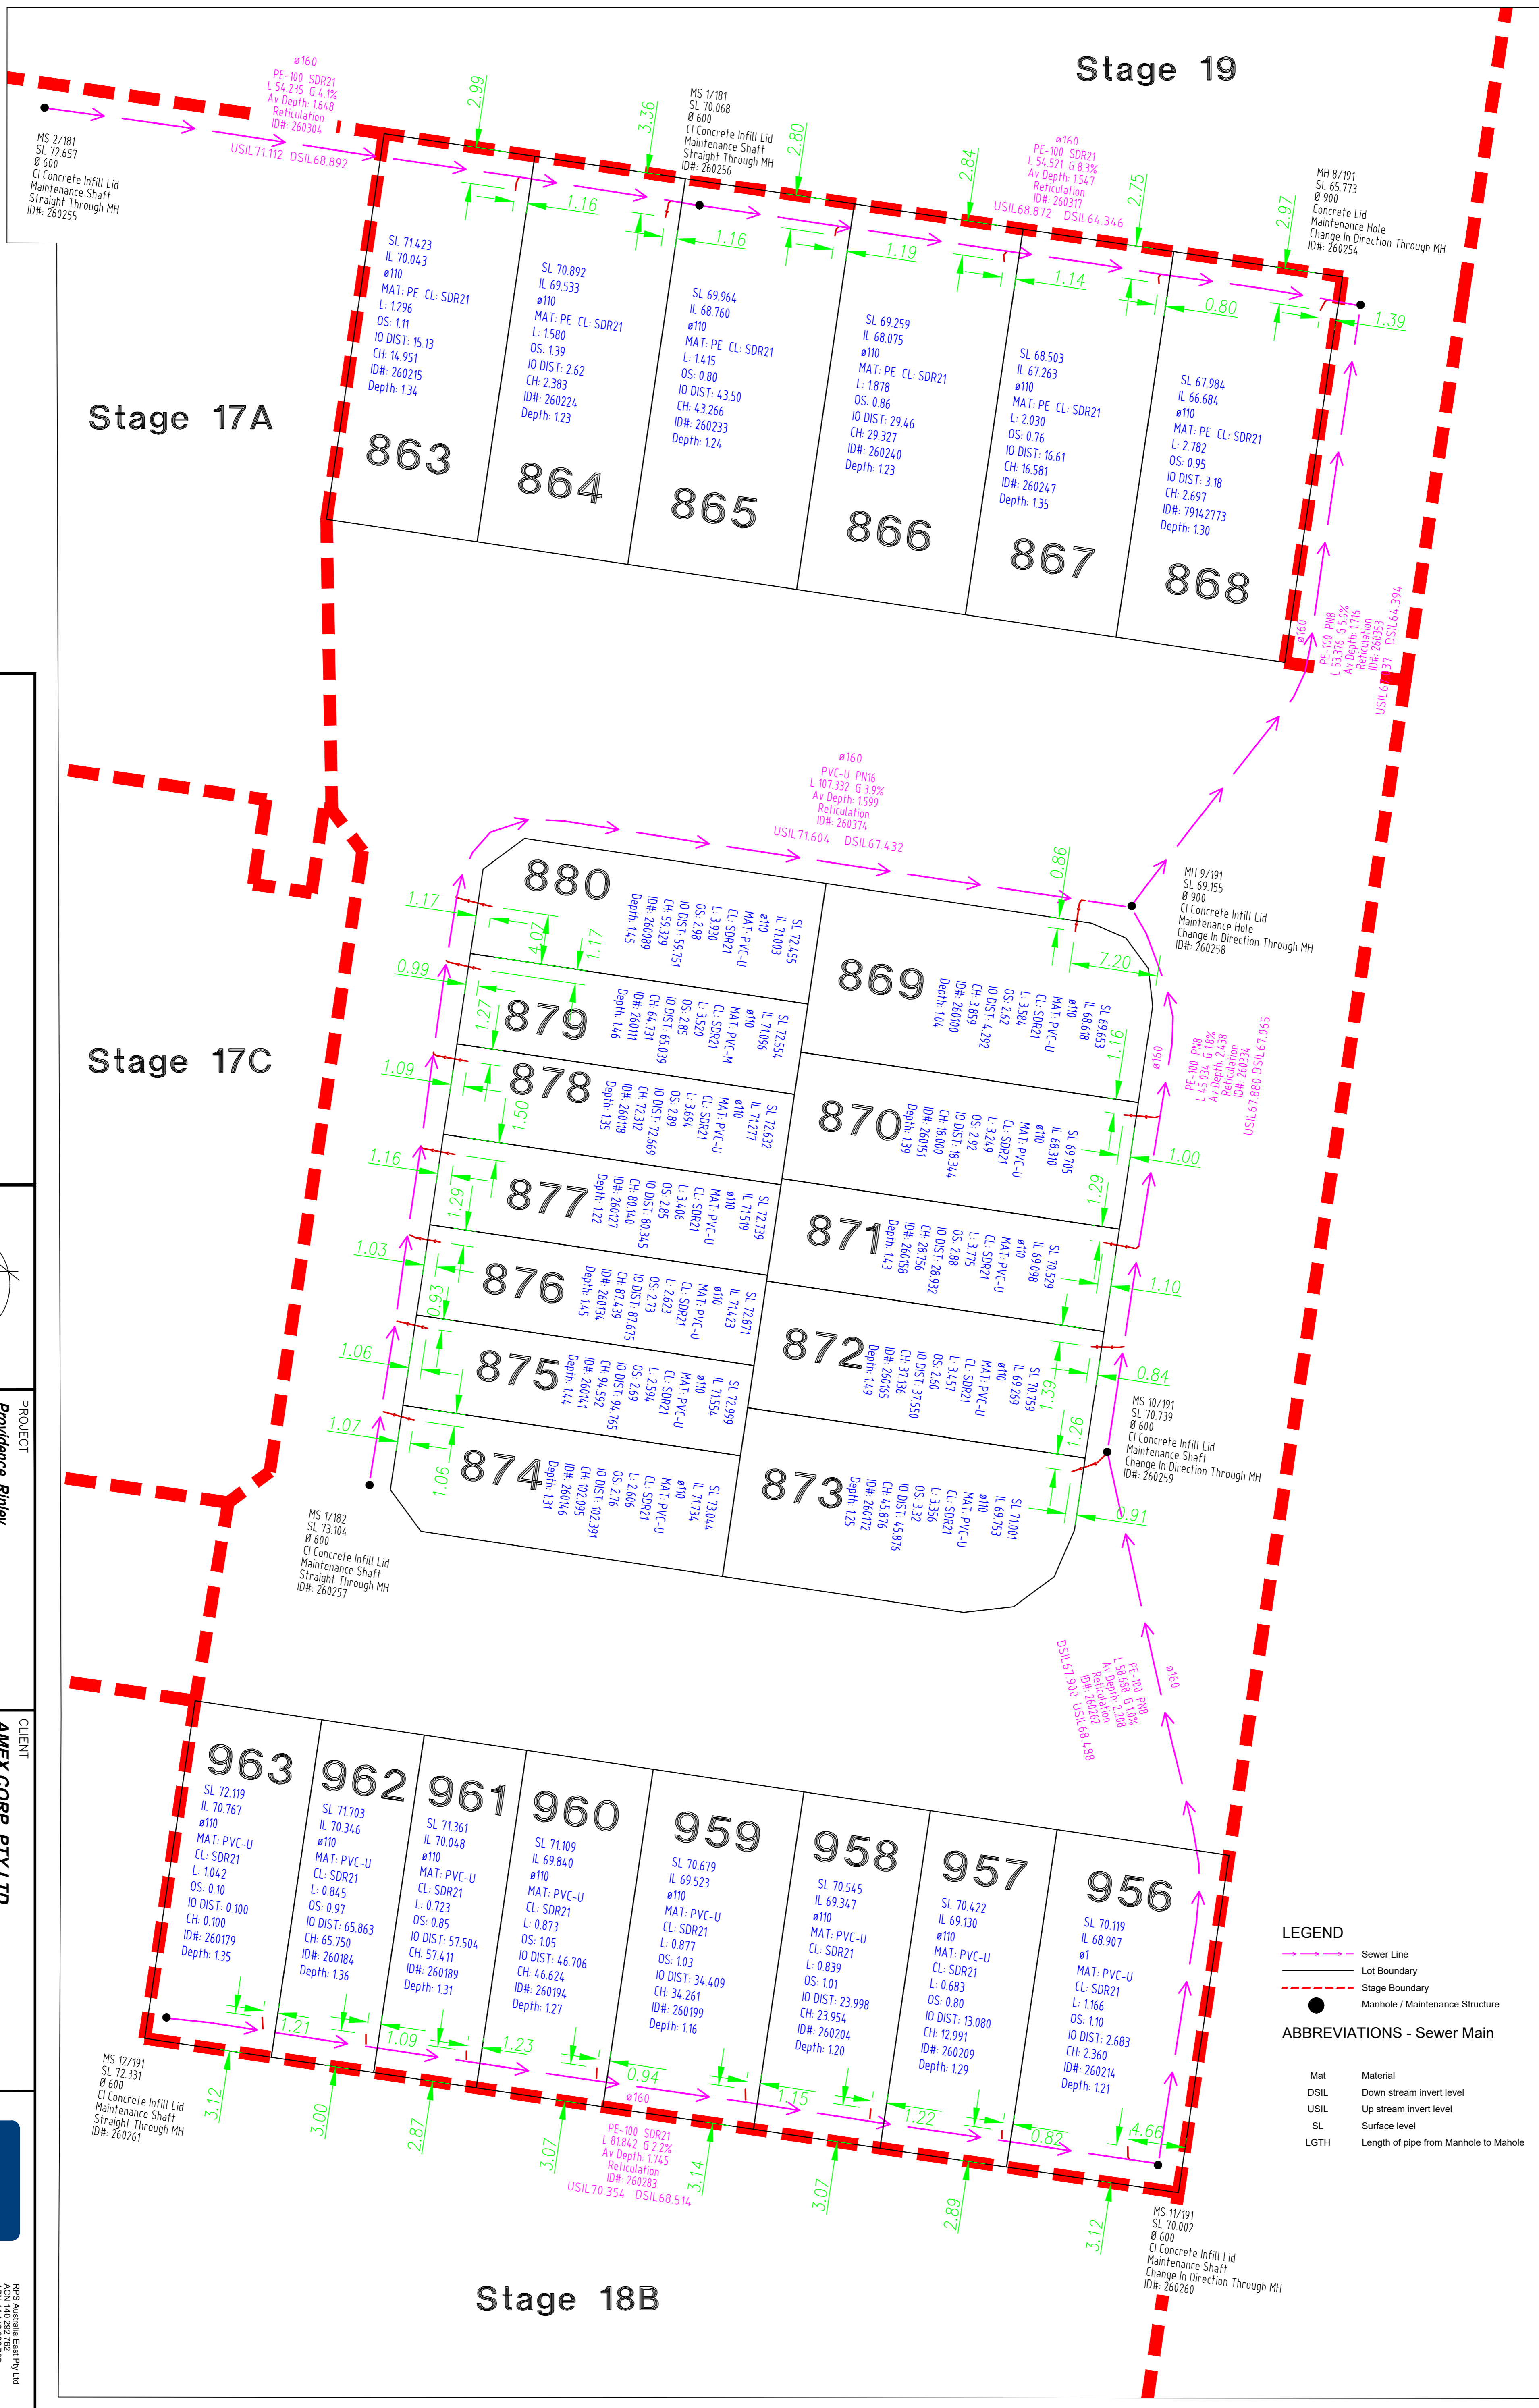

FINAL ISSUE

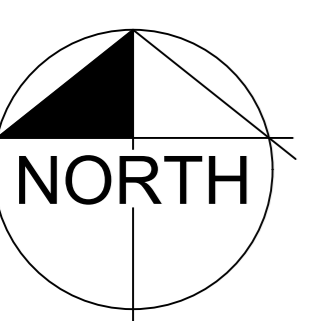

| | | | |
|--------------------------------------|-----------------------------|---|---|
| PROJECT Providence, Ripley | | CLIENT AMEX CORP. PTY LTD | |
| LEVEL DATUM AHD | SCALE 1:400 @ A1 | AS CONSTRUCTED SEWER RETICULATION | STAGE 18A |
| ORIGIN OPM60301 | Date January 2018 | Surveyed RPS | Perish Local Authority - IPSWICH CITY COUNCIL |
| FB : FLD IB : | Drawn RPS | Job Ref 116052-36 | Reference 116052- |
| REVISIONS | | REV | |

LEGEND

- Sewer Line
- Lot Boundary
- Stage Boundary
- Manhole / Maintenance Structure

ABBREVIATIONS - Sewer Main

- Mat: Material
- DSIL: Down stream invert level
- USIL: Up stream invert level
- SL: Surface level
- LGTH: Length of pipe from Manhole to Mahole



RPS Australia East Pty Ltd
ACN 140 282 762
Level 14, 140 282 762
PO Box 4444
Brisbane QLD 4305
T +61 7 3437 2000
F +61 7 3434 2099
W rpsgroup.com.au