


BUILDERS ISSUE

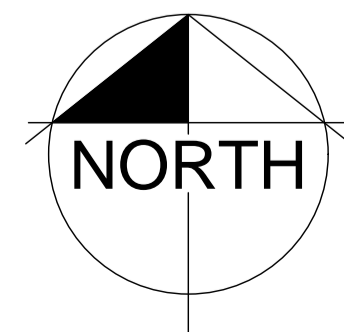


PROJECT Providence, Ripley	
LEVEL DATUM AHD	SCALE 1:300 @ A1
ORIGIN OPM60301 RL 44.315 Barrams Rd Sth Ripley	Date: AUGUST 2017 Surveyed: RPS Comp by: RPS
FB : FLD	LB : DWG: 116052 s31 Sewer

CLIENT AMEX CORP, PTY LTD	
AS CONSTRUCTED STORMWATER RETICULATION MAIN STAGE 31 - Sheet 1	
Parish	Job Ref 116052
Local Authority IPSWICH CITY COUNCIL	

RPS Australia East Pty Ltd
ACN 140 292 762
ABN 44 140 292 762
180 Brisbane Street
PO Box 241
Ipswich QLD 4305
T +61 7 3437 2000
F +61 7 3434 2099
W rpsgroup.com.au



BUILDERS ISSUE

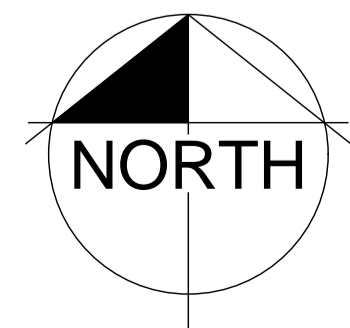


PROJECT Providence, Ripley	
LEVEL DATUM AHD	SCALE 1:300 @ A1
ORIGIN OPM60301 RL 44.315 Barrams Rd Sth Ripley	Date: AUGUST 2017 Surveyed: RPS Comp by: RPS
FB : FLD	LB : DWG: 116052 s31 Sewer


CLIENT AMEX CORP, PTY LTD	
AS CONSTRUCTED STORMWATER RETICULATION MAIN STAGE 31 - Sheet 2	
Parish	Job Ref 116052
Local Authority IPSWICH CITY COUNCIL	Rev

RPS Australia East Pty Ltd
ACN 140 292 762
ABN 44 140 292 762
180 Brisbane Street
PO Box 341
Ipswich QLD 4305
T +61 7 3437 2000
F +61 7 3434 2099
W rpsgroup.com.au

Reference
116052-199

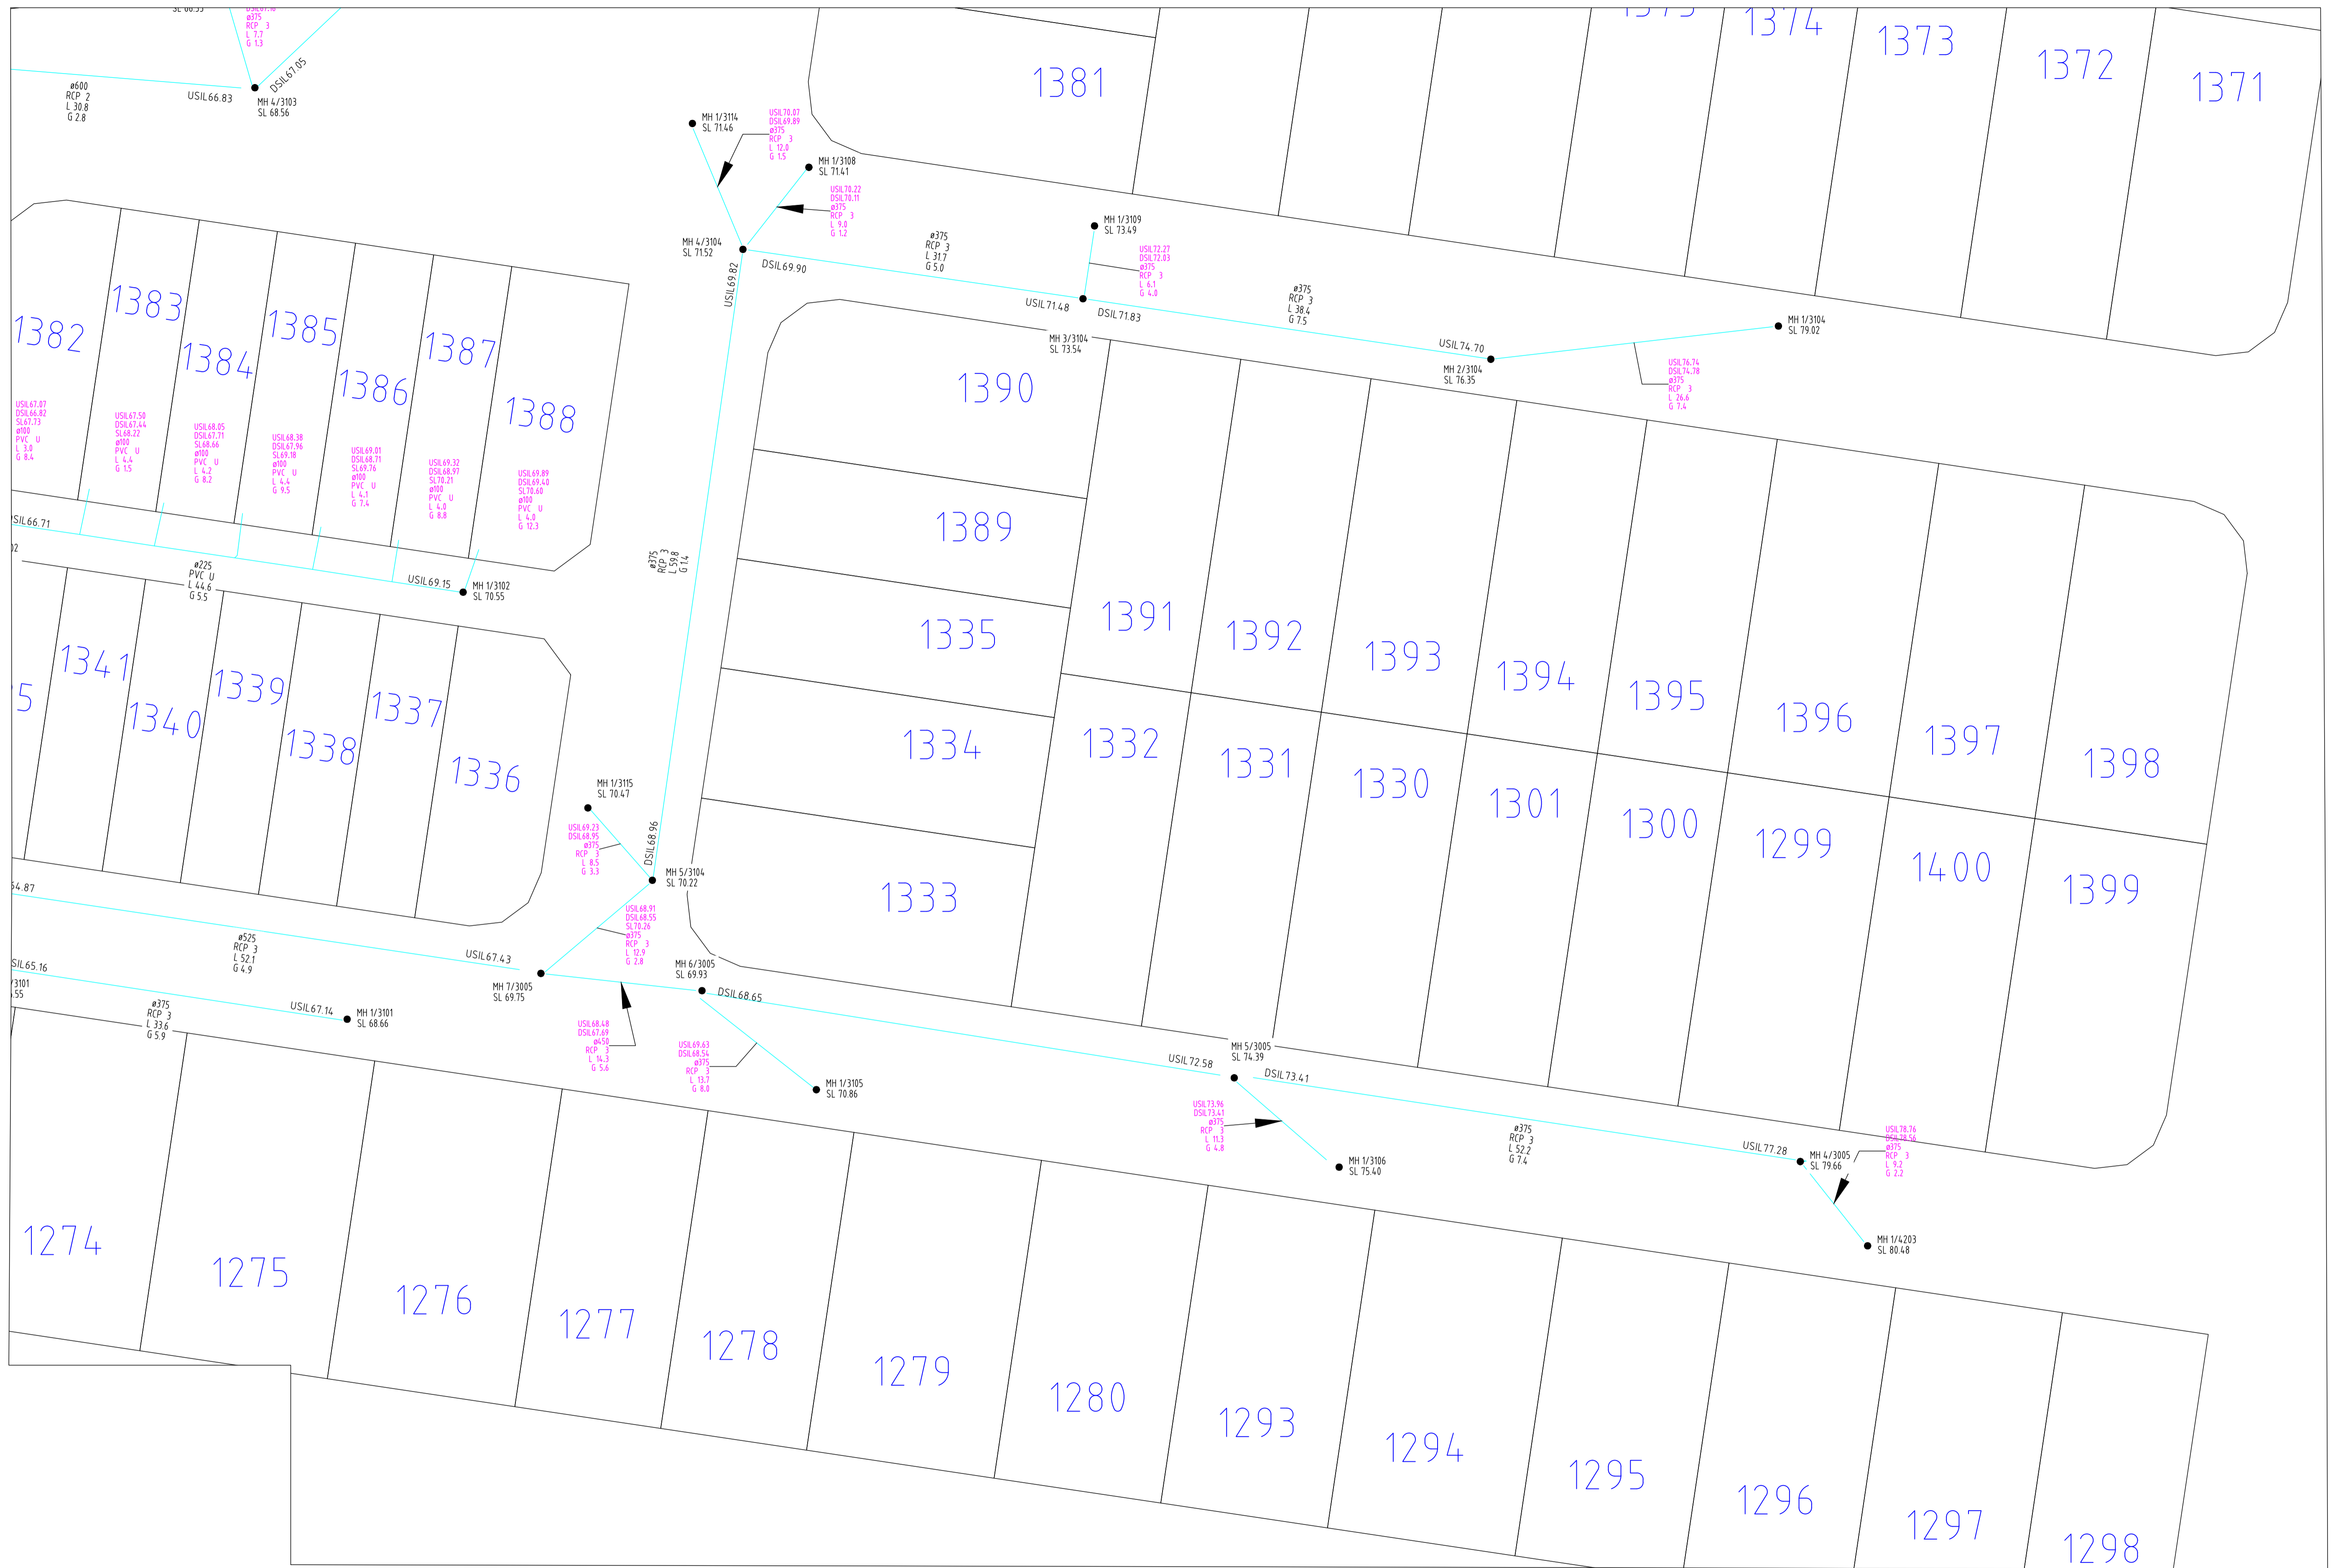

BUILDERS ISSUE

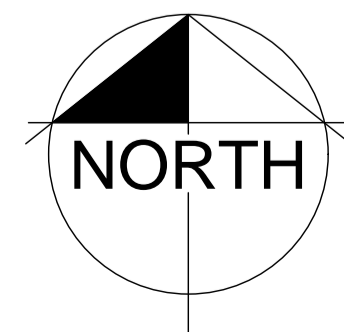

PROJECT Providence, Ripley	
LEVEL DATUM AHD	SCALE 1:300 @ A1
ORIGIN OPM60301 RL 44.315 Barrams Rd Sth Ripley	Date: AUGUST 2017 Surveyed: RPS Comp by: RPS
FB : FLD	LB : DWG: 116052 s31 Sewer

CLIENT AMEX CORP, PTY LTD	
AS CONSTRUCTED STORMWATER RETICULATION MAIN STAGE 31 - Sheet 3	
Parish	Job Ref 116052
Local Authority IPSWICH CITY COUNCIL	

RPS
© COPYRIGHT PROTECTS THIS PLAN
 Unauthorised reproduction or amendment
 not permitted. Please contact the author.

RPS Australia East Pty Ltd
 ACN 140 292 762
 ABN 44 140 292 762
 180 Brisbane Street
 PO Box 341
 Ipswich QLD 4305
 T +61 7 3437 2000
 F +61 7 3434 2099
 W rpsgroup.com.au

Reference 116052-199	Rev
--------------------------------	-----