


SURVEY DATUM
 Coordinate System: MGA94 coordinates
 Vertical Datum: Australian Height Datum (AHD71)

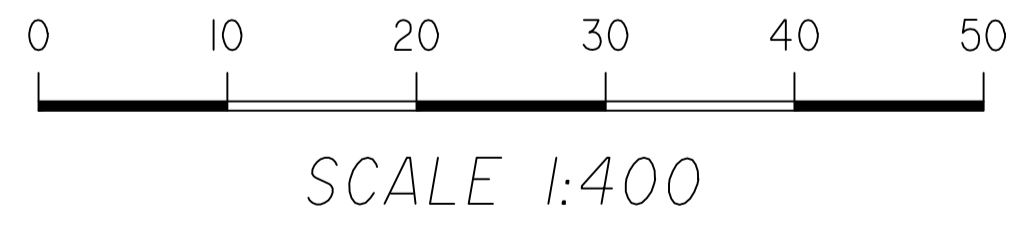

BUILDERS ISSUE

PROJECT Providence, Ripley		CLIENT AMEX CORP. PTY LTD	
LEVEL DATUM AHD	SCALE 1:500 @ A1	AS CONSTRUCTED SEWER HOUSE CONNECTIONS STAGE 4A & 4B	
ORIGIN OPM60301 RL 44-315 Barrams Rd Sth Ripley	Date AUG 2015 Surveyed RPS Comp by BR		
FB : TSC3	LB :	DWG I16052S4-6SewerHC	Parish Local Authority IPSWICH CITY COUNCIL
Job Ref I16052		Reference 116052-49	

RPS

©COPYRIGHT PROTECTS THIS PLAN
 Unauthorised reproduction or amendment
 not permitted. Please contact the author.

RPS Australia East Pty Ltd
 ACN 140 292 762
 ABN 44 140 292 762
 180 Brisbane Street
 PO Box 341
 Ipswich QLD 4305
 T +61 7 3437 2000
 F +61 7 3434 2099
 W rpsgroup.com.au