



MH-11/T1
SL: 46-552
Depth: 4-22
Manhole
Concrete #200
CLASS B
Date: 2015-04

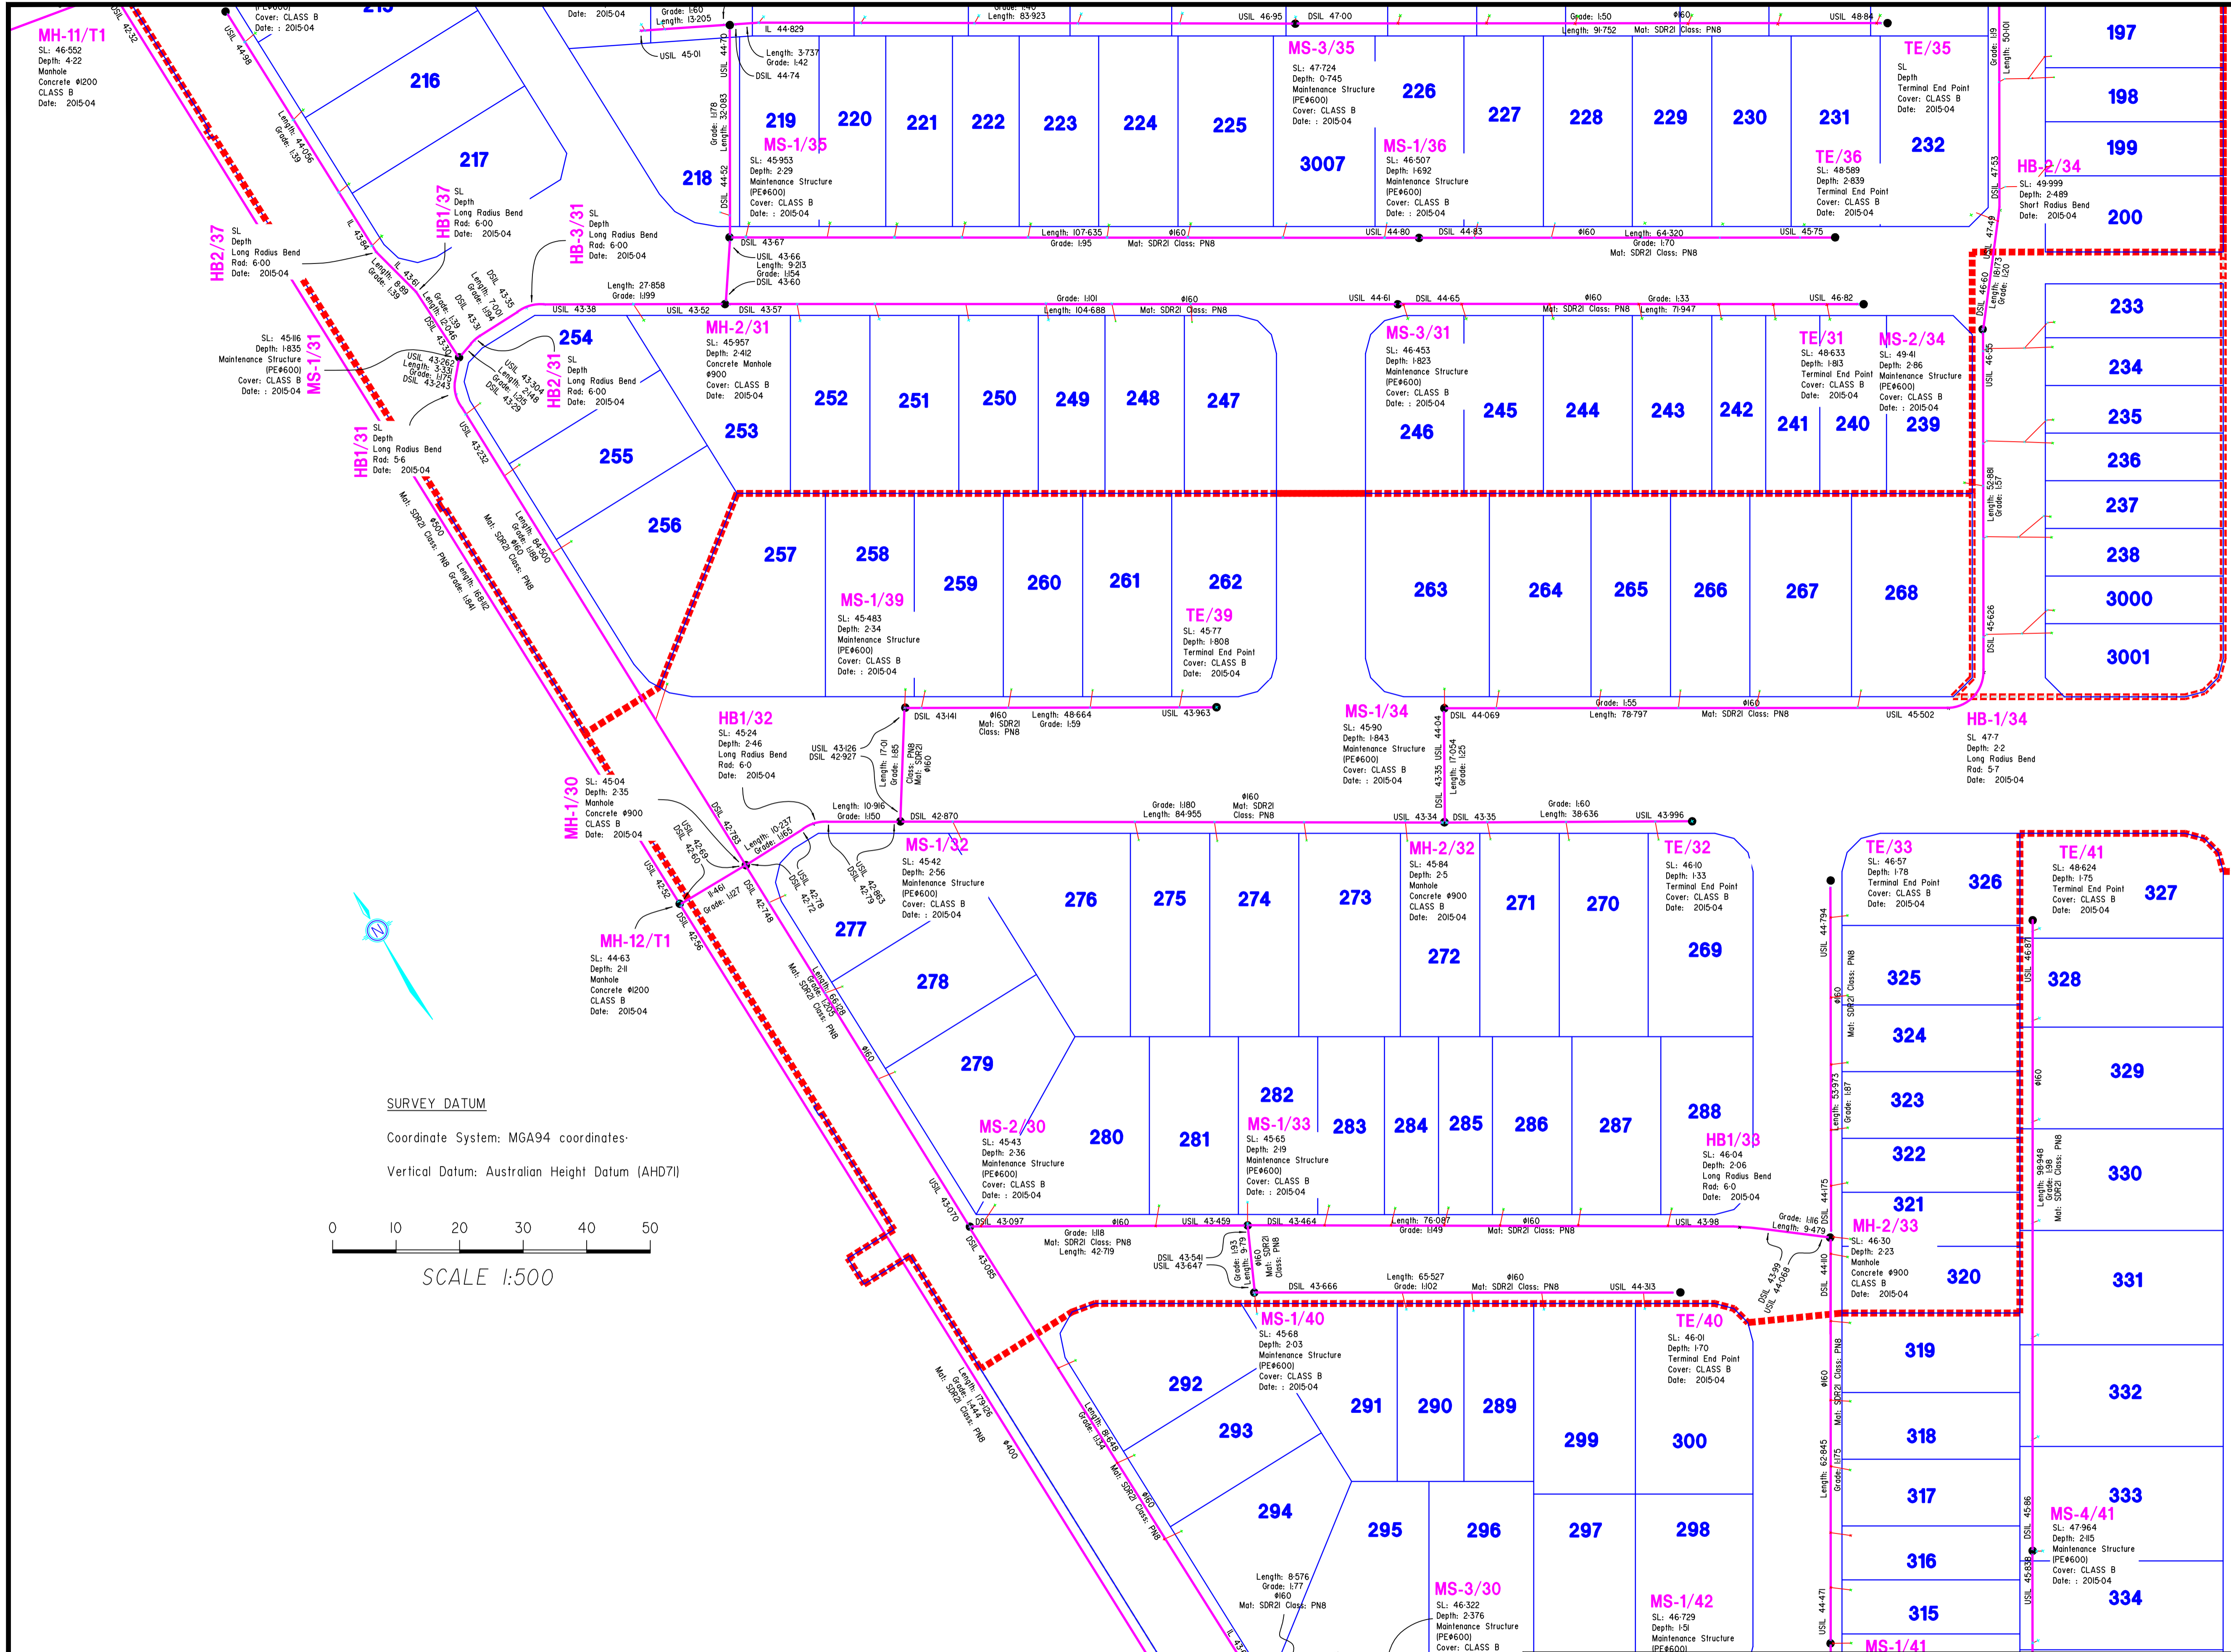

SURVEY DATUM
Coordinate System: MGA94 coordinates
Vertical Datum: Australian Height Datum (AHD71)

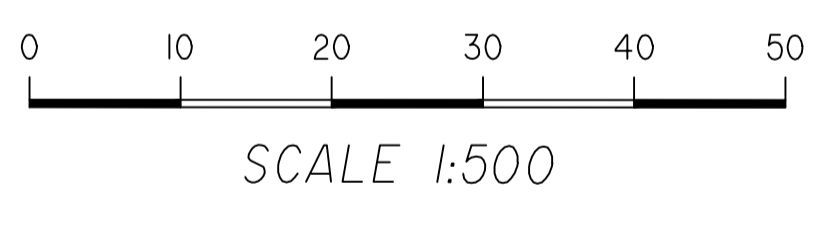

BUILDERS ISSUE

PROJECT Providence Ripley		CLIENT AMEX CORP. PTY LTD	
LEVEL DATUM AHD	SCALE 1:500 @ A1	AS CONSTRUCTED SEWER MAIN RETICULATION STAGE 4	
ORIGIN OPM60301 RL 44-315 Barrams Rd, Sth Ripley	Date AUG 2015	Parish	Job Ref 116052-10
FB : TSC3	LB :	Comp by BR / DJL	DWG 116052S4-6Sewer Mains

RPS

©COPYRIGHT PROTECTS THIS PLAN
Unauthorized reproduction or amendment
not permitted. Please contact the author.

RPS Australia East Pty Ltd
ACN 140 292 762
ABN 44 140 292 762
180 Brisbane Street
PO Box 341
Ipswich QLD 4305
T +61 7 3437 2000
F +61 7 3434 2099
W rpsgroup.com.au

Reference
116052-26

Rev