
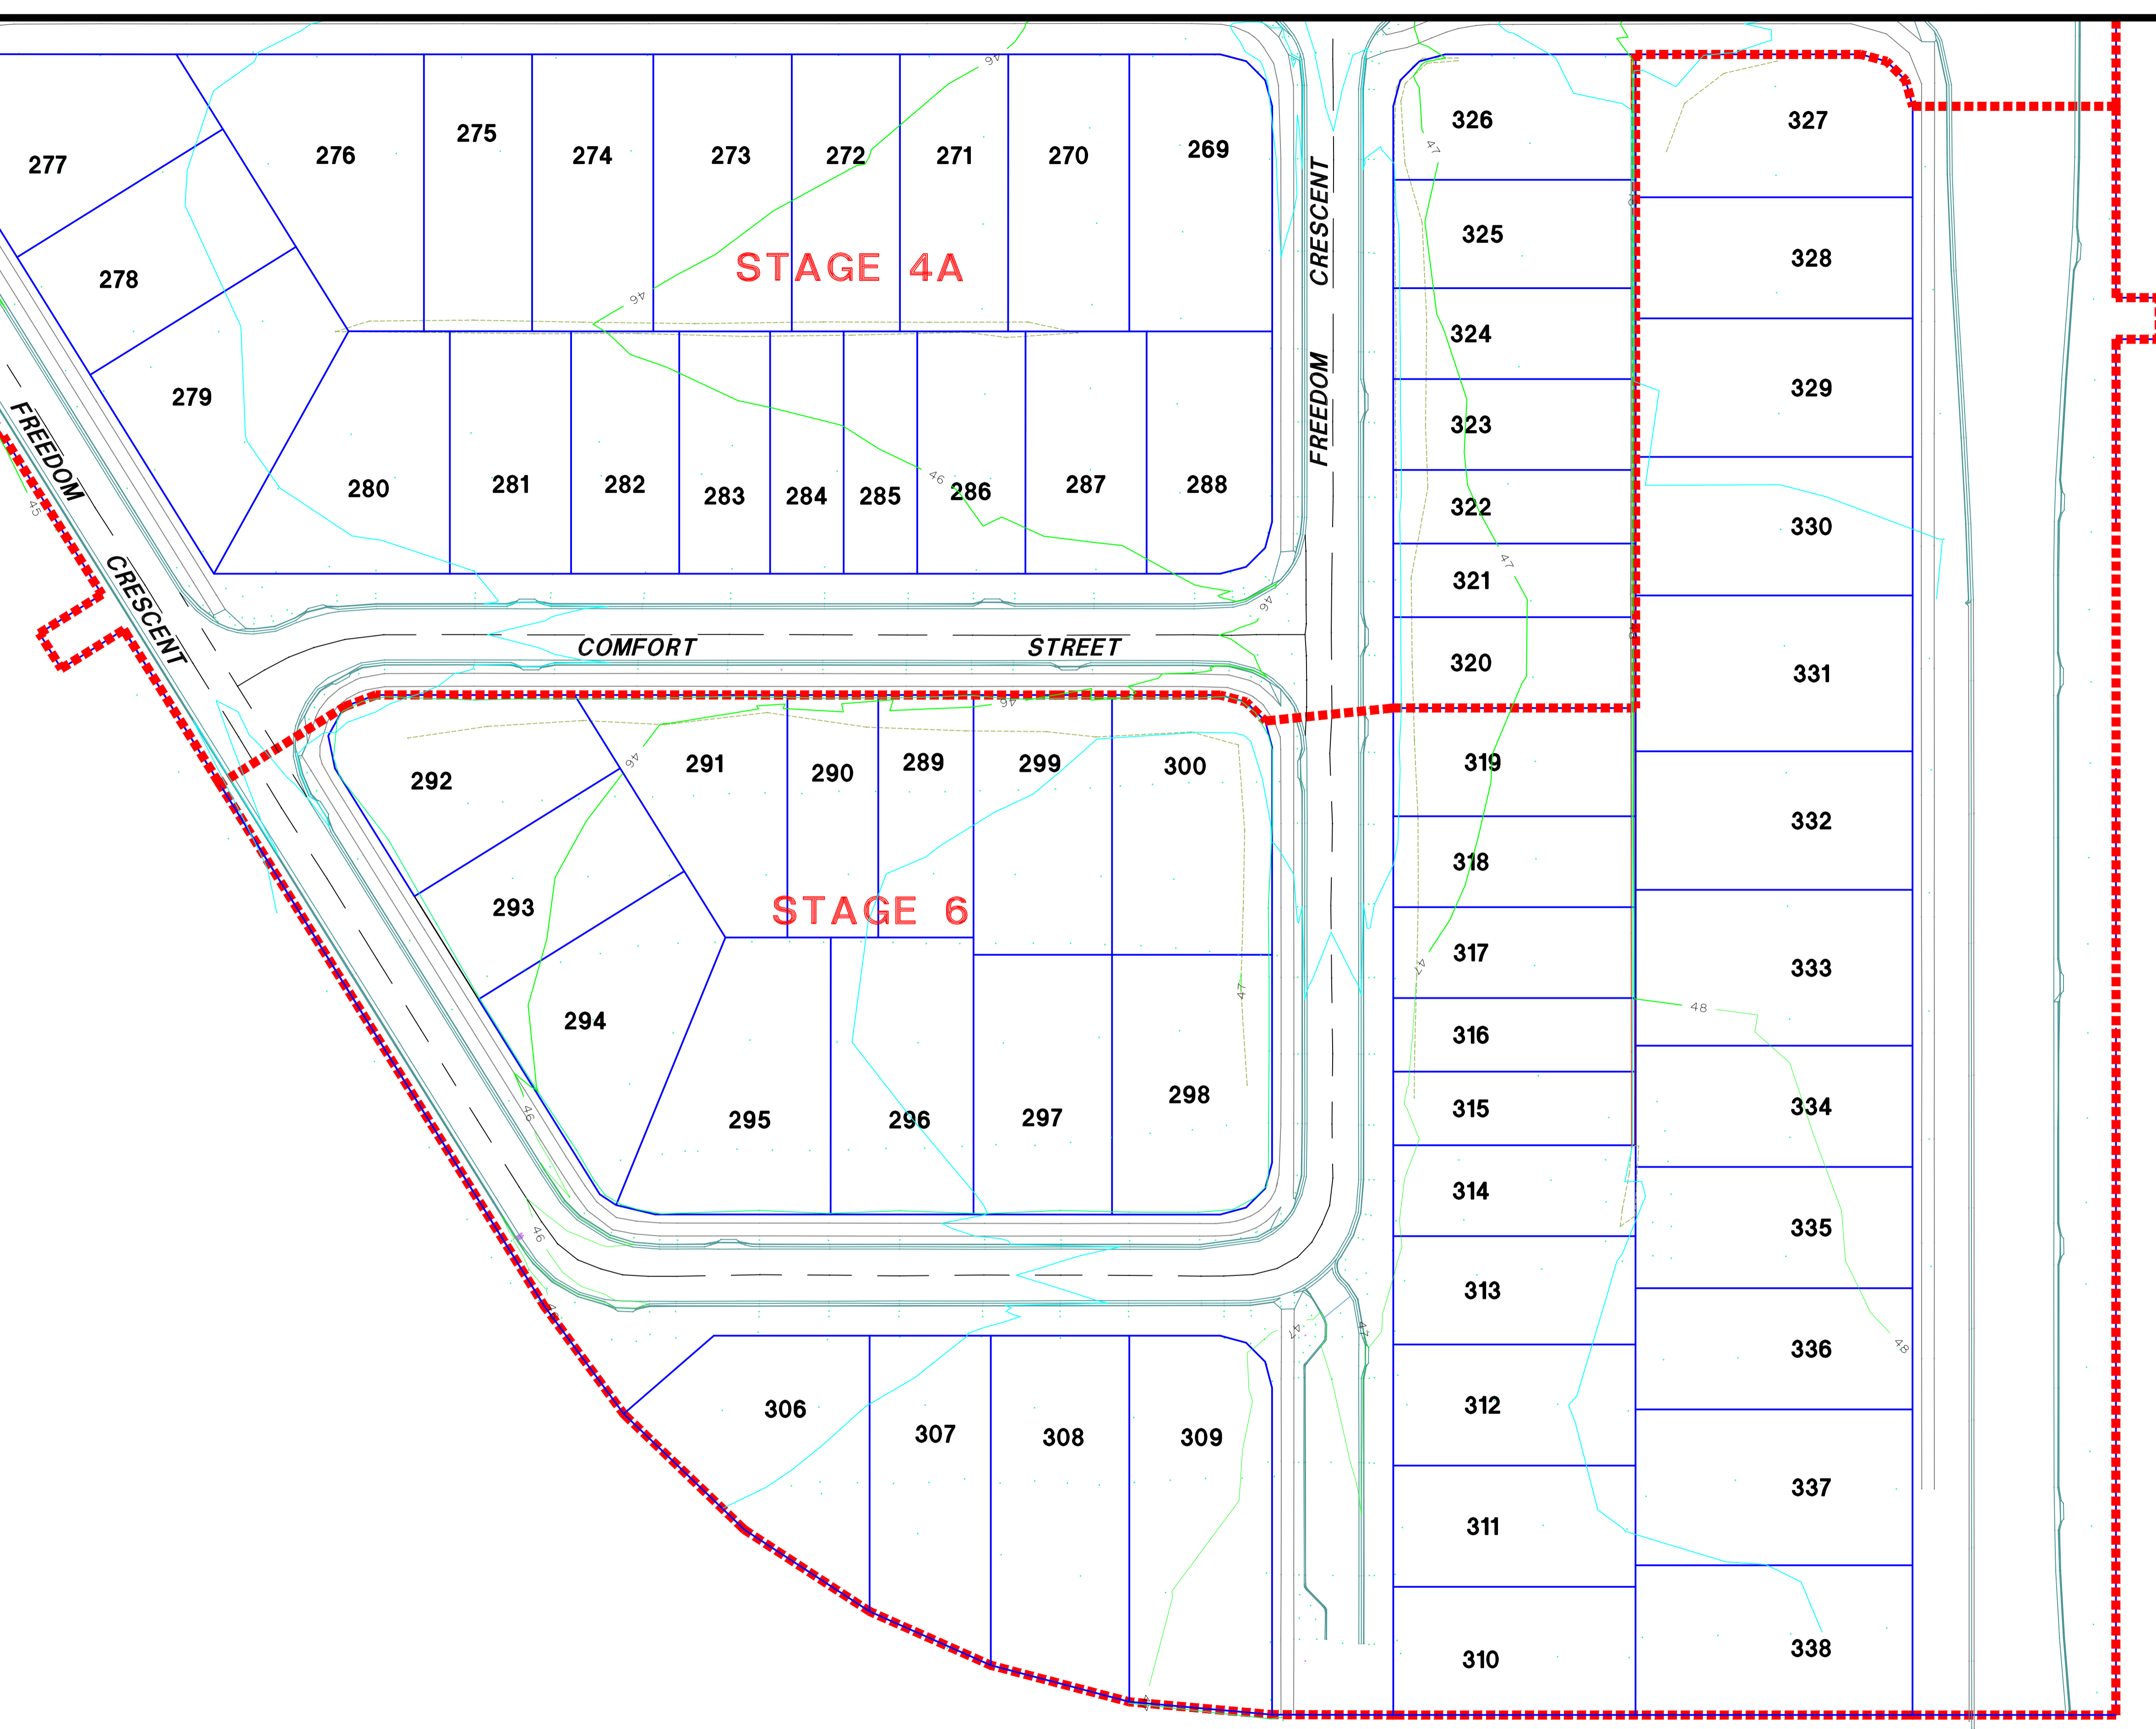


SURVEY DATUM

Coordinate System: MGA94 coordinates

Vertical Datum: Australian Height Datum (AHD71)

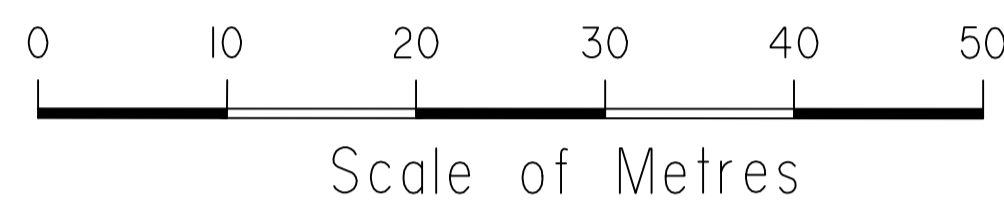

BUILDERS ISSUE

PROJECT Providence, Ripley		CLIENT AMEX CORP. PTY LTD	
LEVEL DATUM AHD	SCALE 1:400 @ A1	AS CONSTRUCTED PLAN POST CONSTRUCTION CONTOURS STAGE 6	
ORIGIN OPM60301 RL 44.315 Barrams Rd Sth Ripley	Date AUG 2015 Surveyed RPS Comp by BR		
FB TSC3	LB 116052S4-6Post	Local Authority IPSWICH CITY COUNCIL	Job Ref 116052

RPS
 RPS Australia East Pty Ltd
 ACN 140 292 762
 ABN 44 140 292 762
 180 Brisbane Street
 PO Box 341
 Ipswich QLD 4305
 T +61 7 3437 2000
 F +61 7 3434 2099
 W rpsgroup.com.au