



SURVEY DATUM

Coordinate System: MGA94 coordinates.

Vertical Datum: Australian Height Datum (AHD71)

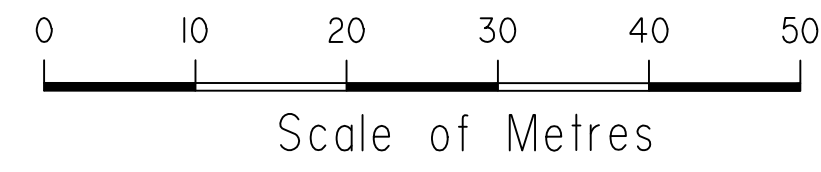

- T - Water Tee
- V - Water Valve
- FH - Water Fire Hydrant
- B - Water Bend
- WM - Water Meter
- TB - Water Tapping Band

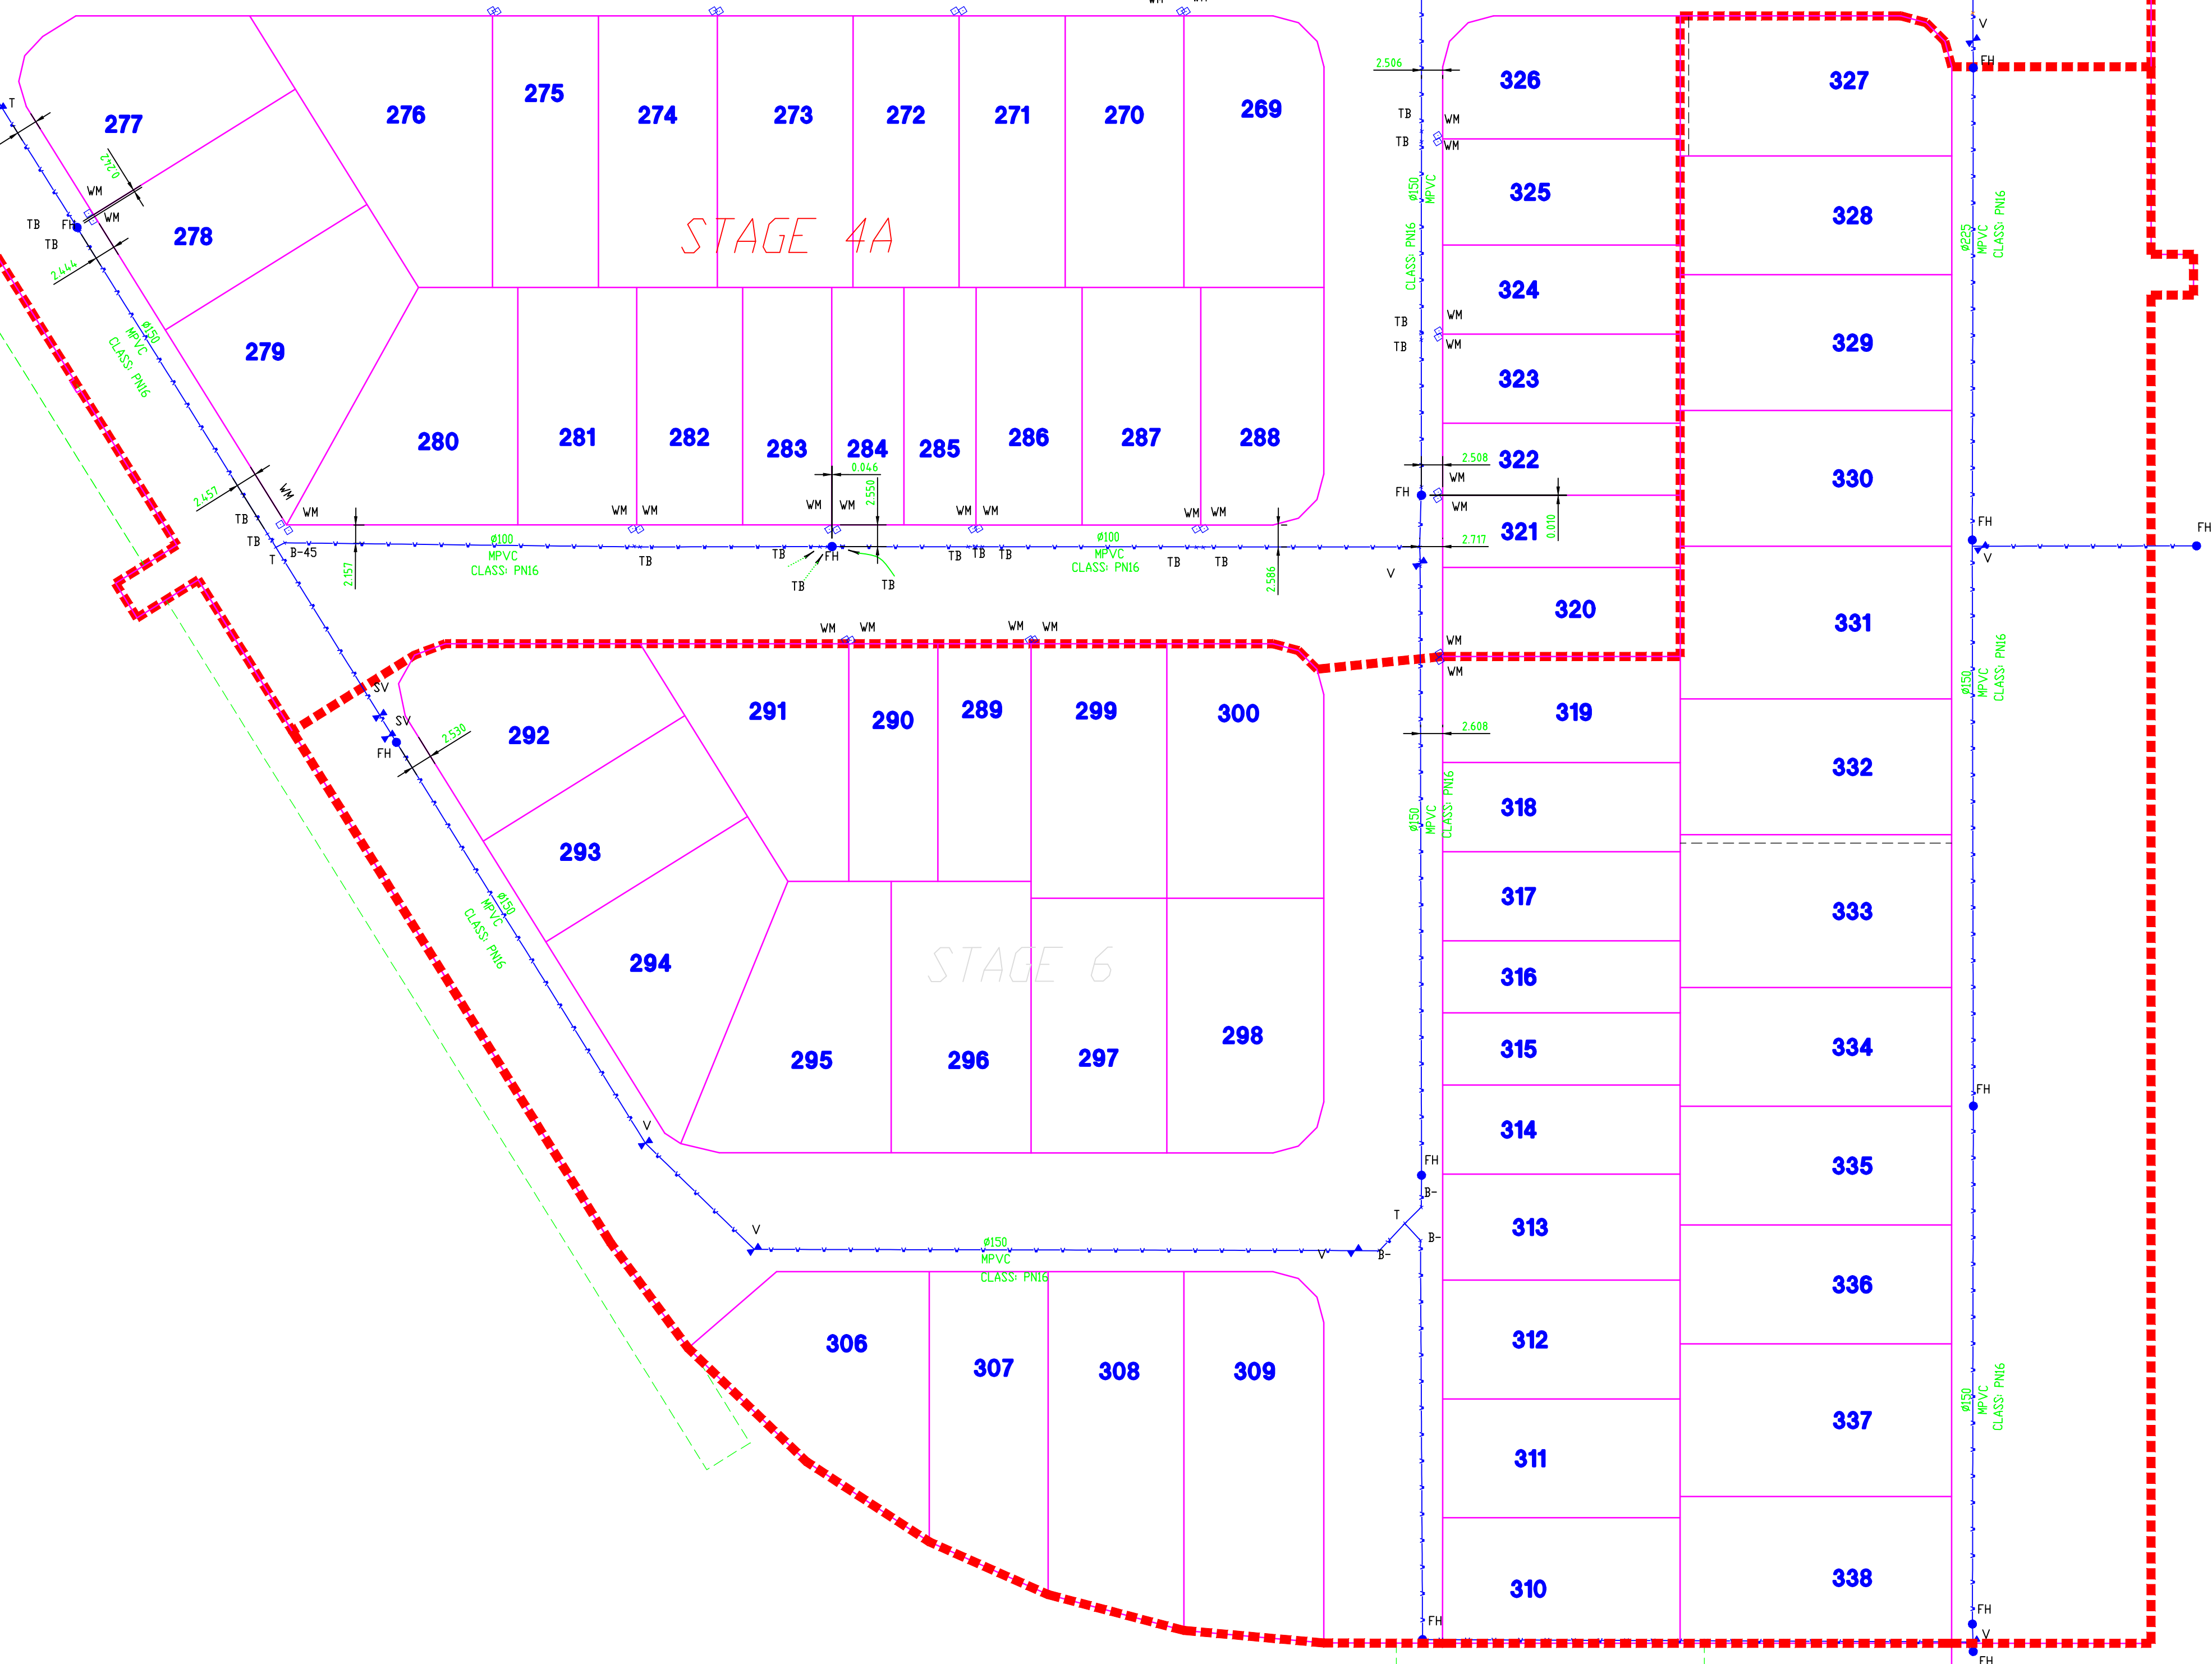

BUILDERS ISSUE

PROJECT Providence Ripley Stage 6		CLIENT AMEX CORP. PTY LTD	
LEVEL DATUM AHD	SCALE 1:500 @ A1	AS CONSTRUCTED WATER RETICULATION STAGE 6	
ORIGIN OPM60301 RL 44.315 Barrams Rd Sth Ripley	Date AUG 2015		
FB: TSC3	LB: DWG 116052S4-6Water		
Comp by BR		Parish	Job Ref 116052
Local Authority IPSWICH CITY COUNCIL			

RPS Australia East Pty Ltd
ACN 140 292 762
ABN 44 140 292 762
180 Brisbane Street
PO Box 341
Ipswich QLD 4305
T +61 7 3437 2000
F +61 7 3434 2099
W rpsgroup.com.au

©COPYRIGHT PROTECTS THIS PLAN
Unauthorized reproduction or amendment
not permitted. Please contact the author.

Reference	116052-56	Rev	
-----------	-----------	-----	--