




BUILDERS ISSUE

PROJECT Providence, Ripley		CLIENT AMEX CORP. PTY LTD	
LEVEL DATUM AHD	SCALE 1:300 @ A1	AS CONSTRUCTED SEWER HOUSE CONNECTIONS STAGE 21 - SHEET 1	
ORIGIN OPM60301 RL 44-315 Barrams Rd Sth Ripley	Date AUGUST 2016 Surveyed RPS Comp by DJL		
FB : TSC3	LB :	DWG I16052-Stage-20-21-SHC	Local Authority IPSWICH CITY COUNCIL

JOB REF I16052-26	
----------------------	--

RPS
RPS Australia East Pty Ltd
ACN 140 292 762
ABN 44 140 292 762
180 Brisbane Street
PO Box 341
Ipswich QLD 4305
T +61 7 3437 2000
F +61 7 3434 2099
W rpsgroup.com.au

Reference 116052-127	Rev
--------------------------------	-----

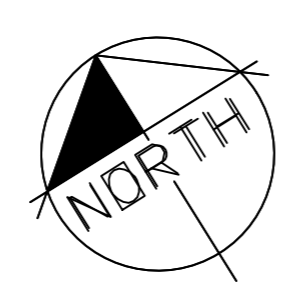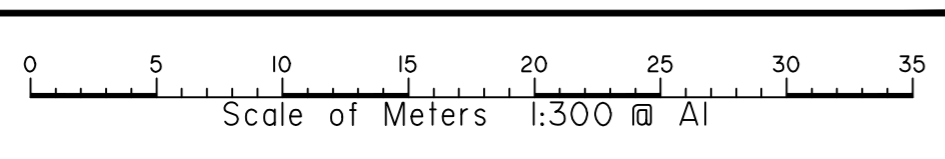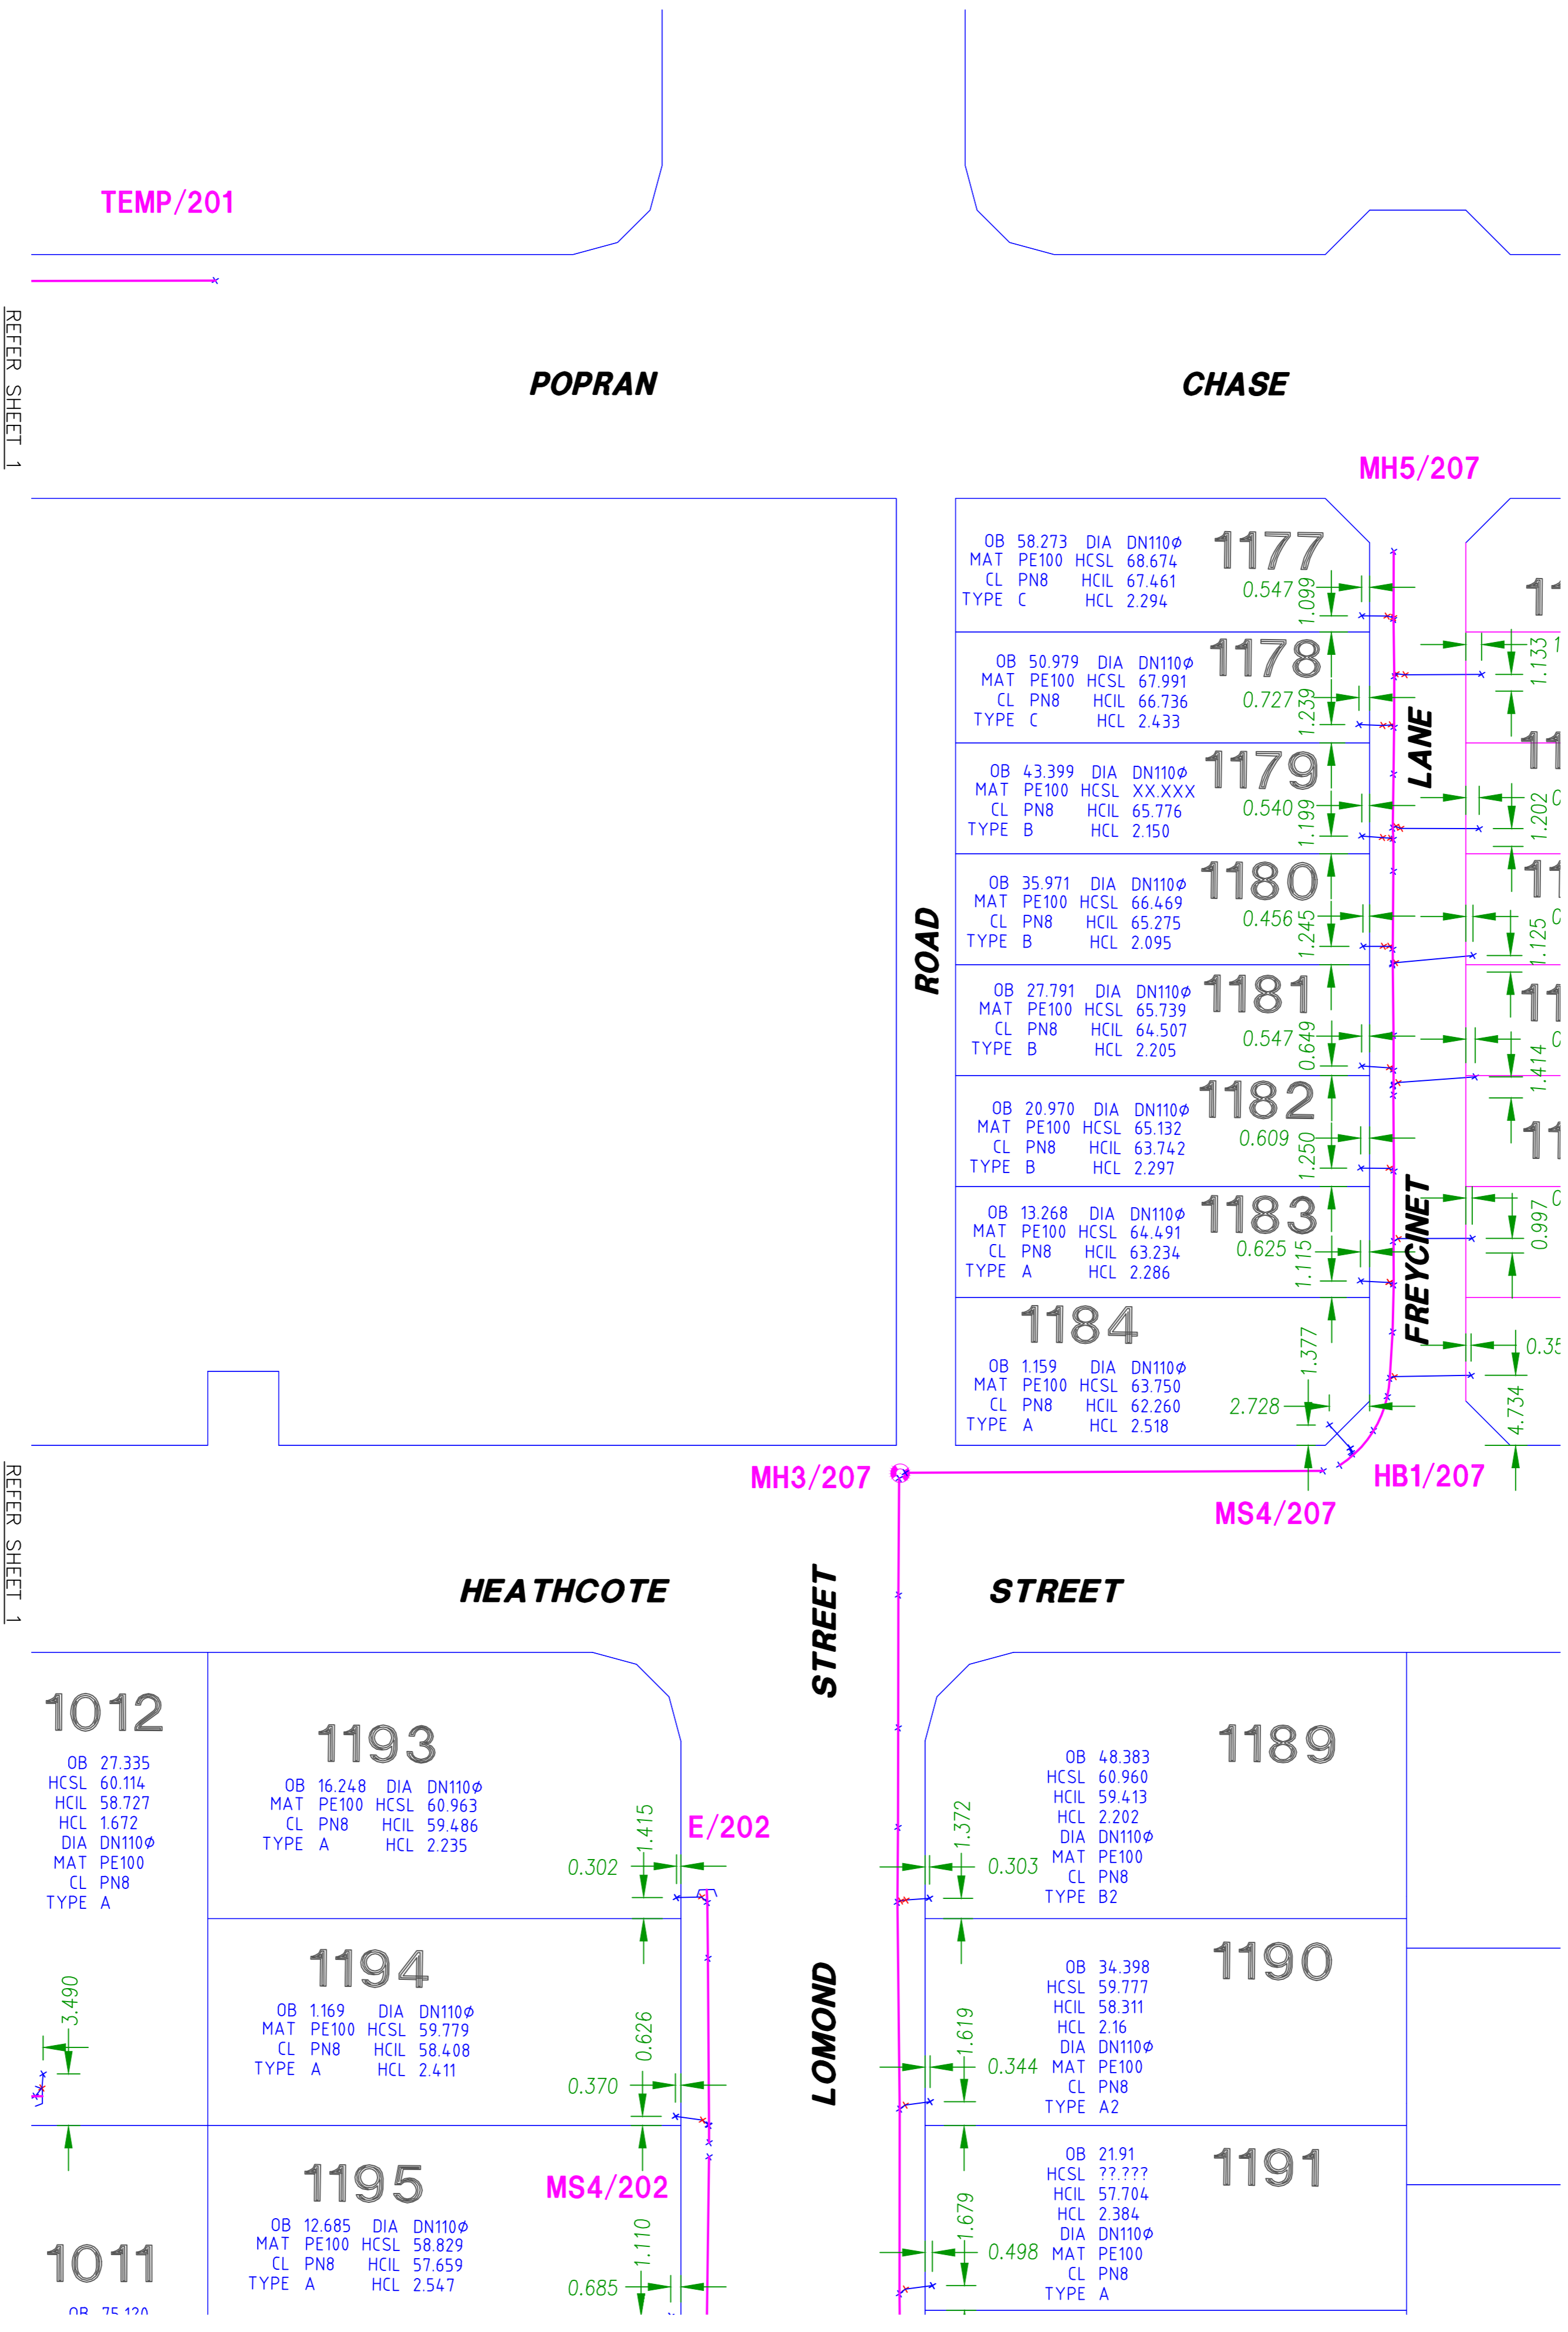

BUILDERS ISSUE

PROJECT Providence, Ripley		CLIENT AMEX CORP. PTY LTD	
LEVEL DATUM AHD	SCALE 1:300 @ A1	AS CONSTRUCTED SEWER HOUSE CONNECTIONS STAGE 21 - SHEET 2	
ORIGIN OPM60301 RL 44-315 Barrams Rd Sth Ripley	Date AUGUST 2016 Surveyed RPS Comp by DJL		
FB : TSC3	LB :	Parish Local Authority IPSWICH CITY COUNCIL	Job Ref 116052-26



RPS Australia East Pty Ltd
ACN 140 292 762
ABN 44 140 292 762
180 Brisbane Street
PO Box 341
Ipswich QLD 4305
T +61 7 3437 2000
F +61 7 3434 2099
W rpsgroup.com.au

©COPYRIGHT PROTECTS THIS PLAN
Unauthorised reproduction or amendment
not permitted. Please contact the author.

Reference 116052-127	Rev
--------------------------------	-----