
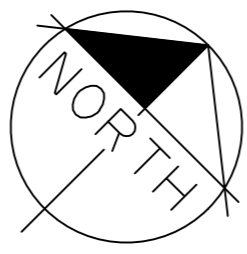


SURVEY DATUM
 Coordinate System: Local Site.
 Horizontal Azimuth: GDA94
 Vertical Datum: AHD71

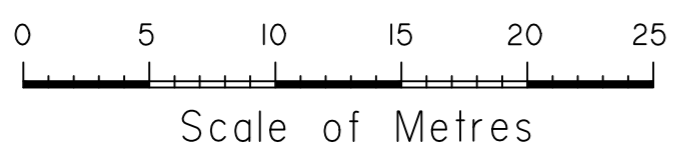

BUILDERS ISSUE

PROJECT Providence, Ripley		CLIENT AMEX CORP. PTY LTD	
LEVEL DATUM AHD	SCALE 1:300 @ A1	AS CONSTRUCTED SEWER RETICULATION MAIN STAGE 13	
ORIGIN OPM60301 RL 44-315 Barrams Rd Sth Ripley	Date MAY 2016 Surveyed RPS Comp by DJL		
FB : TSC3	LB :		

Parish Local Authority		Job Ref 116052
DWG 116052 Sewer Mains		Reference 116052-85

RPS
© COPYRIGHT PROTECTS THIS PLAN
 Unauthorised reproduction or amendment
 not permitted. Please contact the author.

RPS Australia East Pty Ltd
 ACN 140 292 762
 ABN 44 140 292 762
 180 Brisbane Street
 PO Box 341
 Ipswich QLD 4305
 T +61 7 3437 2000
 F +61 7 3434 2099
 W rpsgroup.com.au