


REFER SHEET 1 FOR CONTINUATION

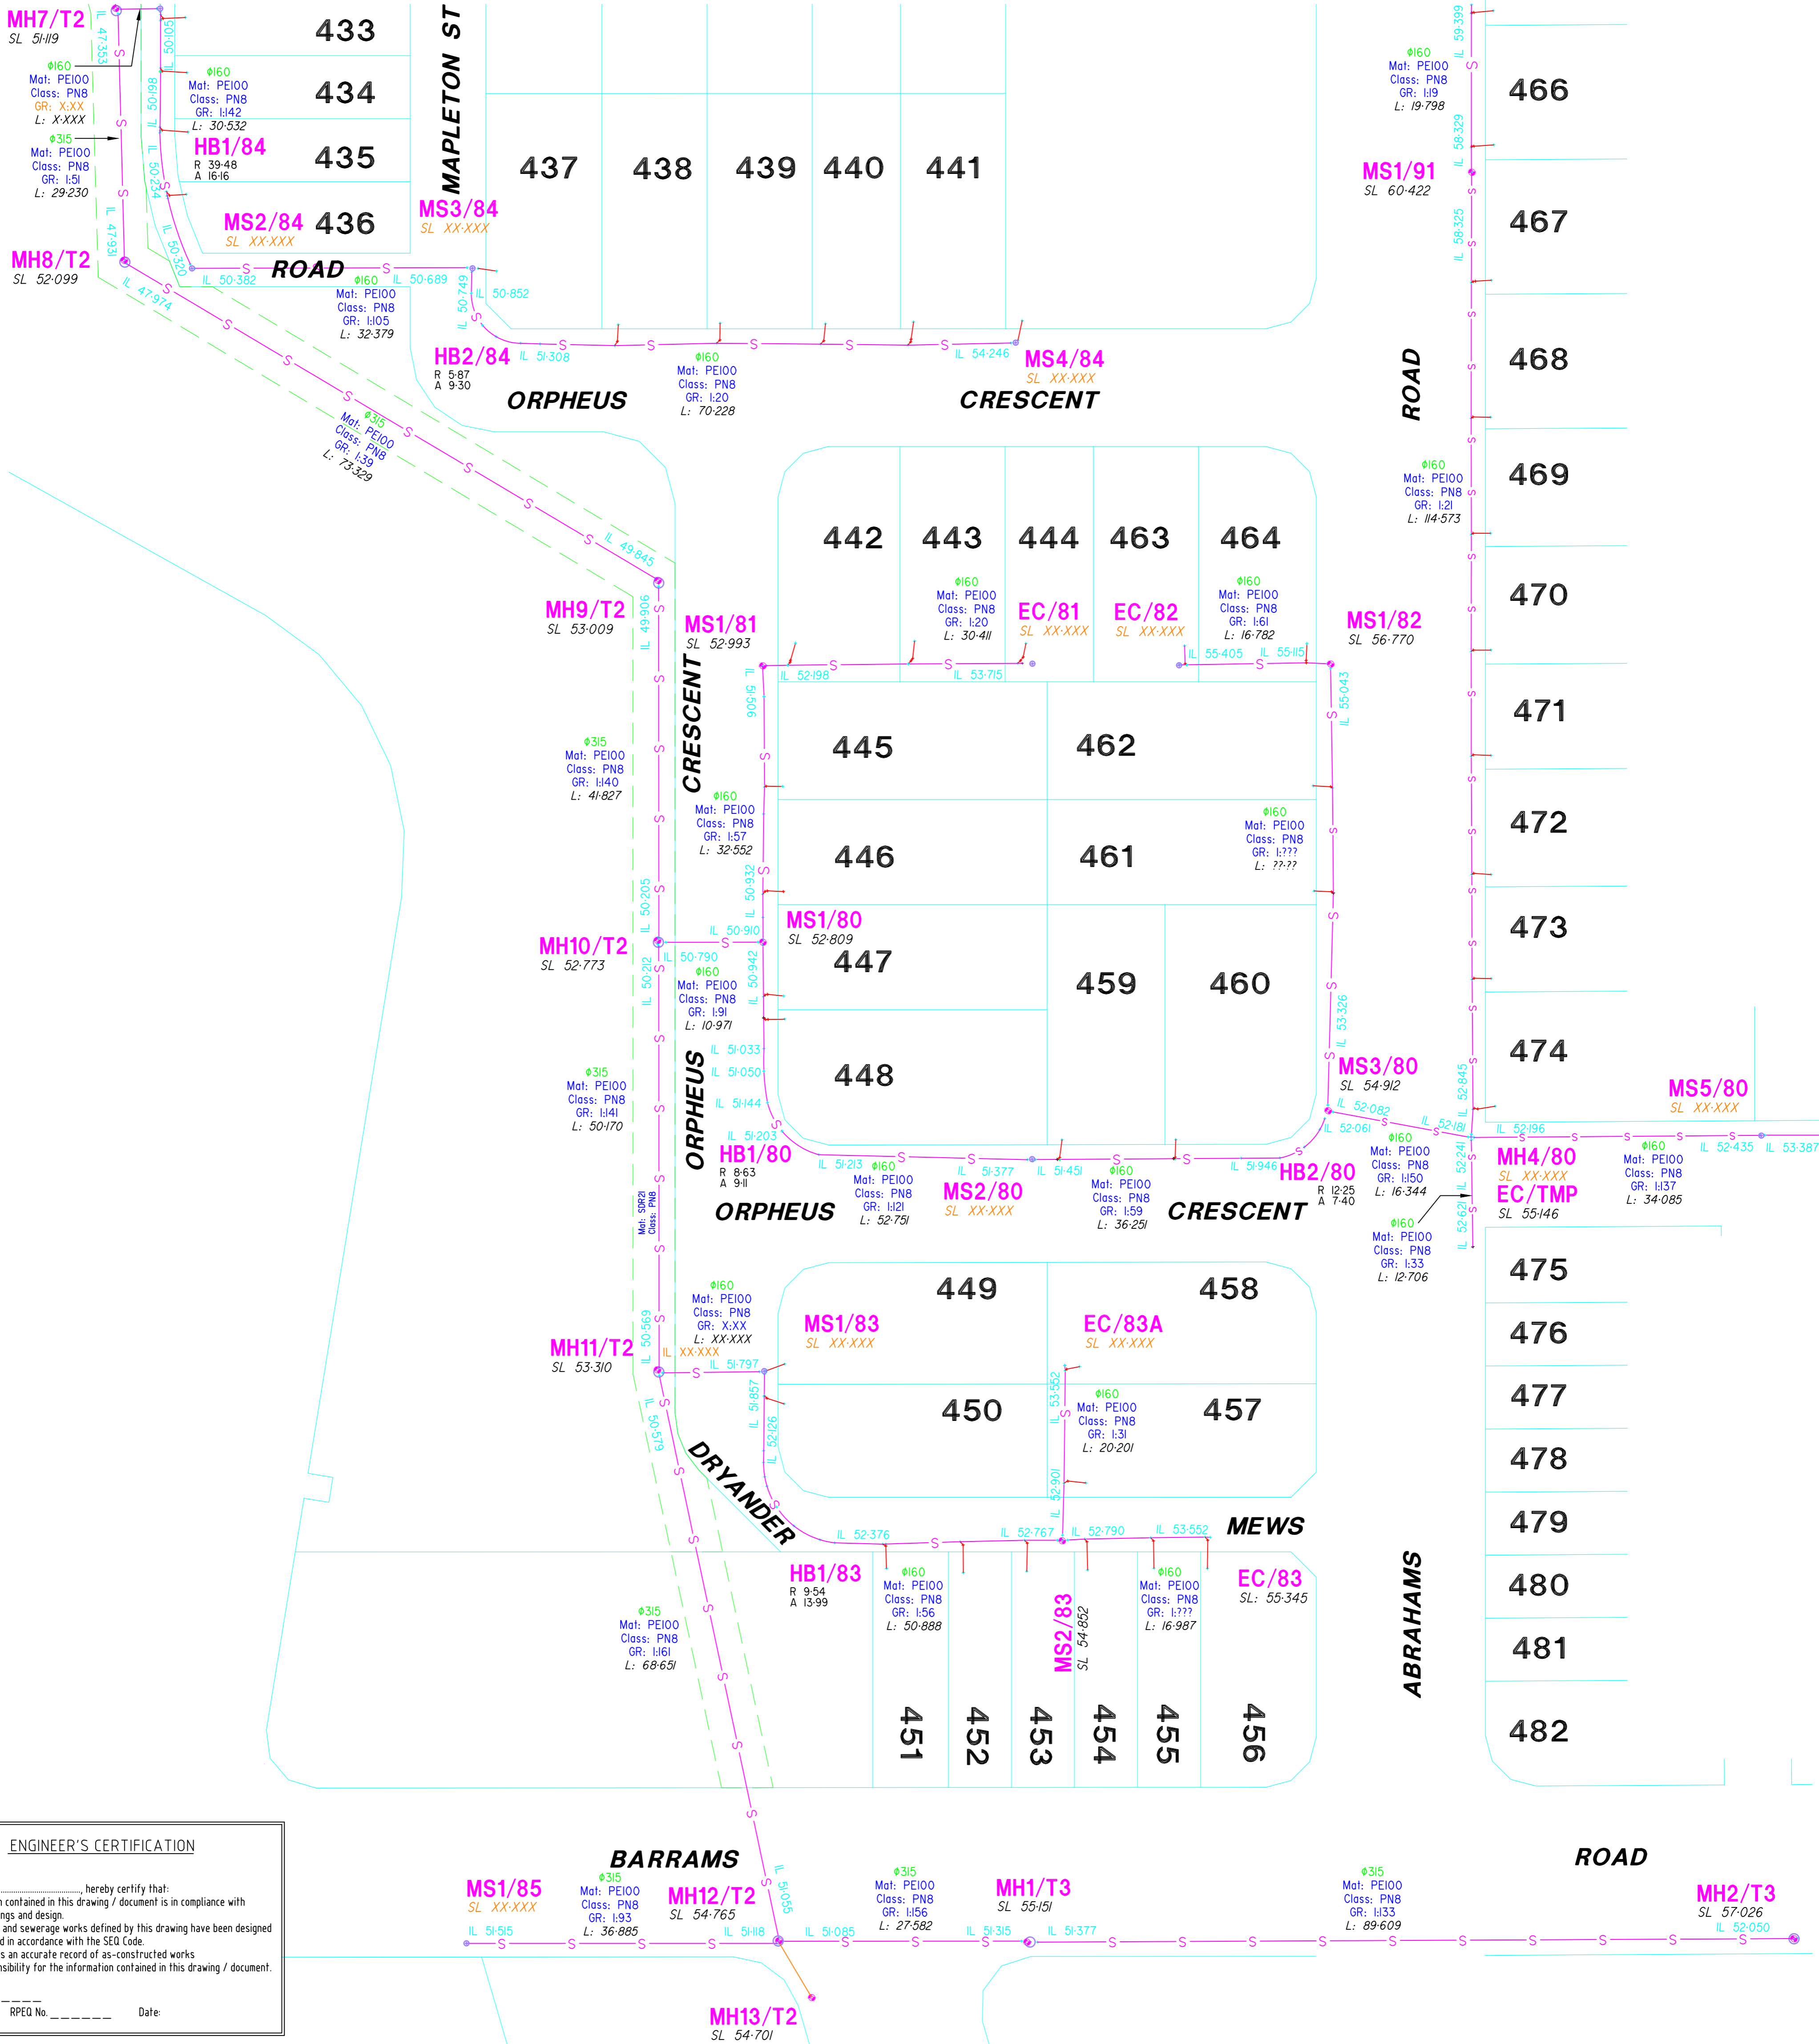

ENGINEER'S CERTIFICATION

I, _____, hereby certify that:



- The information contained in this drawing / document is in compliance with approved drawings and design.
- The new water and sewerage works defined by this drawing have been designed and constructed in accordance with the SEQ Code.
- This represents an accurate record of as-constructed works
- I accept responsibility for the information contained in this drawing / document.

RPEQ (signature) RPEQ No. _____ Date: _____

REGISTERED SURVEYOR'S CERTIFICATION

I, _____, hereby certify that the vertical and horizontal locations and dimensions shown on this plan are a true and correct record and were located by survey.

Registered Surveyor (sig.) Reg. Surveyor No. _____ Date: _____

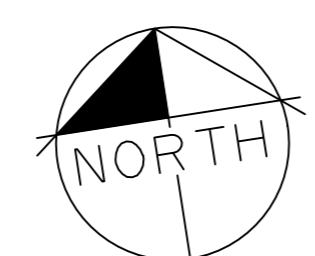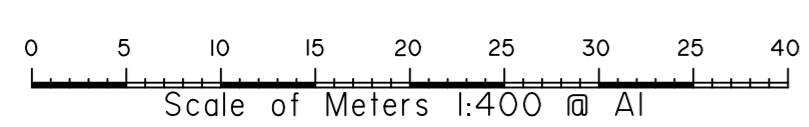

BUILDERS ISSUE

PROJECT Providence, Ripley		CLIENT AMEX CORP. PTY LTD	
LEVEL DATUM AHD	SCALE 1:400 @ A1	AS CONSTRUCTED SEWER RETICULATION MAIN STAGE 8B - SHEET 2	
ORIGIN OPM60301 RL 44-315 Barrams Rd Sth Ripley	Date JULY 2016 Surveyed RPS Comp by DJL		
FB : TSC3	LB :	Parish Local Authority IPSWICH CITY COUNCIL	Job Ref I16052-14

RPS

RPS Australia East Pty Ltd
ACN 140 292 762
ABN 44 140 292 762
180 Brisbane Street
PO Box 341
Ipswich QLD 4305
T +61 7 3437 2000
F +61 7 3434 2099
W rpsgroup.com.au

Reference 116052-103	Rev
--------------------------------	-----