


FINAL ISSUE

Coordinate System: Local Site
Horizontal Datum: GDA2014
Vertical Datum: AHD11

Scale of Meters 1:300




| | | | |
|---|----------------------------|--|----------------------|
| PROJECT <i>Providence, Ripley</i> | | CLIENT AMEX CORPORATION PTY LTD | |
| LEVEL DATUM AHD | SCALE 1:300 @ A1 | AS CONSTRUCTED | |
| ORIGIN OPM60301 RL 44.315 | Date SEP 2016 | WATER RETICULATION MAIN | |
| By Bartram Rd Sth Ripley | Drawn by RPS | STAGE 20 - SHEET 1 | |
| FR: TSC3 | AS: | Part of Local Authority | IPSWICH CITY COUNCIL |
| DATE 116052 Water 21-Mat | Job Ref 116052 | REFERENCE 116052-147 | |
| | | RPS Australia East Pty Ltd ACN 140 282 782 ABN 140 282 782 100 Brisbane Street Ipswich QLD 4305 T +61 7 3434 2000 F +61 7 3434 2099 W rpsgroup.com.au | |

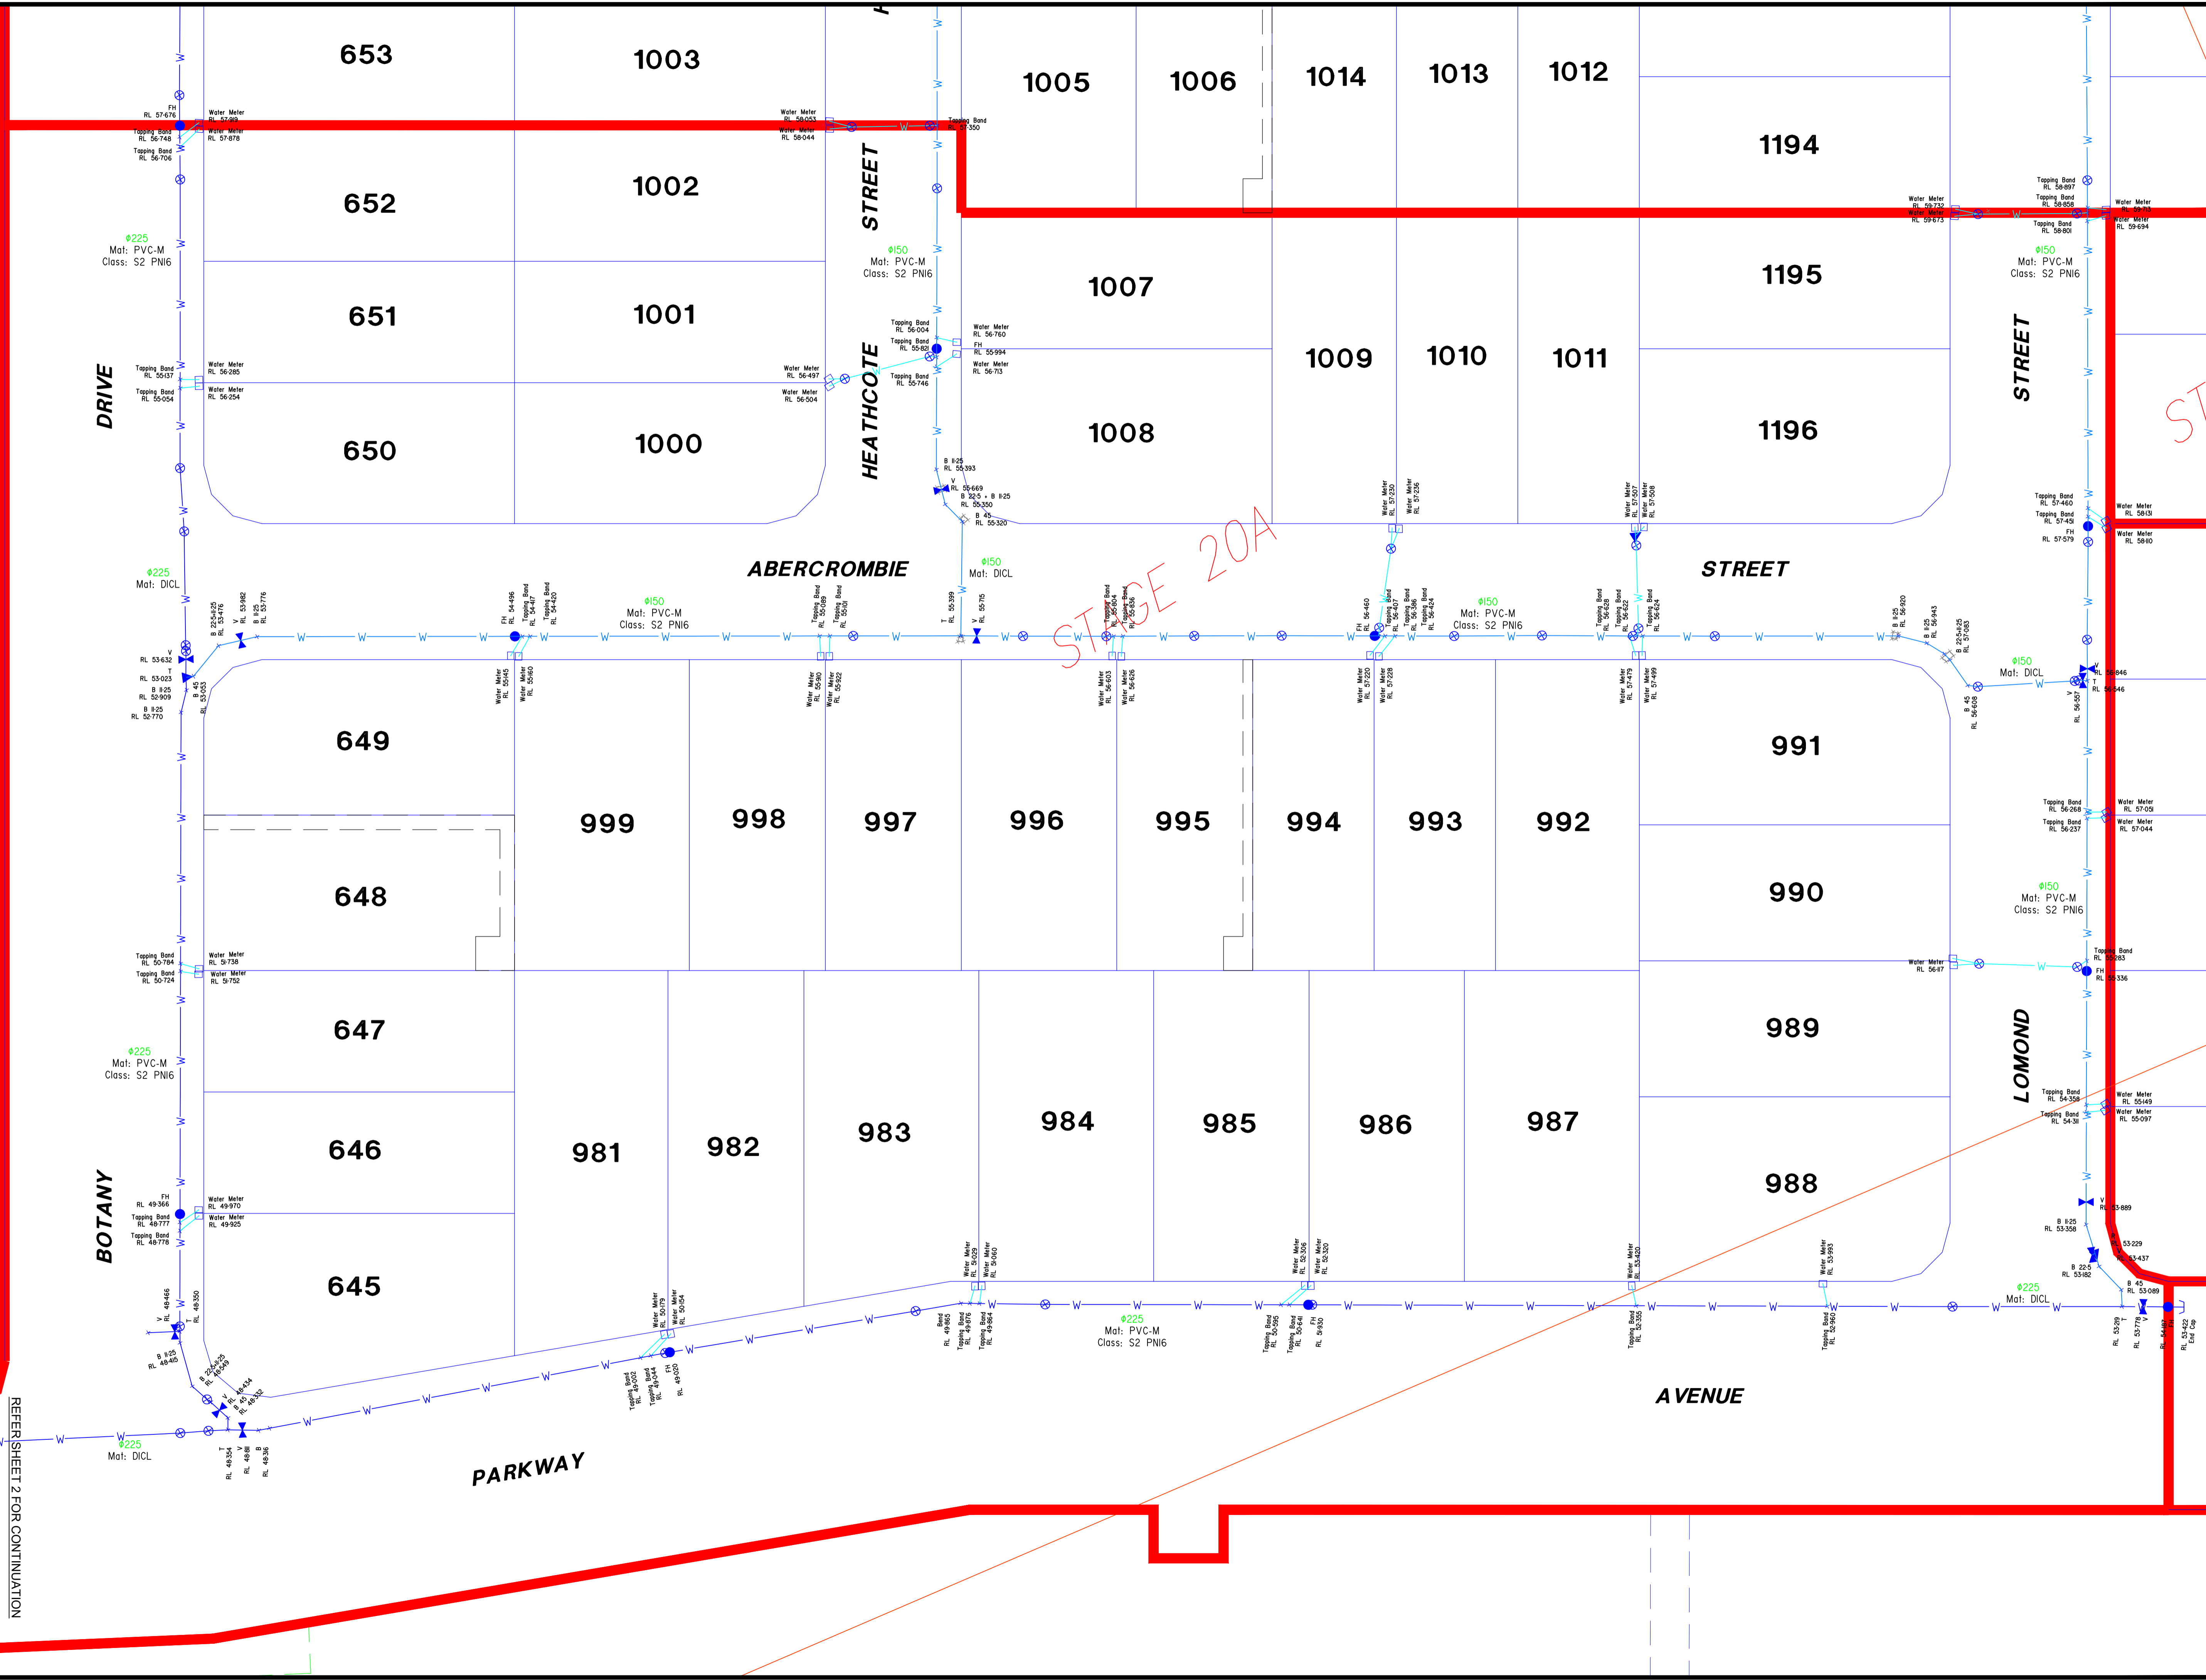

REFER SHEET 2 FOR CONTINUATION

REFER SHEET 1 FOR CONTINUATION

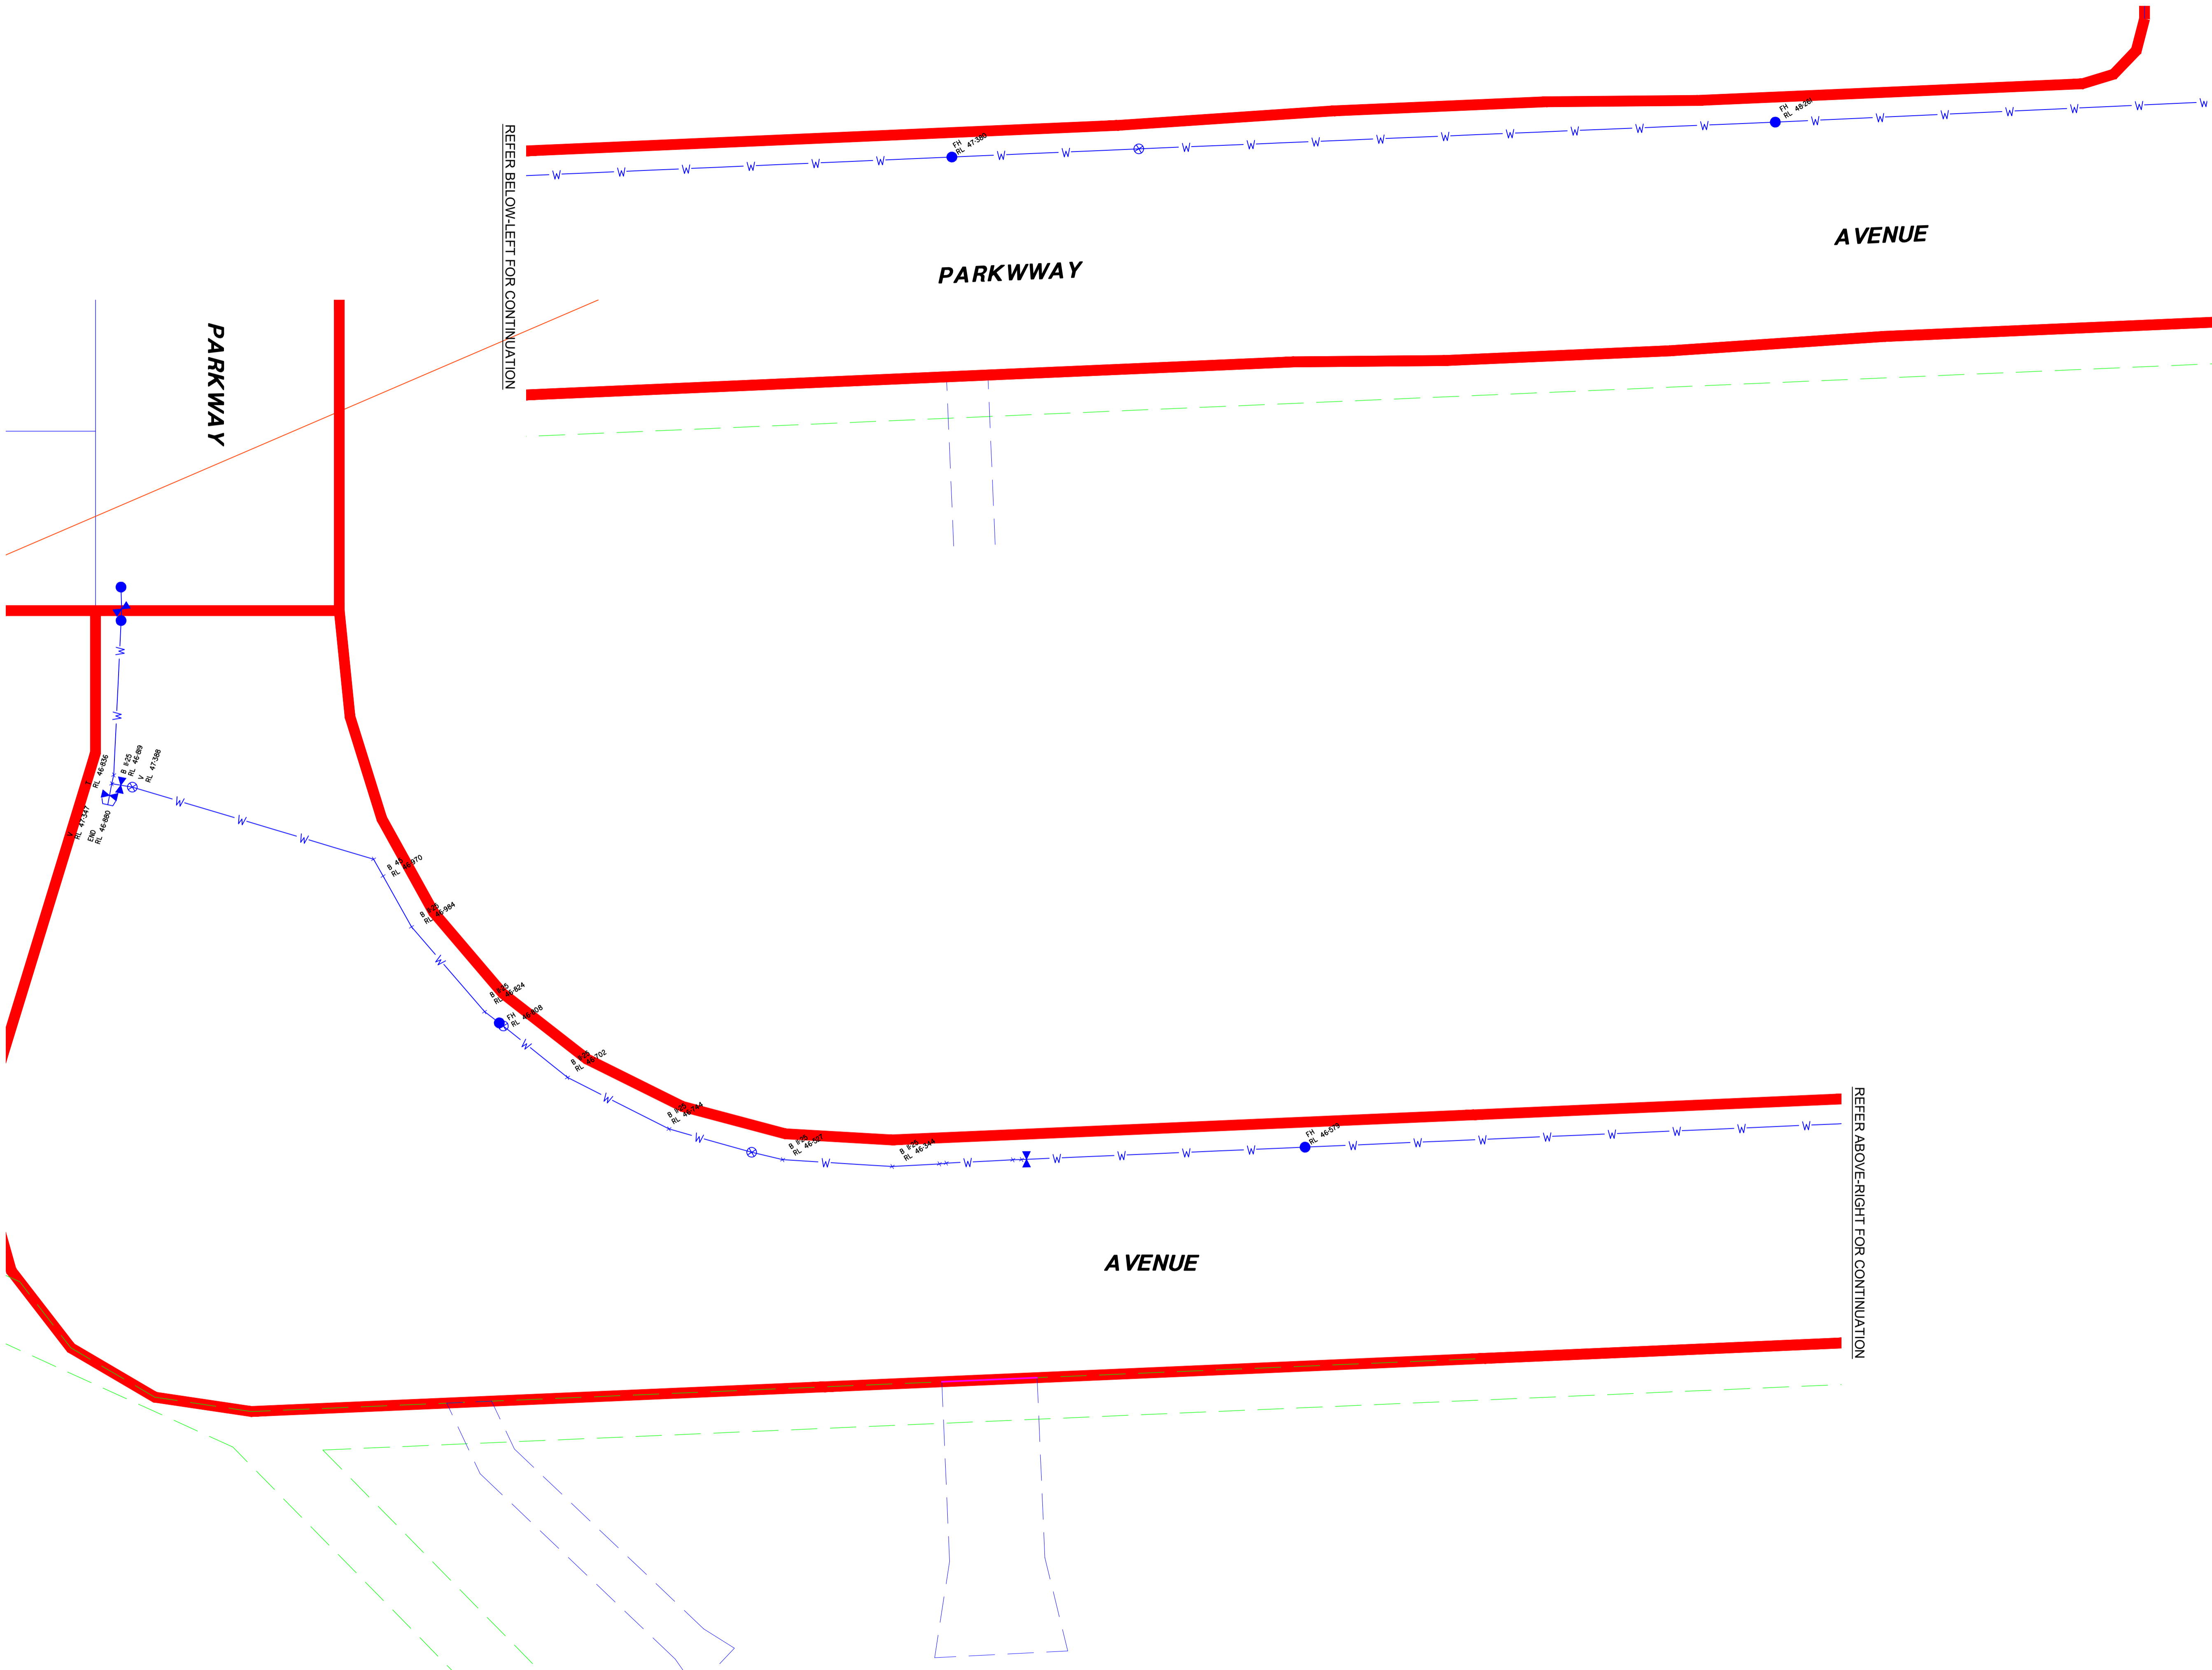

REFER BELOW-LEFT FOR CONTINUATION

REFER ABOVE-RIGHT FOR CONTINUATION

AVENUE

PARKWAY

AVENUE

PARKWAY

SURVEY DATUM
 Coordinate System: Local Site
 Horizontal Datum: GDA84
 Vertical Datum: AHD71



FINAL ISSUE



| | | | |
|--------------------------------------|-------------------------------|---|--|
| PROJECT Providence, Ripley | | CLIENT AMEX CORPORATION PTY LTD | |
| LEVEL DATUM AHD | SCALE 1:300 @ A1 | AS CONSTRUCTED WATER RETICULATION MAIN STAGE 20 - SHEET 2 | |
| ORIGIN OPM60301 RL 44.315 | DATE SEP 2016 | JOB REF 116052 | |
| BY Burrams Rd Sth Ripley | CONV BY DLI | JOB REF 116052 | |
| FR: TSC3 | DATE 116052 Water-21-Water | JOB REF 116052 | |




© COPYRIGHT HOLDERS THIS PLAN
 IS UNREGISTERED. Please contact the owner
 for permission to reproduce this plan.

RPS Australia East Pty Ltd
 ACN 140 292 782
 ABN 44 140 292 782
 100 Brisbane Street
 Ipswich QLD 4305
 T +61 7 3437 2000
 F +61 7 3434 2099
 W rpsgroup.com.au

Reference
 116052-147

Rev

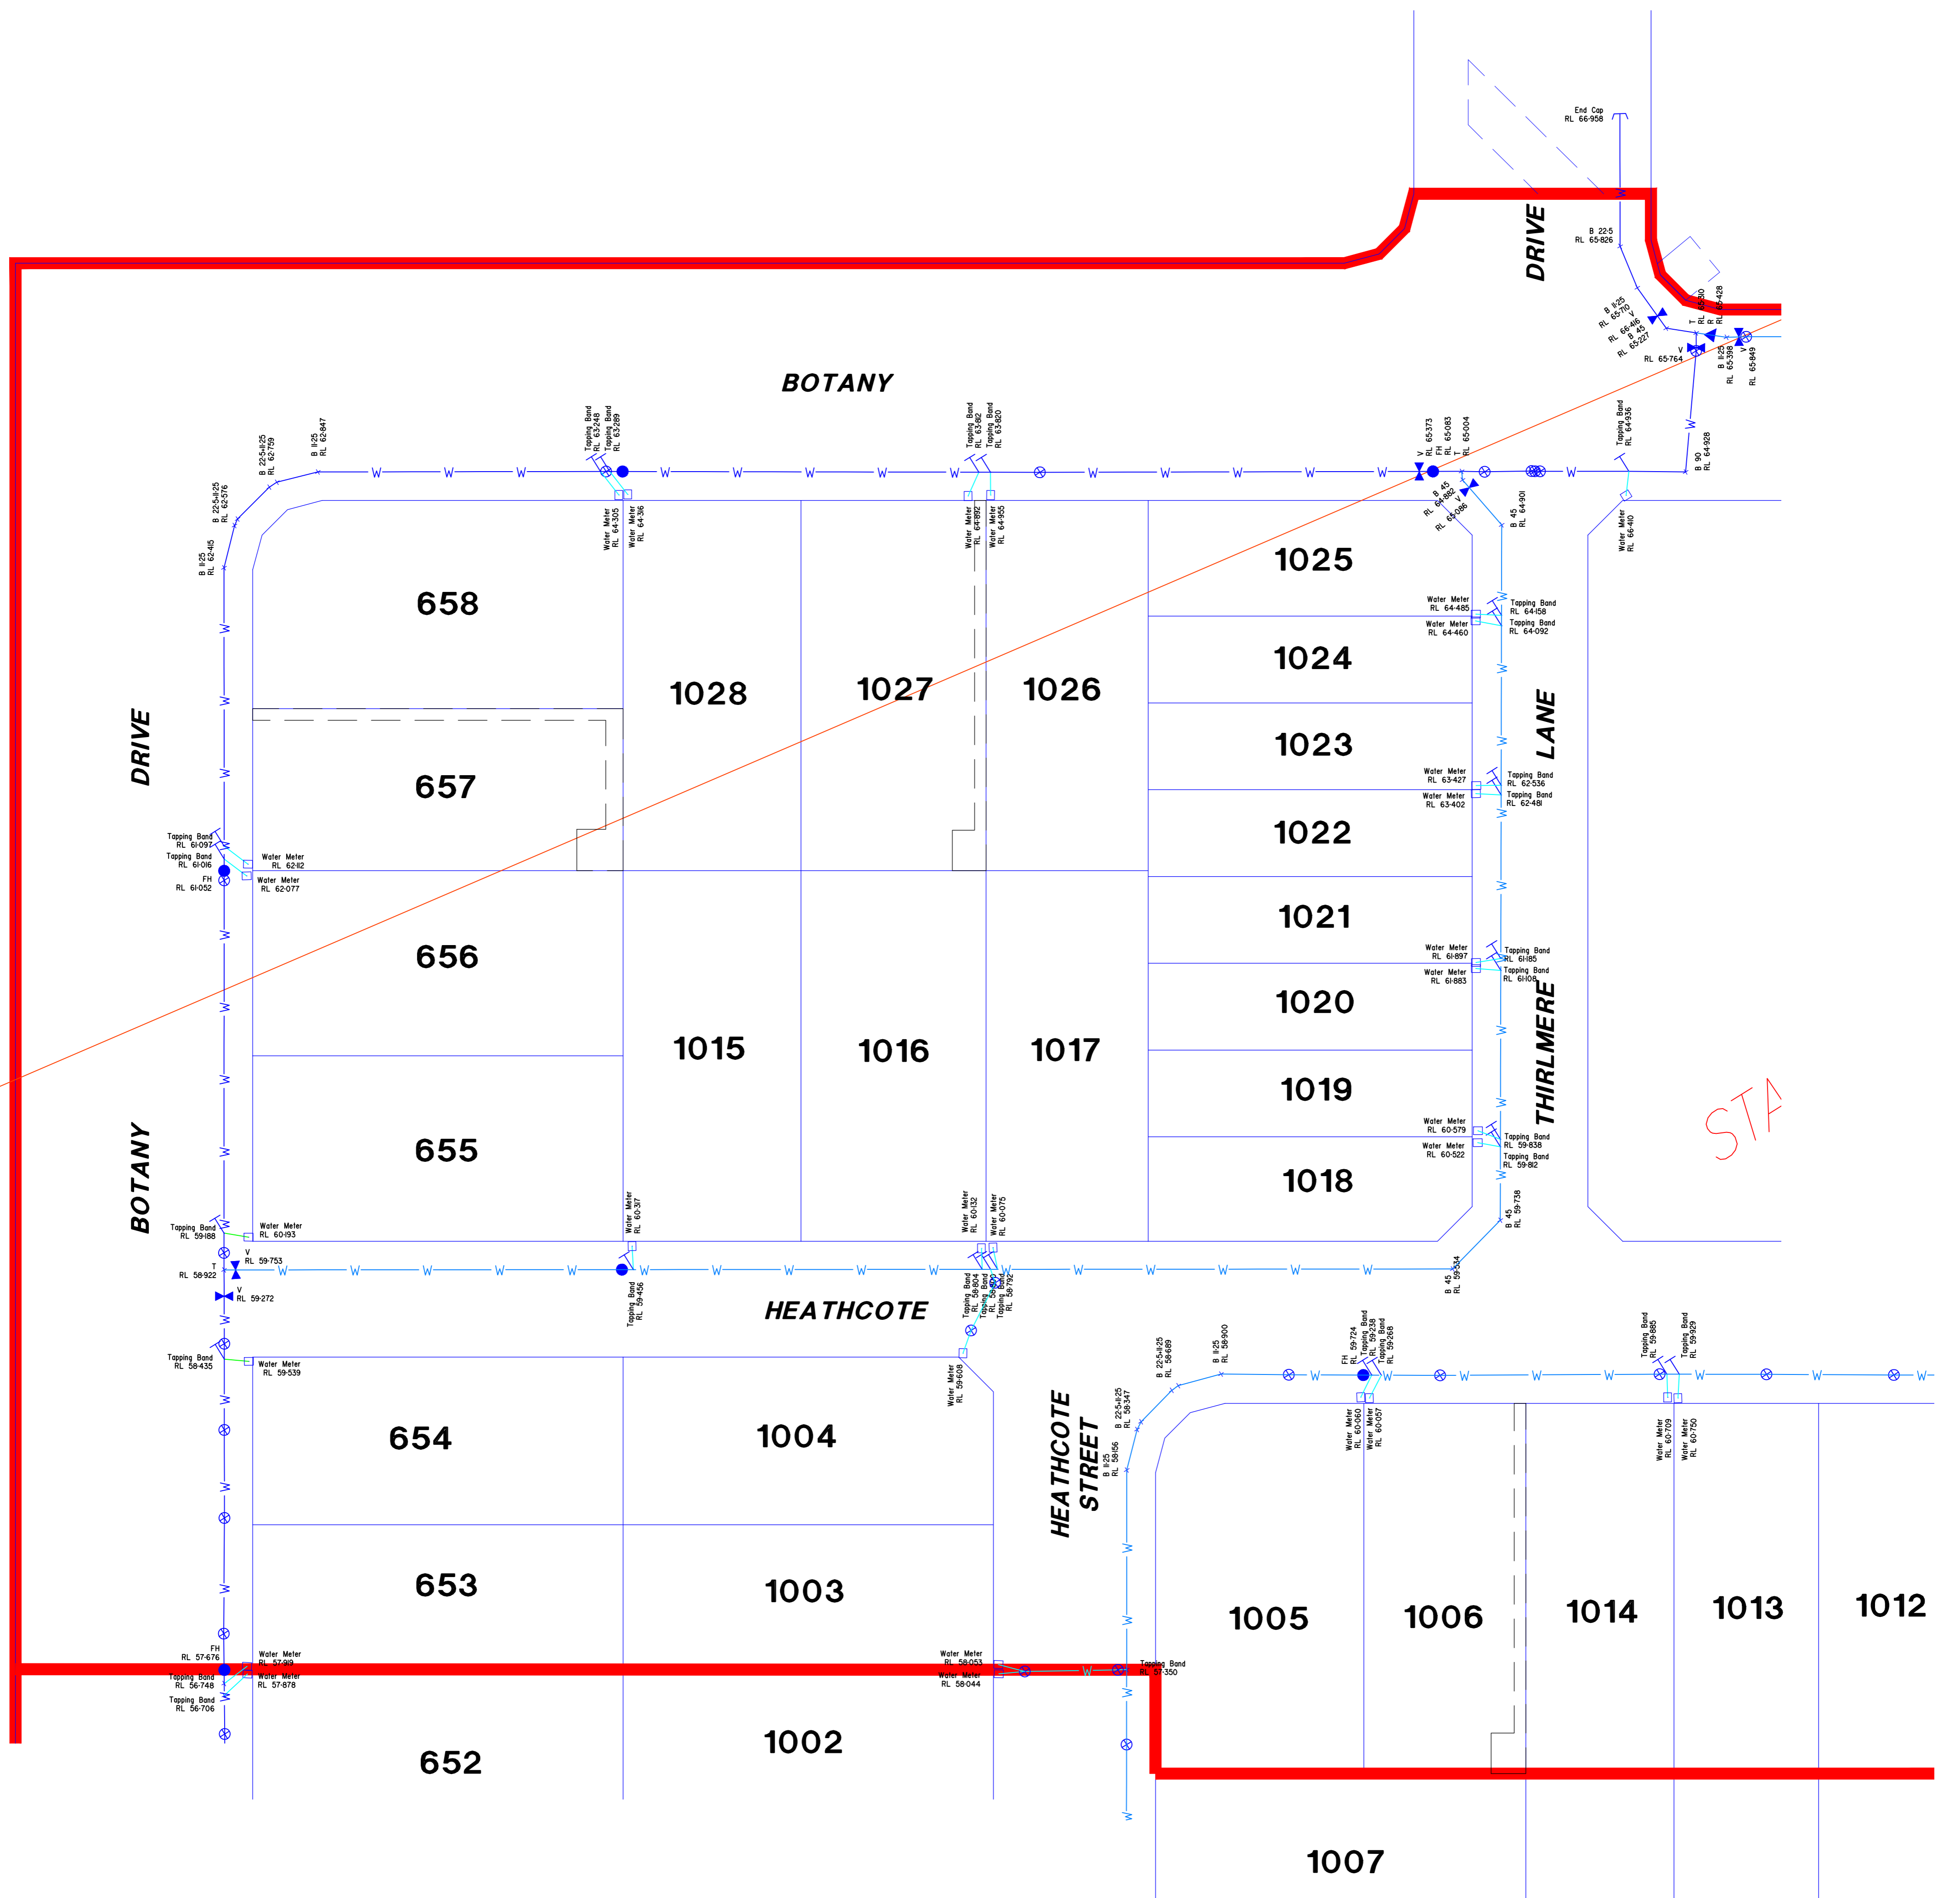


REFER SHEET 2 FOR CONTINUATION

SURVEY DATUM

Coordinate System: Local Site
Horizontal Azimuth: GDA94
Vertical Datum: AHD71

FINAL ISSUE

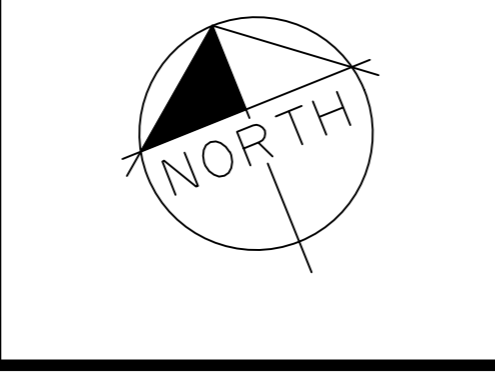

| | | | |
|--|--|--|-------------------|
| PROJECT <i>Providence, Ripley</i> | | CLIENT AMEX CORPORATION PTY LTD | |
| LEVEL DATUM AHD | SCALE 1:300 @ A1 | AS CONSTRUCTED WATER RETICULATION MAIN STAGE 21 - SHEET 1 | |
| ORIGIN OPM60301 RL 44.315 Barrams Rd Sth Ripley | Date JULY 2016 Surveyed RPS Comp by DJL | | |
| FB: TSC3 | LB: | Parish | Job Ref 116052 |
| DWG 116052 Water-21-Wat | | Local Authority IPSWICH CITY COUNCIL | |


RPS

©COPYRIGHT PROTECTS THIS PLAN
Unauthorised reproduction or amendment
not permitted. Please contact the author.

RPS Australia East Pty Ltd
ACN 140 292 762
ABN 44 140 292 762
180 Brisbane Street
PO Box 341
Ipswich QLD 4305
T +61 7 3437 2000
F +61 7 3434 2099
W rpsgroup.com.au

Reference
116052-148

Rev

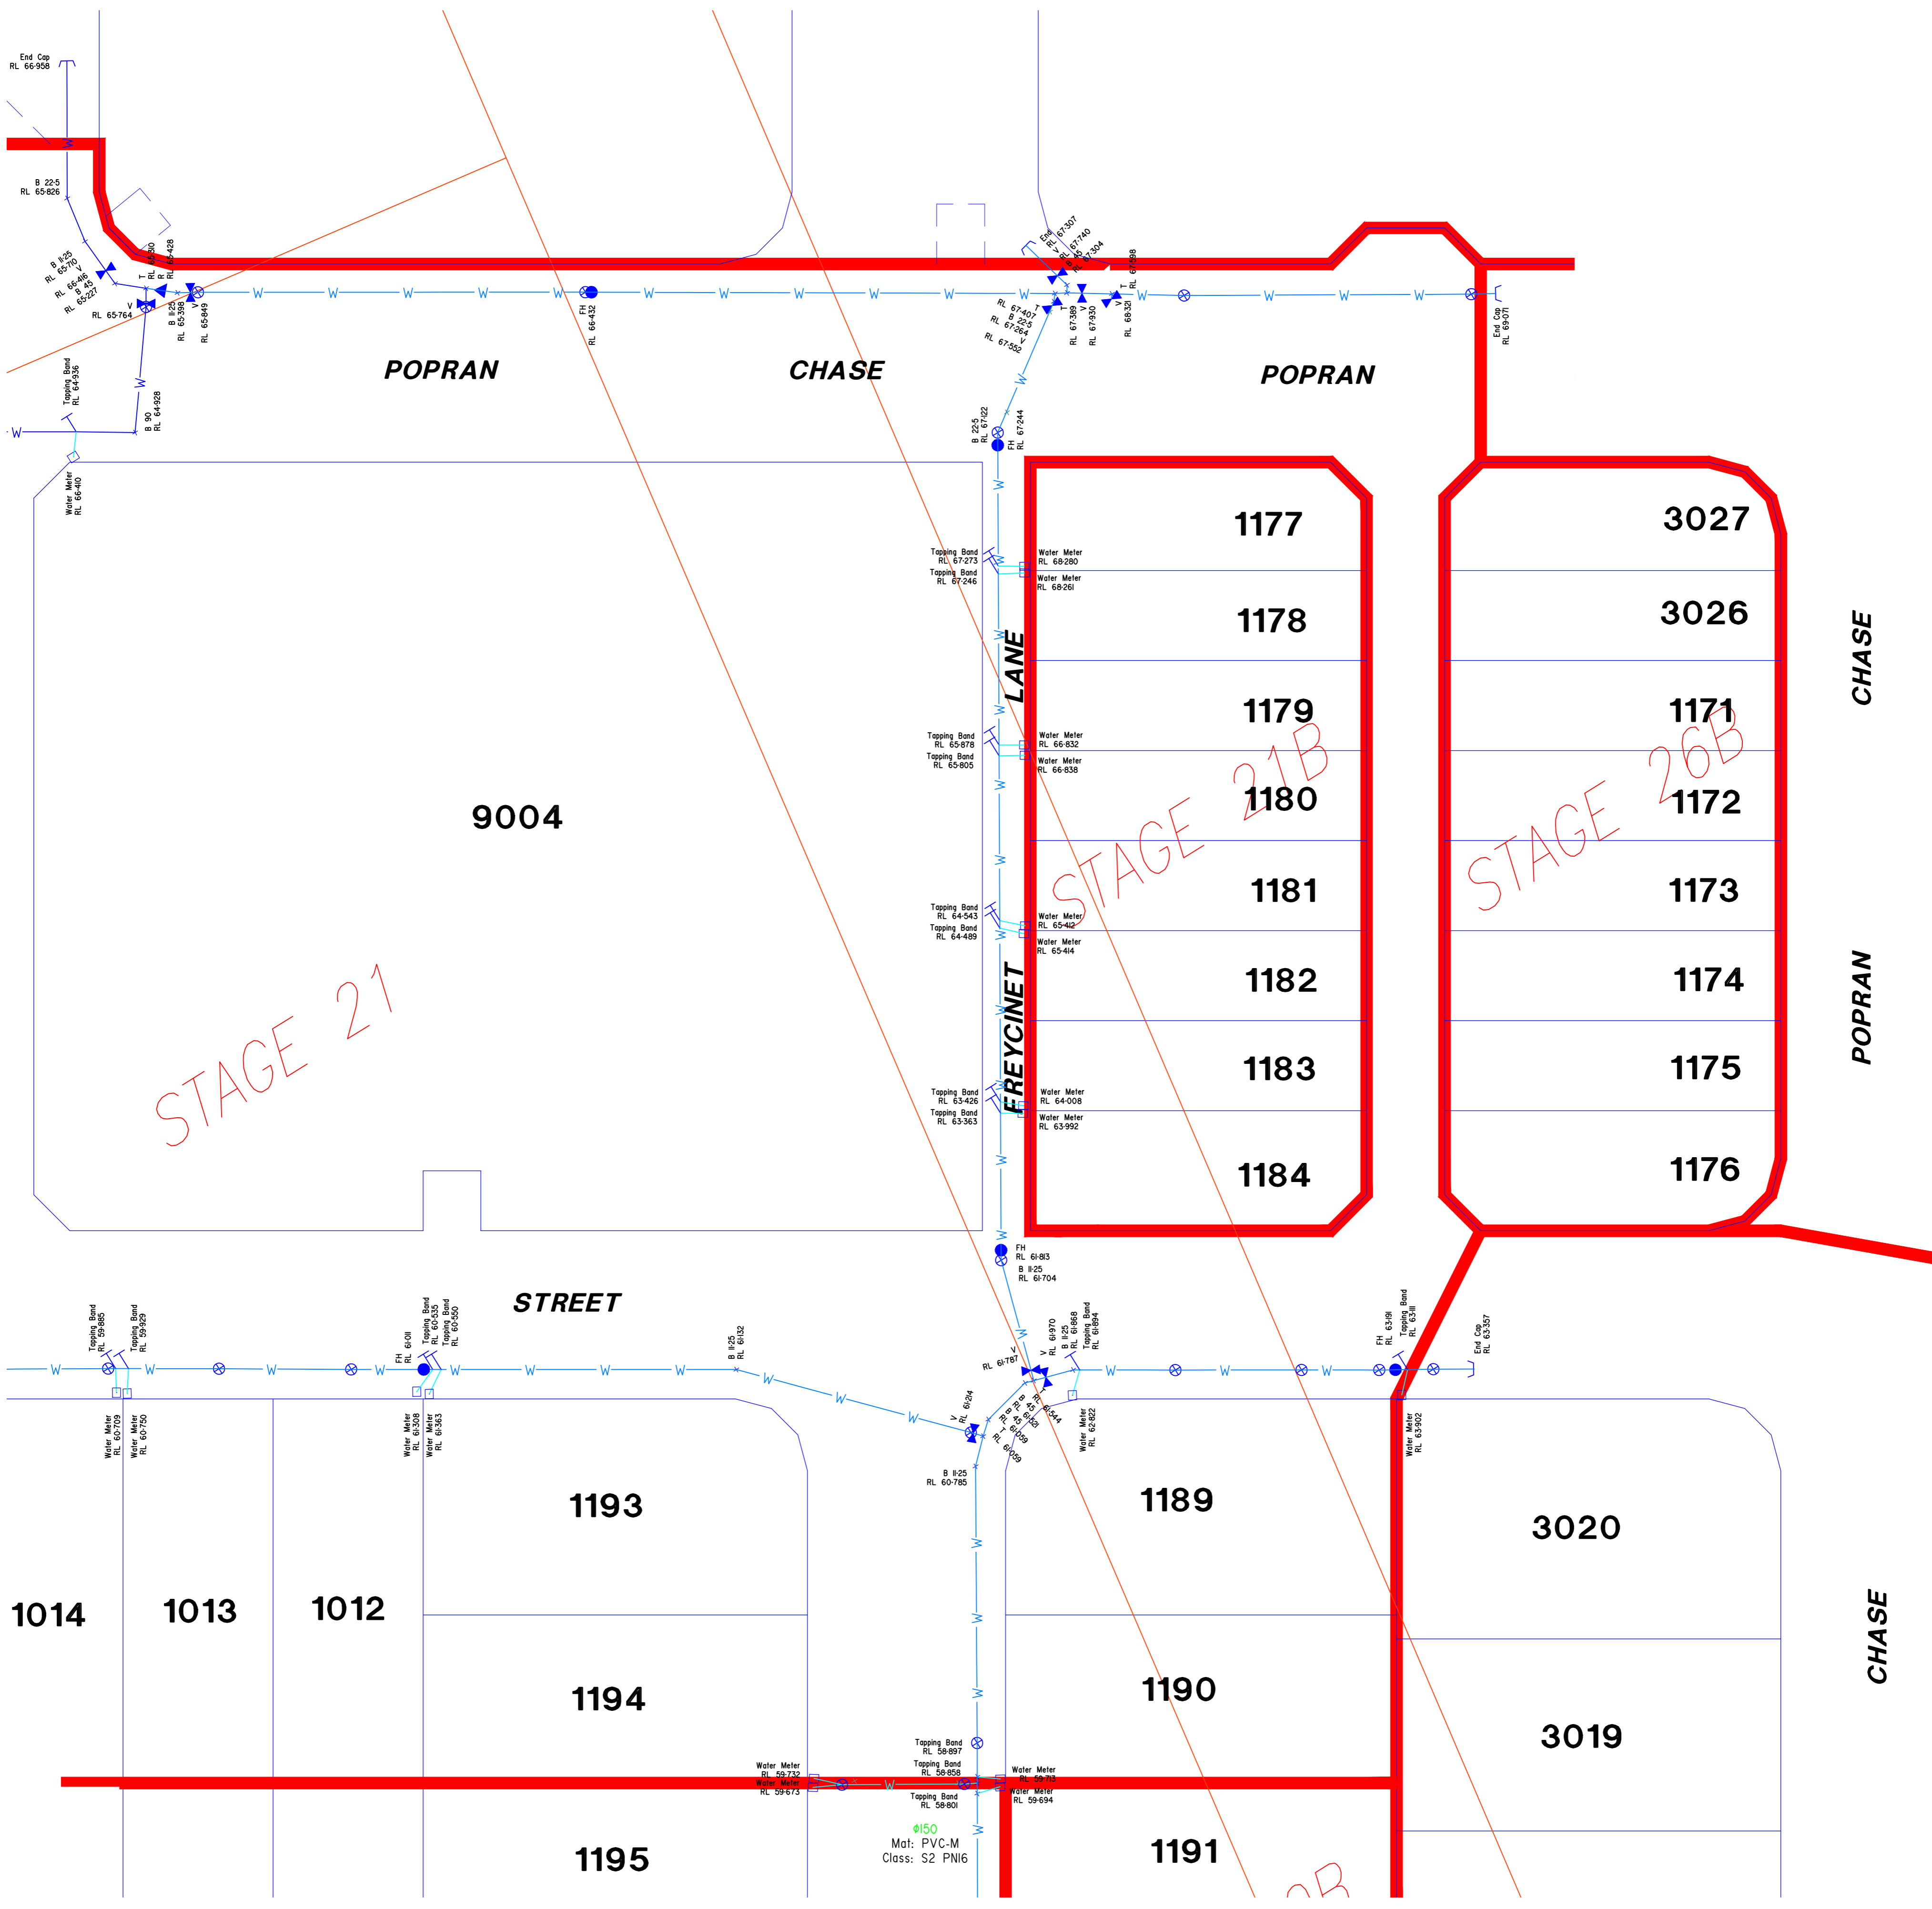


REFER SHEET 1 FOR CONTINUATION

SURVEY DATUM

Coordinate System: Local Site.
Horizontal Azimuth: GDA94
Vertical Datum: AHD71

FINAL ISSUE

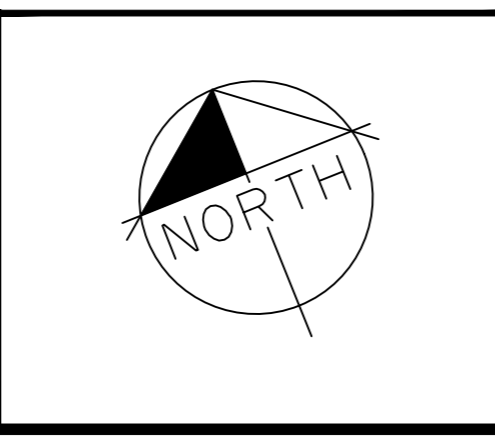

| | | | |
|--|--|--|---|
| PROJECT <i>Providence, Ripley</i> | | CLIENT AMEX CORPORATION PTY LTD | |
| LEVEL DATUM AHD | SCALE 1:300 @ A1 | AS CONSTRUCTED WATER RETICULATION MAIN STAGE 21 - SHEET 2 | |
| ORIGIN OPM60301 RL 44.315 Barrams Rd Sth Ripley | Date JULY 2016 Surveyed RPS Comp by DJL | | |
| FB: TSC3 | LB: | DWG 116052 Water-21-Wat | Parish Local Authority IPSWICH CITY COUNCIL |

| |
|-------------------|
| Job Ref 116052 |
|-------------------|

RPS

©COPYRIGHT PROTECTS THIS PLAN
Unauthorized reproduction or amendment
not permitted. Please contact the author.

RPS Australia East Pty Ltd
ACN 140 292 762
ABN 44 140 292 762
180 Brisbane Street
PO Box 341
Ipswich QLD 4305
T +61 7 3437 2000
F +61 7 3434 2099
W rpsgroup.com.au

Reference
116052-148

Rev