


**LEGEND**

- House Connection
- Sewer Line
- Lot Boundary
- Stage Boundary
- Manhole / Maintenance Structure



**ABBREVIATIONS - House Connection**

- CH Chainage of Obtuse Bend (Distance from Downstream Invert Level)
- SL Surveyed Surface Level (at House Connection)
- LGTH House Connection Length (Horizontal Length)
- IL Invert Level of House Connection
- OS Offset of house Connection IL from line
- IO Distance along pipe from inspection opening to Downstream IL

**Stage 26B**

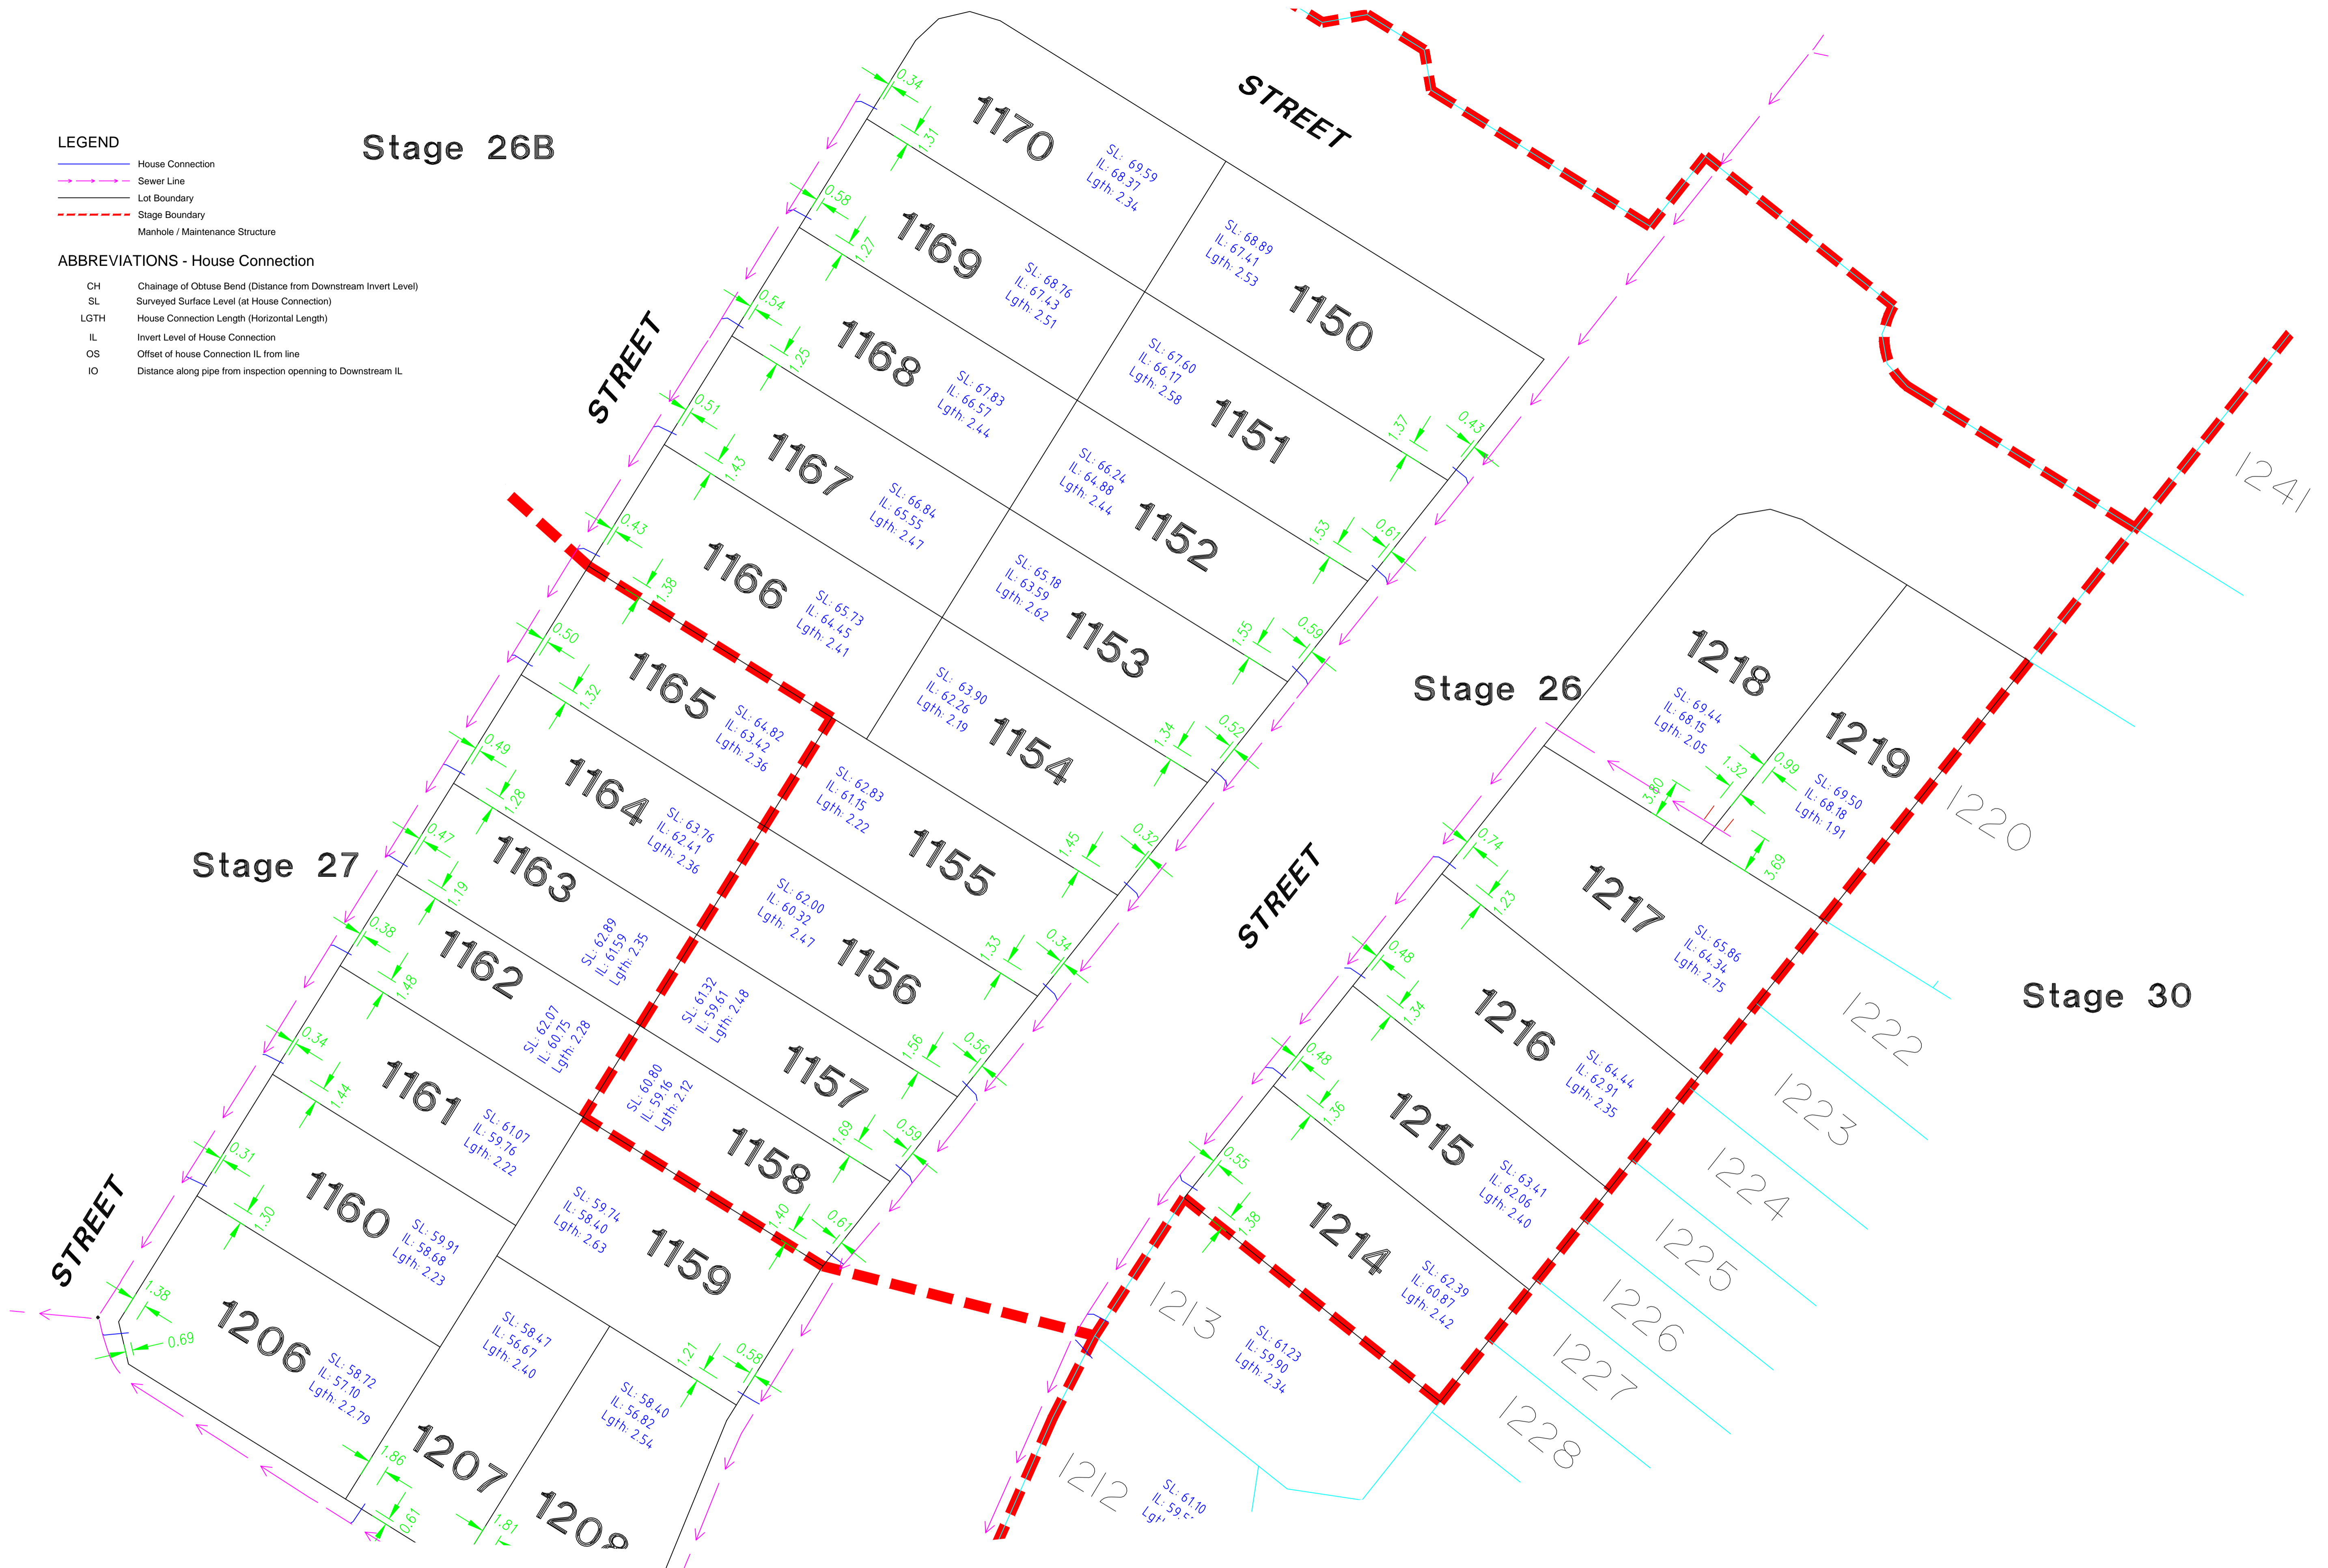

Issue	Description	Date
Original	Original Builders issue	31/01/2017
Original	LOT 1218 & 1219 HC	06/03/2017

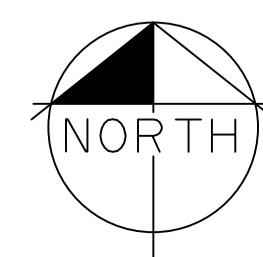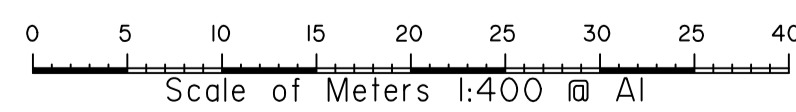

**BUILDERS ISSUE**

<b>PROJECT</b> Providence, Ripley	
LEVEL DATUM AHD	SCALE <b>1:300 @ A1</b>
ORIGIN OPM6030I RL 44-315 Barrams Rd Sth Ripley	Date JANUARY 2017
Comp by BR	Surveyed RPS
FB : TSC3 LB :	DWG I16052 Sewer House

<b>CLIENT</b> AMEX CORP. PTY LTD	
<b>AS CONSTRUCTED</b> SEWER RETICULATION MAIN STAGE 26	
Parish	Job Ref I16052-
Local Authority IPSWICH CITY COUNCIL	



© COPYRIGHT PROTECTS THIS PLAN  
Unauthorized reproduction or amendment  
not permitted. Please contact the author.

RPS Australia East Pty Ltd  
ACN 140 292 762  
ABN 44 140 292 762  
180 Brisbane Street  
PO Box 341  
Ipswich QLD 4305  
T +61 7 3437 2000  
F +61 7 3434 2099  
W rpsgroup.com.au

Reference <b>116052-</b>	Rev
-----------------------------	-----