


LEGEND
 - Sewer Line
 - Lot Boundary
 - Stage Boundary
 - Manhole / Maintenance Structure

ABBREVIATIONS - Sewer Main

Mat Material
 DSIL Down stream invert level
 USIL Up stream invert level
 SL Surface level
 LGTH Length of pipe from Manhole to Mahole



Issue	Description	Date
Original	Original Builders issue	31/01/2017

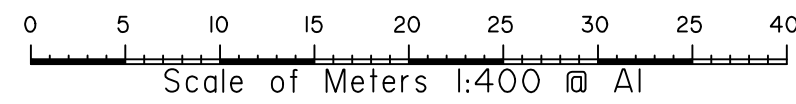

BUILDERS ISSUE

PROJECT Providence, Ripley	
LEVEL DATUM AHD	SCALE 1:300 @ A1
ORIGIN OPM60301 RL 44-315 Barrams Rd Sth Ripley	Date JANUARY 2017
FB : TSC3 LB :	Surveyed RPS
	Comp by BR
	DWG I16052 Sewer Mains

CLIENT AMEX CORP. PTY LTD	
AS CONSTRUCTED SEWER RETICULATION MAIN STAGE 26	
Parish	Job Ref
Local Authority IPSWICH CITY COUNCIL	I16052-

RPS
 RPS Australia East Pty Ltd
 ACN 140 292 762
 ABN 44 140 292 762
 180 Brisbane Street
 PO Box 541
 Ipswich QLD 4305
 T +61 7 3437 2000
 F +61 7 3434 2099
 W rpsgroup.com.au

©COPYRIGHT PROTECTS THIS PLAN
 Unauthorised reproduction or amendment
 not permitted. Please contact the author.

Reference 116052-	Rev
-----------------------------	-----