


LEGEND



- Sewer Line
- Lot Boundary
- Stage Boundary
- Manhole / Maintenance Structure

ABBREVIATIONS - Sewer Main

- Mat Material
- DSIL Down stream invert level
- USIL Up stream invert level
- SL Surface level
- LGTH Length of pipe from Manhole to Mahole

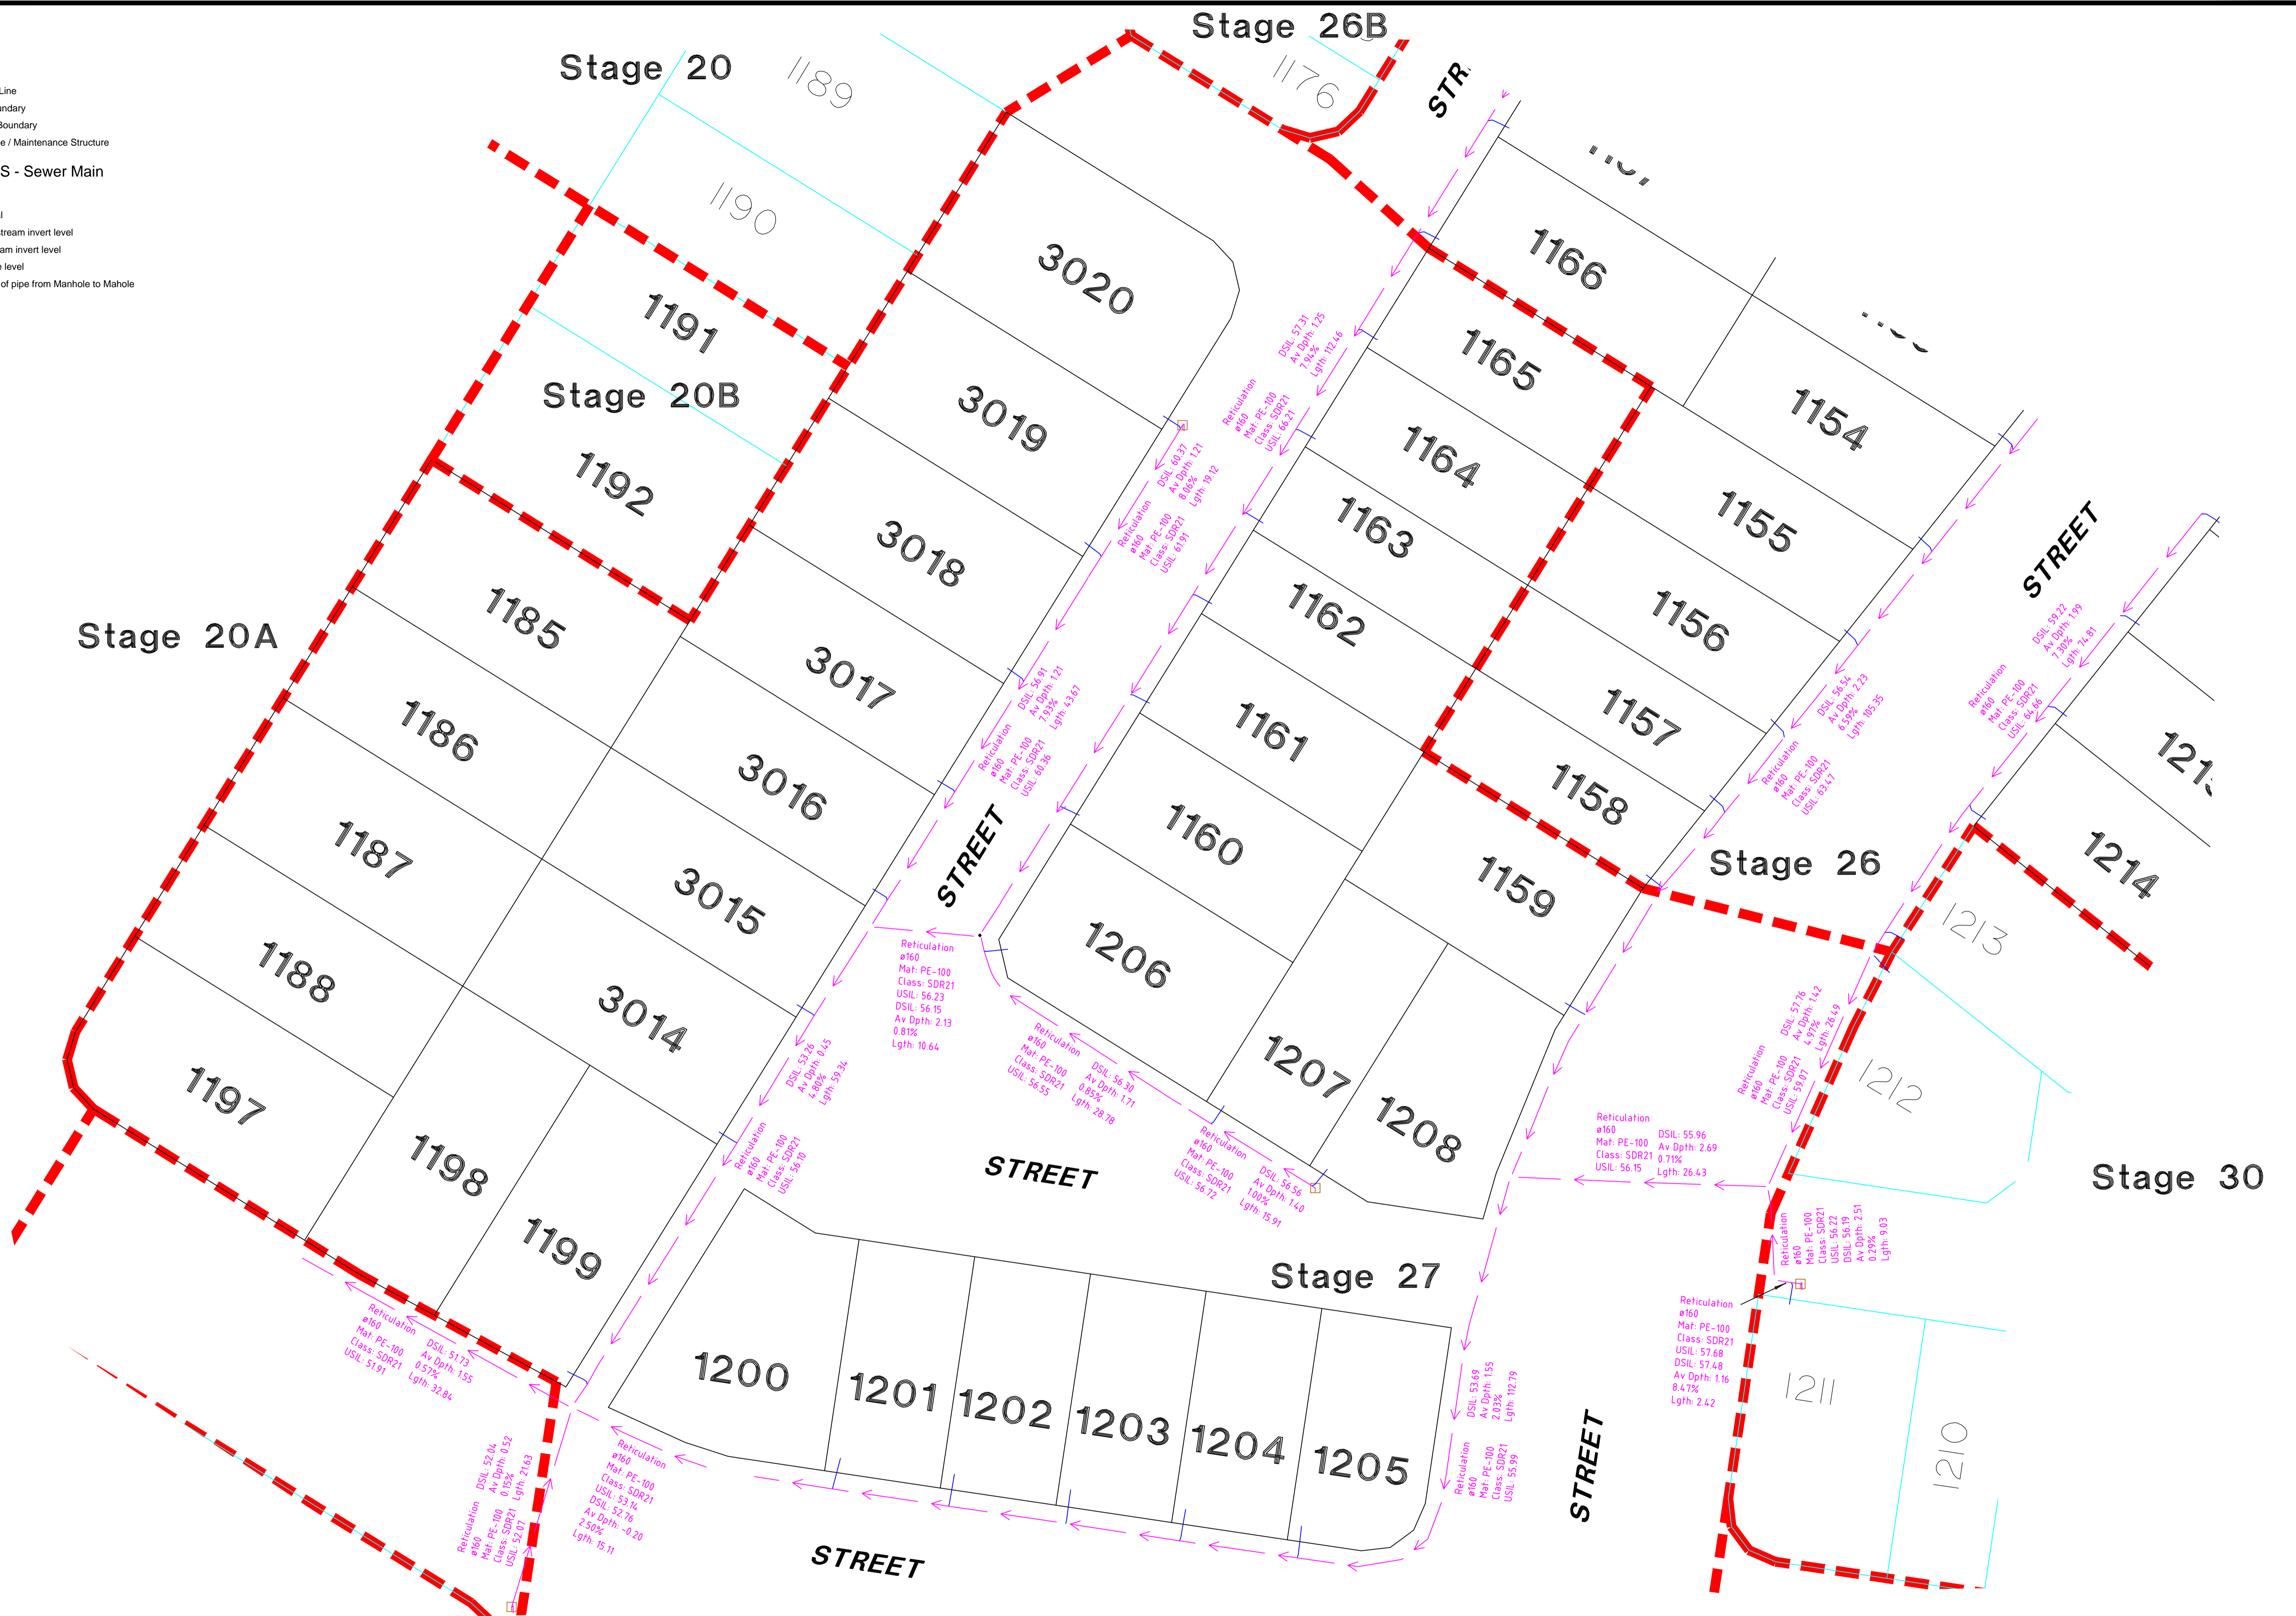

Issue	Description	Date
Original	Original Builders Issue	31/01/2017

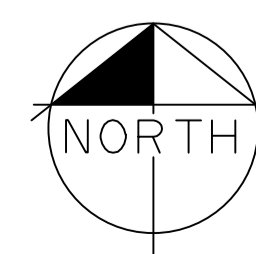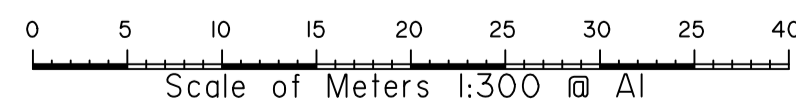

BUILDERS ISSUE

PROJECT <i>Providence, Ripley</i>	
LEVEL DATUM AHD	SCALE 1:300 @ A1
ORIGIN OPM6030I RL 44-315 Barrams Rd Sth Ripley	Date JANUARY 2017
FB : LB :	Surveyed RPS
DWG I16052 Sewer Mains	Comp by BR

CLIENT AMEX CORP. PTY LTD	
AS CONSTRUCTED SEWER RETICULATION MAIN STAGE 27	
Parish	Job Ref
Local Authority IPSWICH CITY COUNCIL	I16052-



© COPYRIGHT PROTECTS THIS PLAN
Unauthorized reproduction or amendment
not permitted. Please contact the author.

RPS Australia East Pty Ltd
ACN 140 292 762
ABN 44 140 292 762
180 Brisbane Street
PO Box 541
Ipswich QLD 4305
T +61 7 3437 2000
F +61 7 3434 2099
W rpsgroup.com.au

Reference 116052-	Rev
-----------------------------	-----