
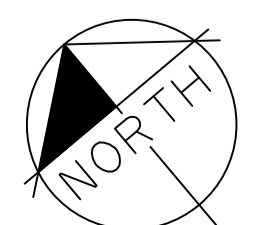


LEGEND

- House Connection
- Sewer Line
- Lot Boundary
- Stage Boundary
- Manhole / Maintenance Structure

ABBREVIATIONS - House Connection

- CH Chainage of Obtuse Bend (Distance from Downstream Invert Level)
- SL Surveyed Surface Level (at House Connection)
- LGTH House Connection Length (Horizontal Length)
- IL Invert Level of House Connection
- OS Offset of house Connection IL from line
- IO Distance along pipe from inspection opening to Downstream IL

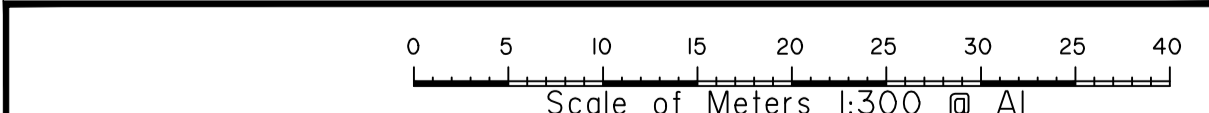

BUILDERS ISSUE

| | |
|--|----------------------------|
| PROJECT Providence, Ripley | |
| LEVEL DATUM AHD | SCALE 1:300 @ A1 |
| ORIGIN OPM60301 RL 44-315 Barrams Rd Sth Ripley | Date DECEMBER 2016 |
| FB : TSC3 LB : | Surveyed RPS |
| | Comp by BR |
| | DWG I16052 Sewer House |

| | |
|---|-----------|
| CLIENT AMEX CORP. PTY LTD | |
| AS CONSTRUCTED | |
| SEWER HOUSE CONNECTIONS | |
| STAGE 16A | |
| Parish | Job Ref |
| Local Authority IPSWICH CITY COUNCIL | I16052-32 |

RPS Australia East Pty Ltd
ACN 140 292 762
ABN 44 140 292 762
180 Brisbane Street
PO Box 341
Ipswich QLD 4305
T +61 7 3437 2000
F +61 7 3434 2099
W rpsgroup.com.au

© COPYRIGHT PROTECTS THIS PLAN
Unauthorized reproduction or amendment
not permitted. Please contact the author.

| | |
|-----------------------------|-----|
| Reference 116052- | Rev |
|-----------------------------|-----|