
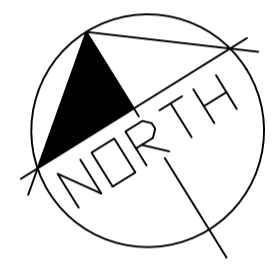


BUILDERS ISSUE


Coordinate System: Local Site
Horizontal Datum: GDA94
Vertical Datum: AH171

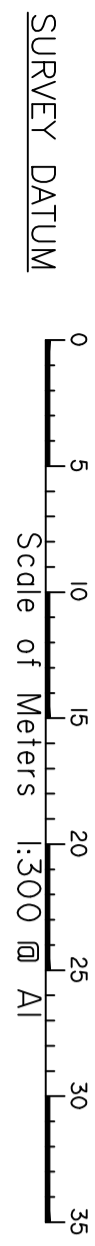

PROJECT		Providence, Ripley	
LEVEL DATUM	SCALE	ORIGIN	DATE
AHD	1:300 @ A1	OPM60301	AUGUST 2016
RD: 44315	Drawn by: SJP	Rev: 1	Checked by: SJP
Client: AMEX CORP. PTY LTD	As Constructed	Stormwater House Connections	Stage 20 - Sheet 1
Job Ref: 116052	Local Authority: IPSWICH CITY COUNCIL		

RPS
RPS Australia East Pty Ltd
ACN 140 282 782
ABN 54 140 282 782
PO Box 999
Ipswich QLD 4305
T: +61 7 3438 2000
F: +61 7 3438 2099
W: rpsgroup.com.au

Reference: 116052-119

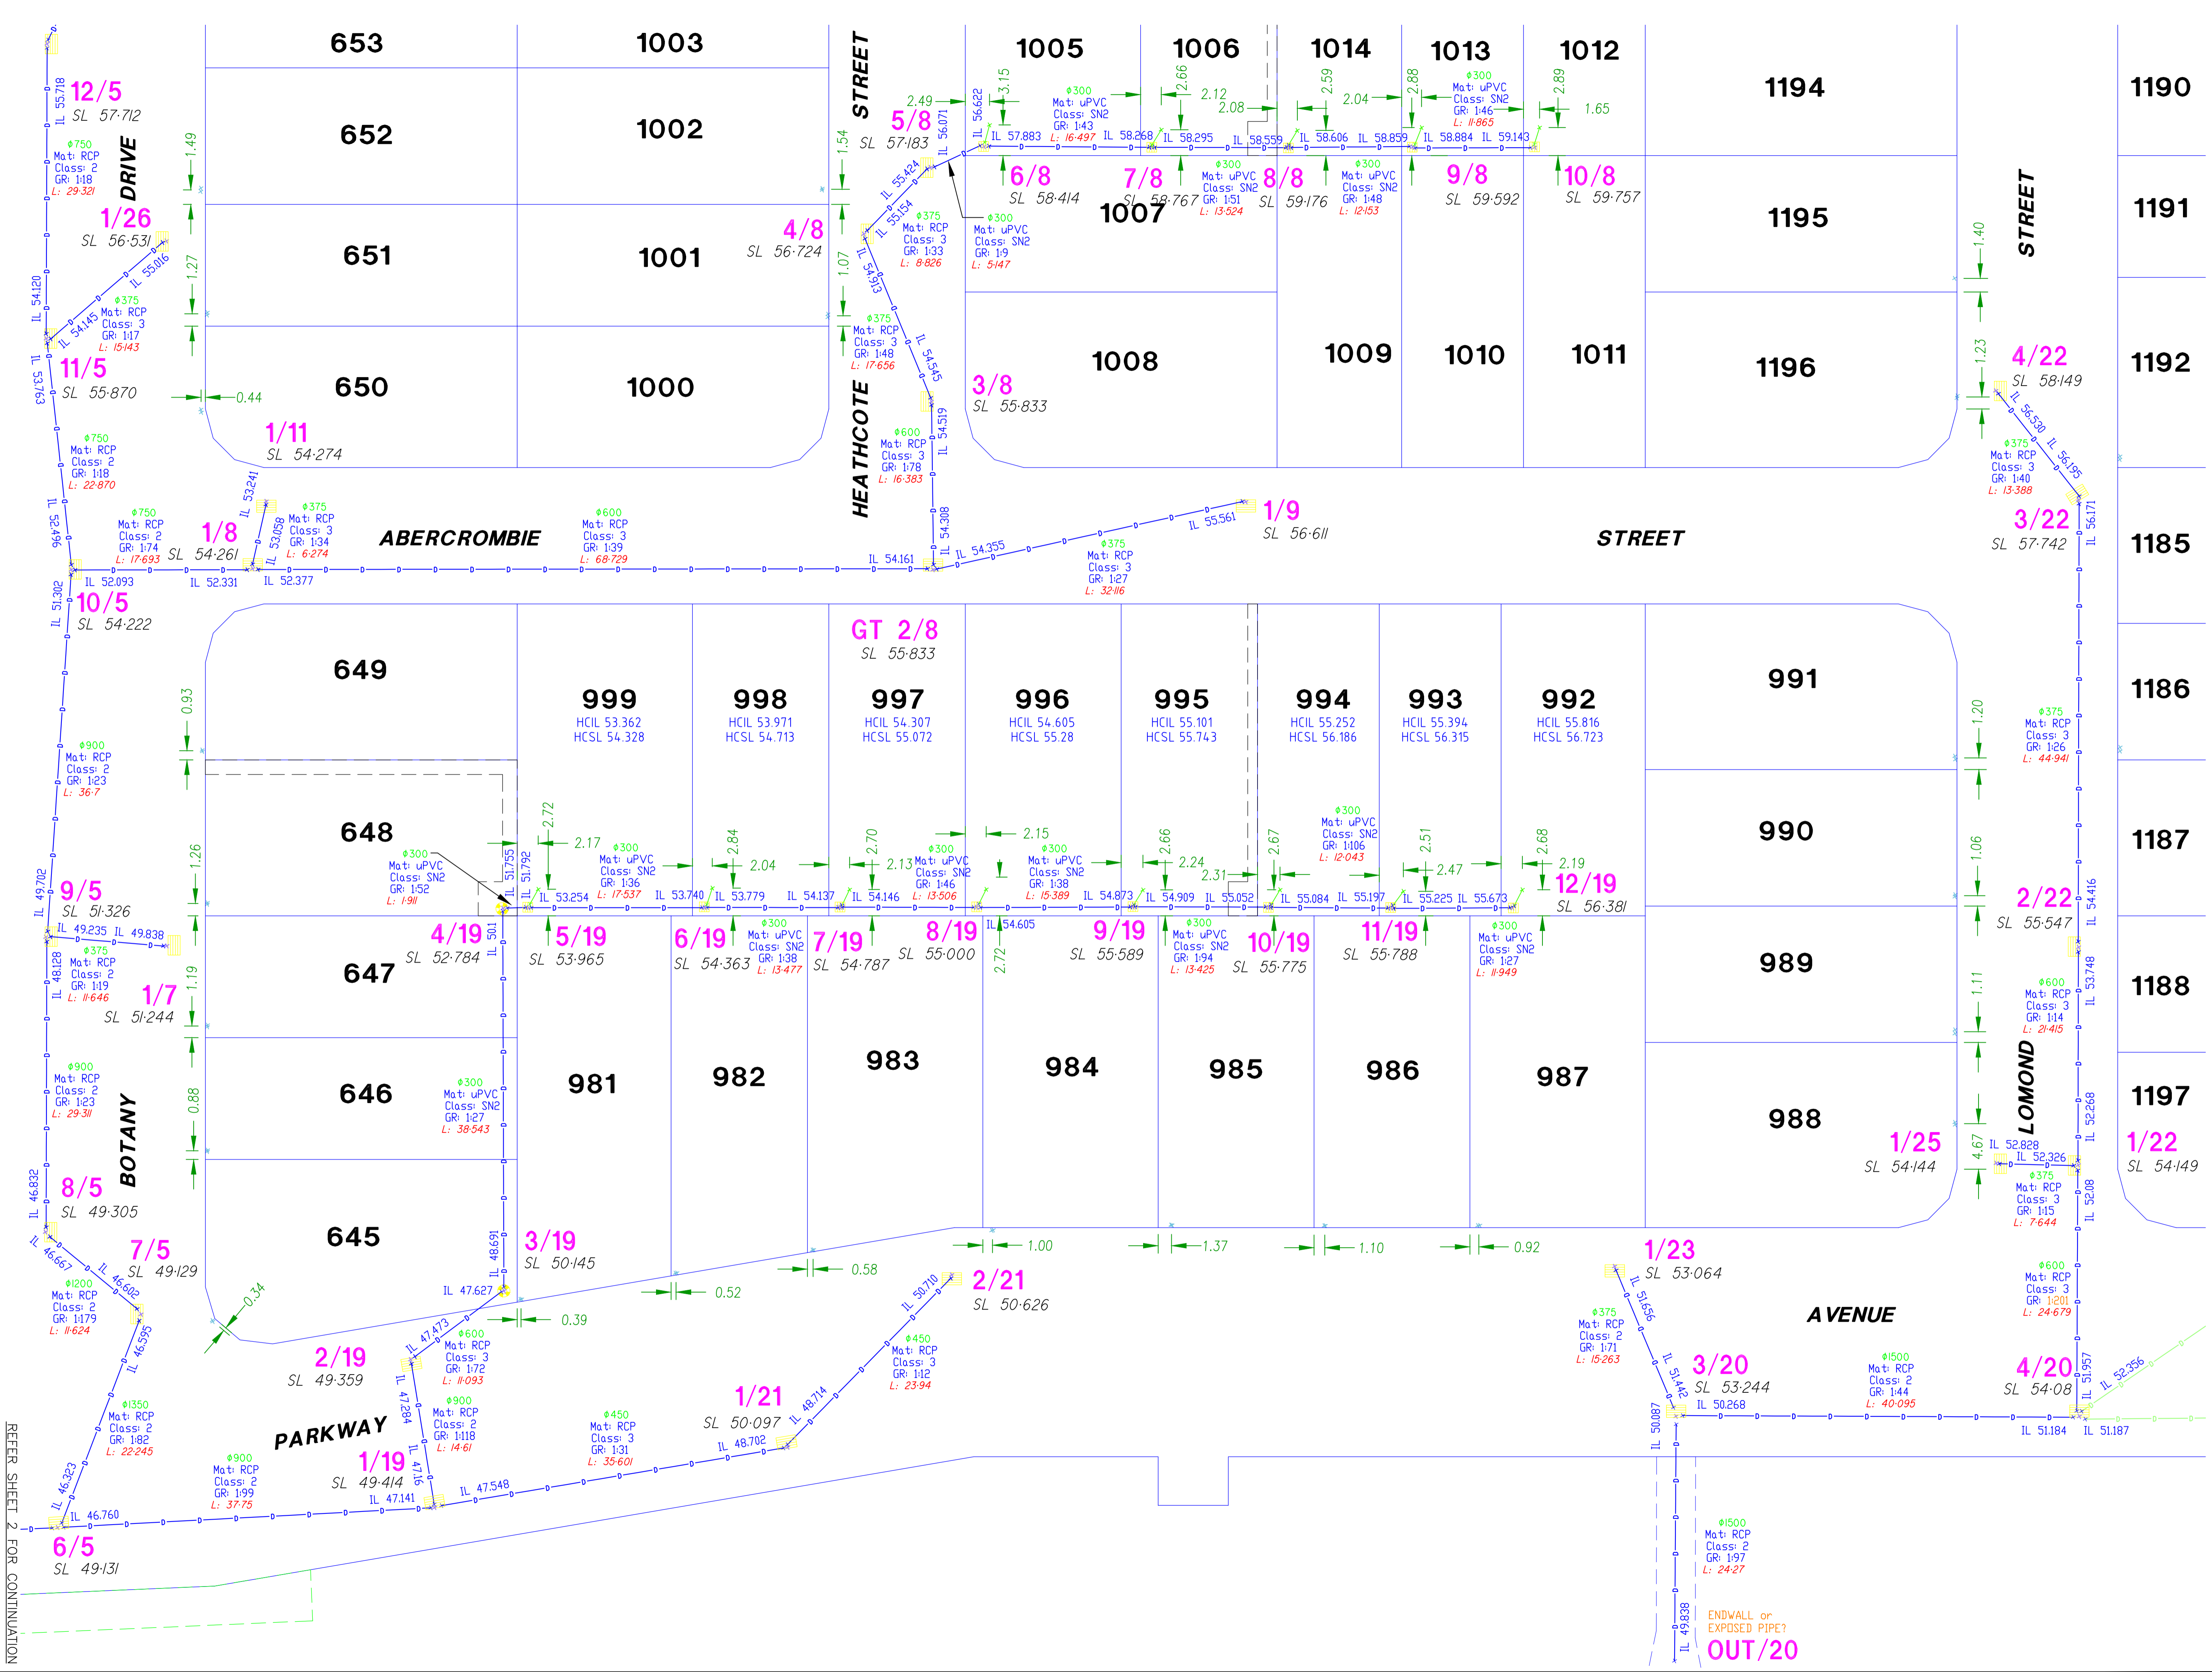

ENDWALL or EXPOSED PIPE? OUT/20

REFER SHEET 2 FOR CONTINUATION