
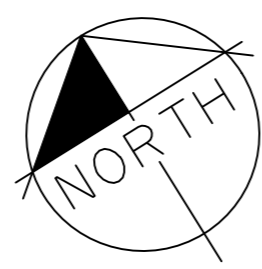


SURVEY DATUM

Coordinate System: Local Site.
Horizontal Azimuth: GDA94
Vertical Datum: AHD71

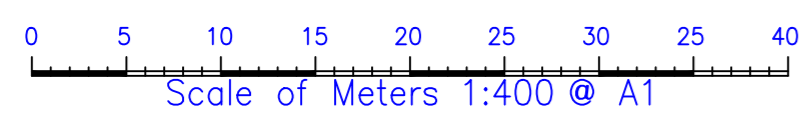

PROJECT

Providence, Ripley

LEVEL DATUM

AHD

ORIGIN

OPM60301
RL 44.315
Barrams Rd Sth Ripley

FB: TSC3 LB: DWG: 116052 S7 Post Fill (MGA)

SCALE

1:400 @ A1

Date: JUNE 2016

Surveyed: RPS

Comp by: DJL

CLIENT

AMEX CORP. PTY LTD

**AS CONSTRUCTED
WATER RETICULATION MAIN
STAGE 7**

Parish:

Local Authority: IPSWICH CITY COUNCIL

Job Ref:

116052



©COPYRIGHT PROTECTS THIS PLAN
Unauthorized reproduction or amendment
not permitted. Please contact the author.

RPS Australia East Pty Ltd
ACN 140 292 762
ABN 44 140 292 762
180 Brisbane Street
PO Box 341
Ipswich QLD 4305
T +61 7 3437 2000
F +61 7 3434 2099
W rpsgroup.com.au

Reference: **116052-118**

Rev