


# BUILDERS ISSUE

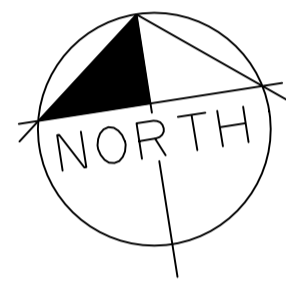

PROJECT	Providence, Ripley
LEVEL DATUM	AHD
SCALE	1:400 @ A1
ORIGIN	OPM60301
RI	44.315
FR :	TSC3
LR :	
DATE	16/05/22
BY	SEWER MAINS
CHKD	16/05/22
APPD	16/05/22

CLIENT	AMEX CORP. PTY LTD
AS CONSTRUCTED	SEWER HOUSE CONNECTIONS
STAGE 8B - SHEET 1	
JOB REF	16052104

**RPS**

PROVIDENCE RIPLEY


16052104

Reference 16052-104

Rev

### ADDITIONAL HCB INFORMATION

OB 15.799	DIA DN110φ	<b>431</b>
HCSL 52.475	MAT PE100	
HCIL 50.615	CL PN8	
HCL 2.973	TYPE C2	
OB 7.311	DIA DN110φ	<b>432</b>
HCSL 51.618	MAT PE100	
HCIL 50.676	CL PN8	
HCL 3.794	TYPE C2	
OB 0.424	DIA DN110φ	<b>433</b>
HCSL 52.563	MAT PE100	
HCIL 50.676	CL PN8	
HCL 3.627	TYPE C2	
OB 6.787	DIA DN110φ	<b>434</b>
HCSL 52.840	MAT PE100	
HCIL 50.676	CL PN8	
HCL 3.808	TYPE C2	
OB 13.810	DIA DN110φ	<b>435</b>
HCSL 52.023	MAT PE100	
HCIL 50.676	CL PN8	
HCL 4.018	TYPE C2	
OB 21.533	DIA DN110φ	<b>436</b>
HCSL 52.902	MAT PE100	
HCIL 51.195	CL PN8	
HCL 2.953	TYPE C2	

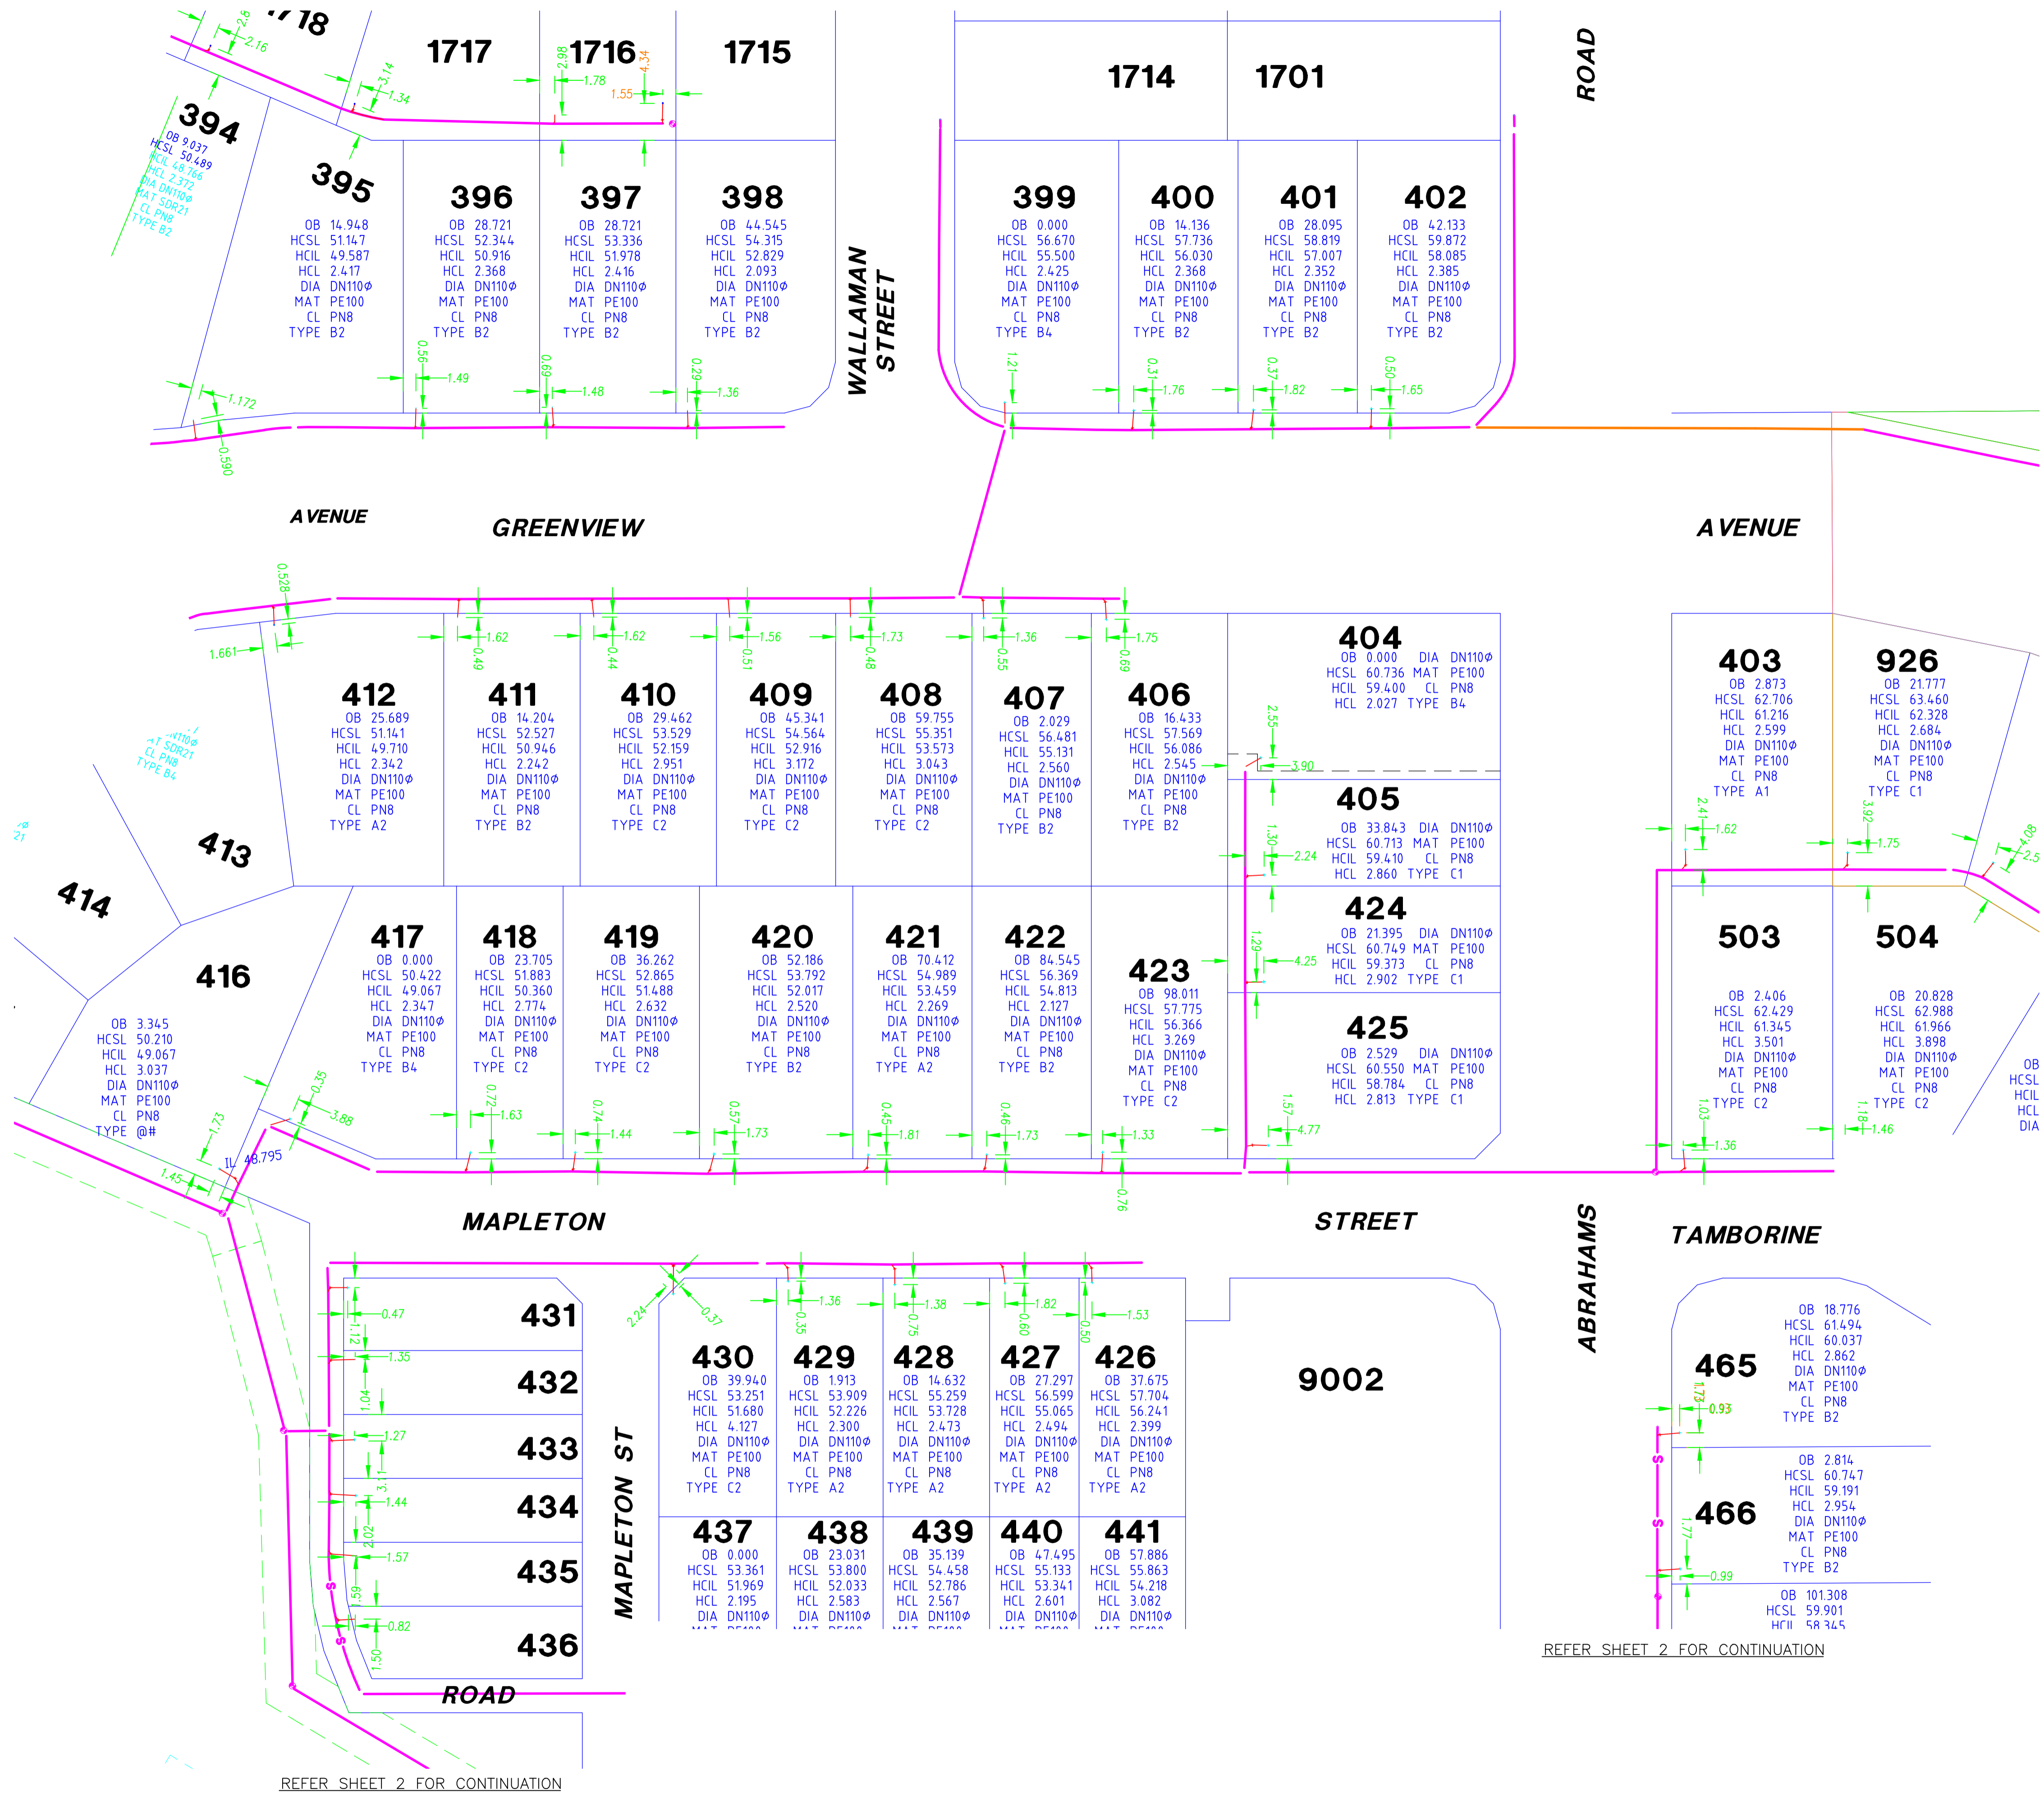

REFER SHEET 2 FOR CONTINUATION

REFER SHEET 2 FOR CONTINUATION