

STAGE 30

STAGE 8b


REFER SHEET 1 FOR CONTINUATION

SURVEY DATUM

Coordinate System: Local Site.
 Horizontal Azimuth: GDA94
 Vertical Datum: AHD71

BUILDERS ISSUE

0 5 10 15 20 25 30 35 40
 Scale of Meters 1:400 @ A1

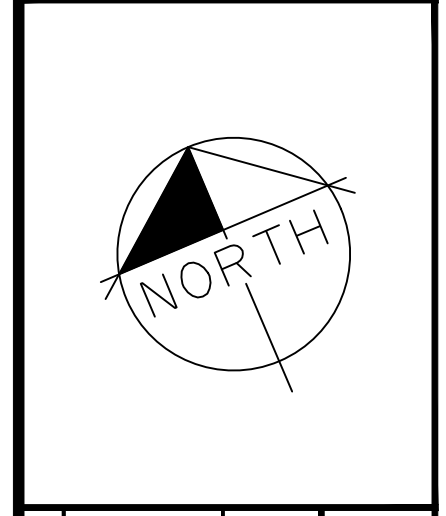

PROJECT

Providence, Ripley

LEVEL DATUM

AHD

SCALE

1:400 @ A1

ORIGIN

OPM60301
 RL 44.316
 Barrons Rd Sth Ripley

DATE

JUNE 2016

DRW

16052 Stormwater

FR

TSC3

LR

CLIENT

AMEX CORP. PTY LTD

AS CONSTRUCTED

STORMWATER MAINS - STAGE 8B

SHEET 1

Job Ref

16052

RPS

© COPYRIGHT ENGINEERS THIS PLAN
 INFORMATION IS VALID AS AT DATE OF
 PUBLICATION. REVISED INFORMATION
 WILL BE INDICATED BY A REVISION
 NUMBER.

RPS Australia East Pty Ltd
 ACN 140 282 782
 ABN 44 140 282 782
 100 Brisbane Street
 Ipswich QLD 4305
 T +61 7 3437 2000
 F +61 7 3434 2099
 W rpsgroup.com.au

Reference

16052-??

Rev