
 


 



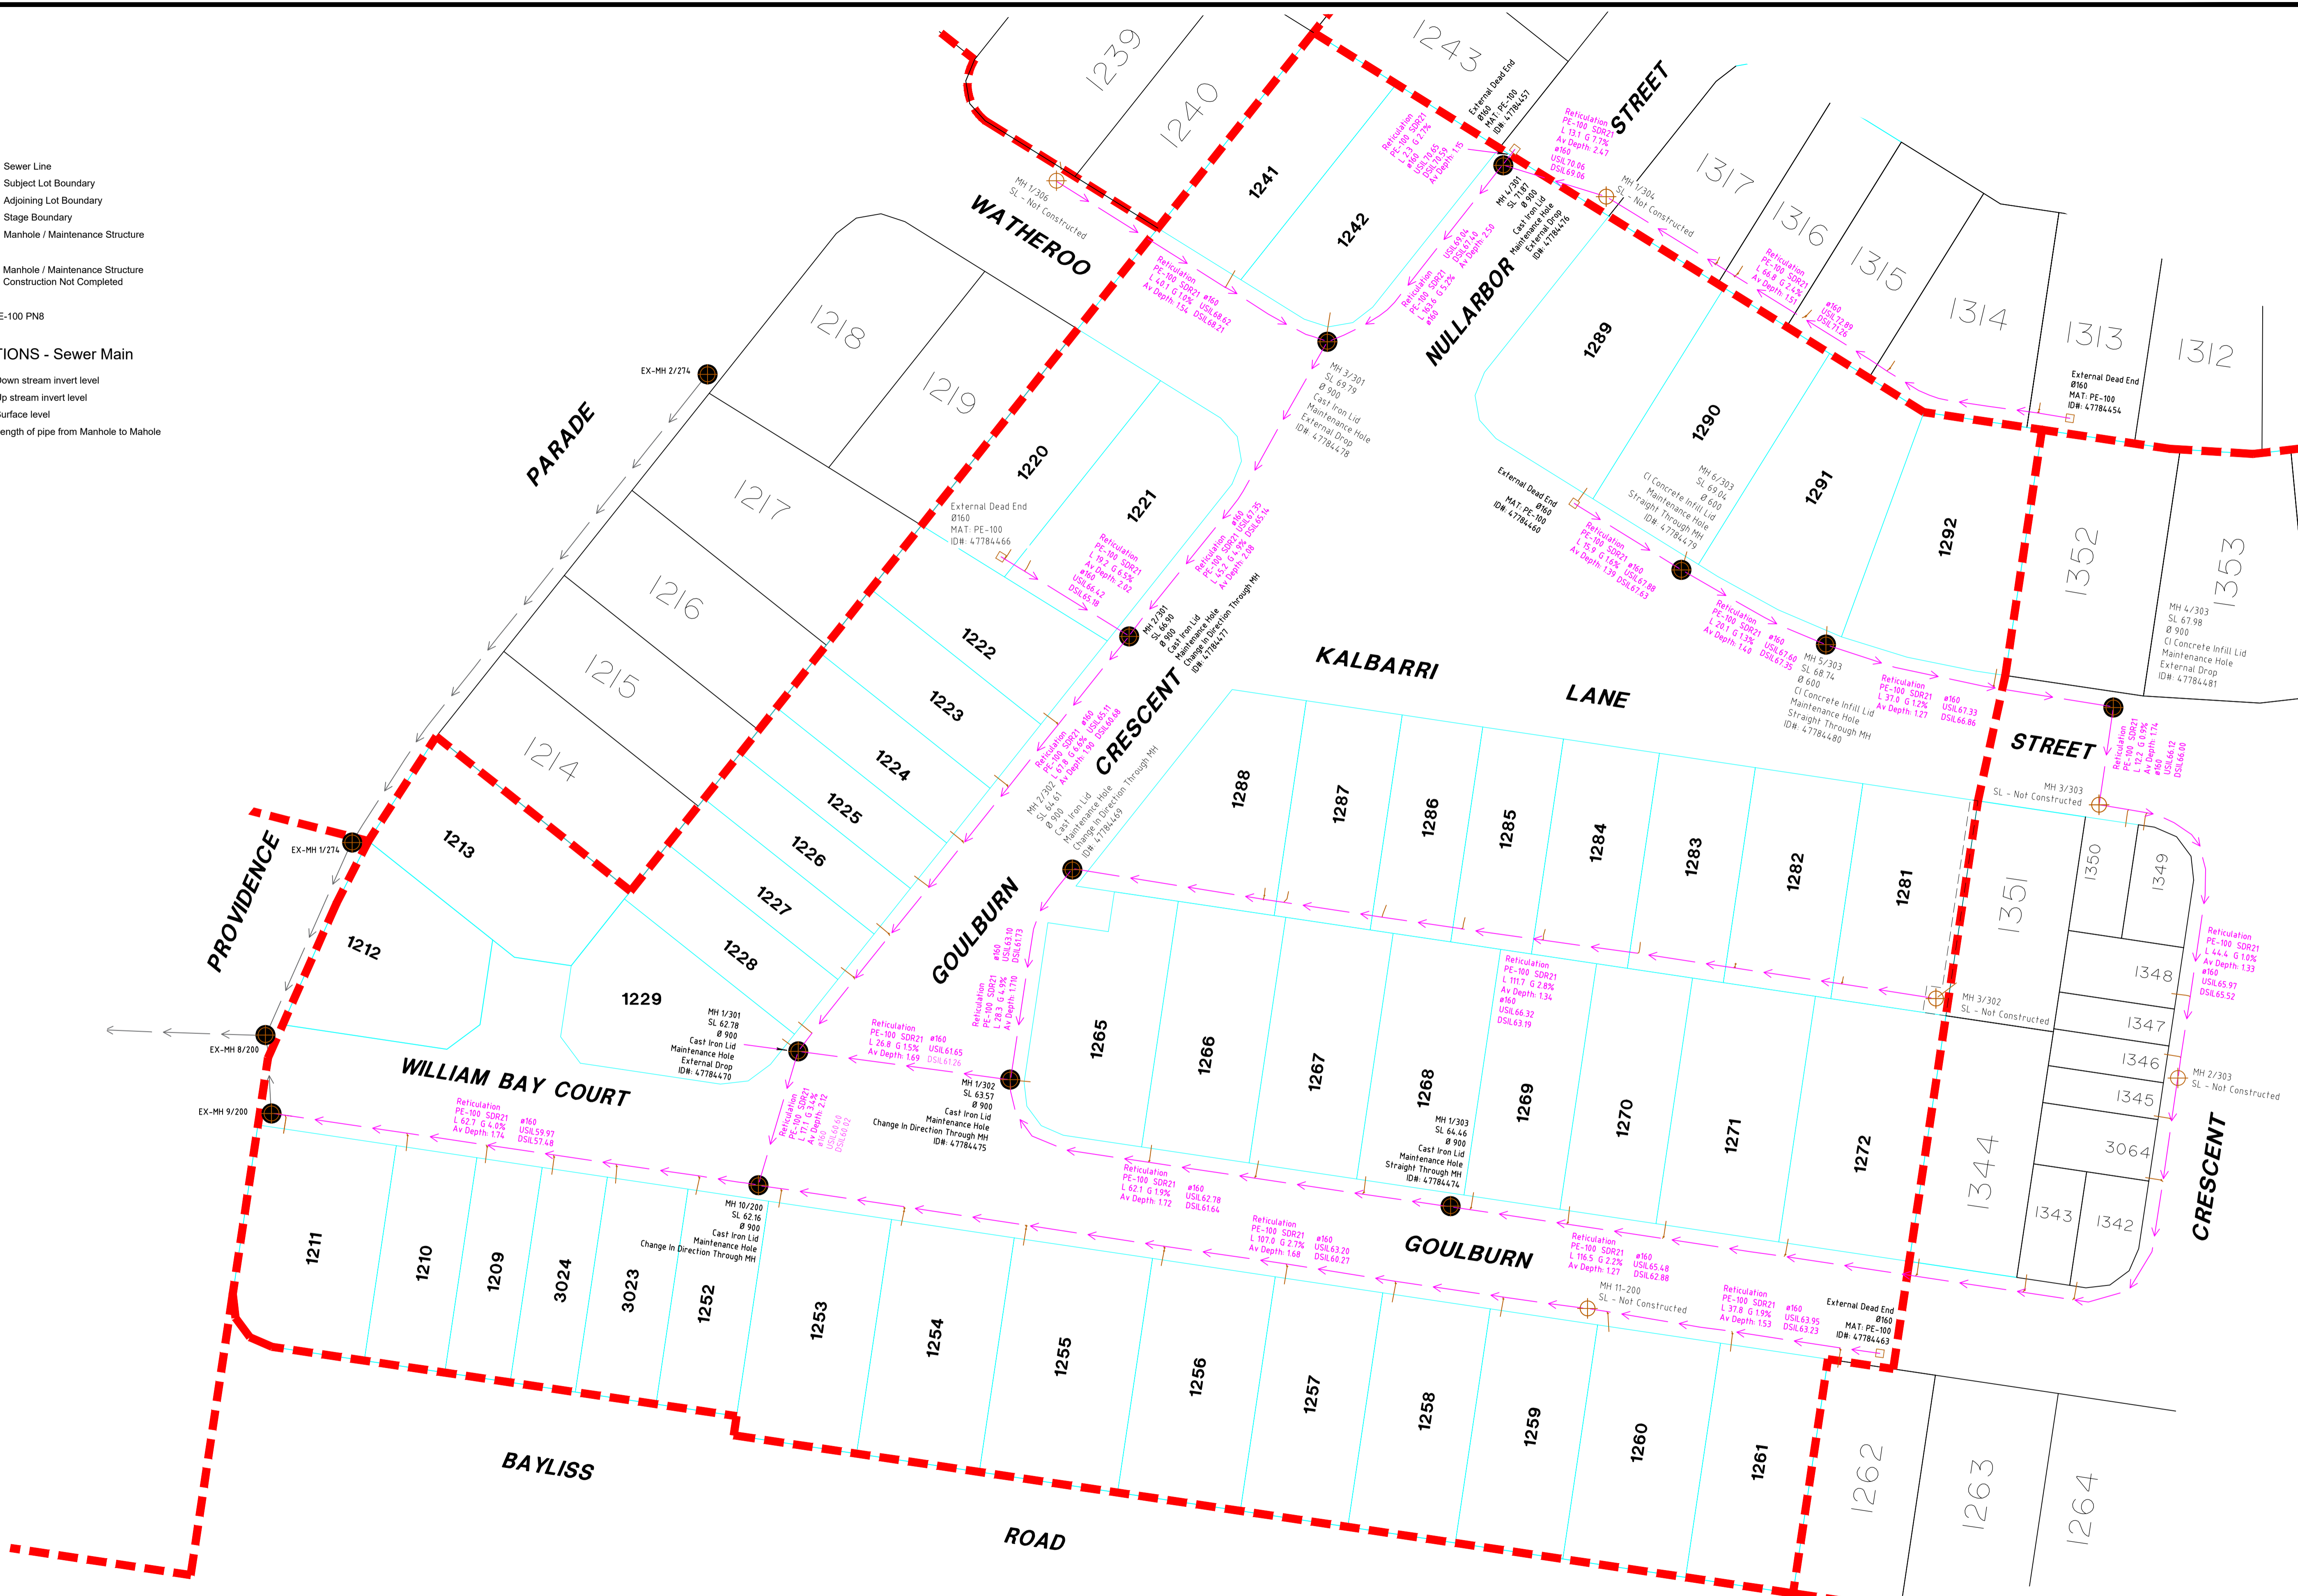
**LEGEND**

-  Sewer Line
-  Subject Lot Boundary
-  Adjoining Lot Boundary
-  Stage Boundary
-  Manhole / Maintenance Structure
-  Manhole / Maintenance Structure Construction Not Completed

Material PE-100 PN8

**ABBREVIATIONS - Sewer Main**

- DSIL Down stream invert level
- USIL Up stream invert level
- SL Surface level
- LGTH / L Length of pipe from Manhole to Mahole



Issue	Description	Date
Original	Original Builders issue	15/05/2017
A	General Revisions	30/05/2017

0 5 10 15 20 25 30 35 40  
Scale of Meters 1:400 @ A1

**BUILDERS ISSUE**

PROJECT <b>Providence South, Ripley</b>		CLIENT <b>AMEX CORPORATION PTY. LTD.</b>
LEVEL DATUM AHD	SCALE <b>1:400 @ A1</b>	<b>AS CONSTRUCTED SEWER RETICULATION MAIN STAGE 30</b>
ORIGIN OPM60301 RL 44-315 Barrams Rd Sth Ripley	Date MAY 2017	
Comp by BR	Surveyed RPS	Job Ref I16052-29
FB : TSC3	LB :	DWG I16052 Sewer Mains

Local Authority IPSWICH CITY COUNCIL	Reference <b>116052-169</b>	Rev <b>A</b>
---	--------------------------------	-----------------



©COPYRIGHT PROTECTS THIS PLAN  
Unauthorized reproduction or amendment  
not permitted. Please contact the author.

RPS Australia East Pty Ltd  
ACN 140 292 762  
ABN 44 140 292 762  
180 Brisbane Street  
PO Box 541  
Ipswich QLD 4305  
T +61 7 3437 2000  
F +61 7 3434 2099  
W rpsgroup.com.au