


Issue	Description	Date
	Original Builders issue	17/07/2017

Scale of Meters 1:400 @ A1

BUILDERS ISSUE

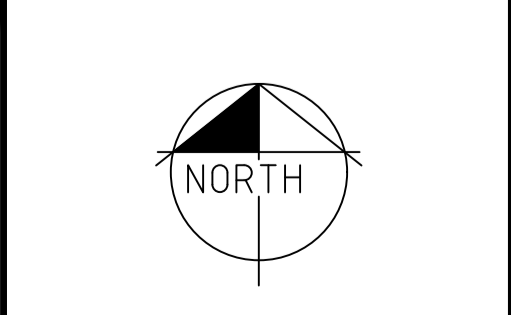

PROJECT <b>Providence, Ripley</b>	
LEVEL DATUM AHD	SCALE <b>1:400 @ A1</b>
ORIGIN OPM60301 RL 44.315 Barrams Rd Sth Ripley	Date: MAY 2017 Surveyed: RPS Comp by: BR
FB : TSC3    LB :	DWG: 116052

CLIENT <b>AMEX CORP. PTY LTD</b>	
<b>AS CONSTRUCTED STORMWATER MAINS STAGE 30</b>	
Parish	Job Ref
Local Authority IPSWICH CITY COUNCIL	116052-29

RPS Australia East Pty Ltd  
ACN 140 292 762  
ABN 44 140 292 762  
743 Ann Street  
PO Box 1559  
Fortitude Valley QLD 4006  
T +61 7 3237 8899  
F +61 7 3237 8833  
W rpsgroup.com.au

Reference <b>116052-170</b>	Rev
--------------------------------	-----