



LEGEND
 Stormwater Line
 Lot Boundary
 Stage Boundary
 Manhole

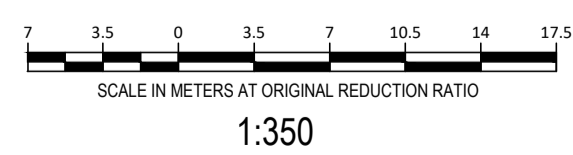

BUILDERS ISSUE

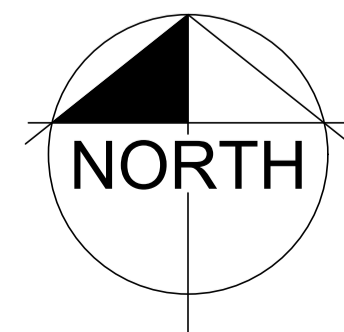

| | |
|--|---|
| PROJECT <i>Providence, Ripley</i> | |
| LEVEL DATUM AHD | SCALE 1:350 @ A1 |
| ORIGIN OPM60301 RL 44.315 Barrams Rd Sth Ripley | Date: OCTOBER 2017 Surveyed: RPS Comp by: RPS |
| FB : FLD | LB : DWG. 116052 s32 Stormwater |

| | |
|--|----------------------|
| CLIENT AMEX CORP. PTY LTD | |
| AS CONSTRUCTED STORMWATER RETICULATION STAGE 32 | |
| Parish | Job Ref 116052-34 |
| Local Authority IPSWICH CITY COUNCIL | |

RPS
 RPS Australia East Pty Ltd
 ACN 140 292 762
 ABN 44 140 292 762
 180 Brisbane Street
 PO Box 341
 Ipswich QLD 4305
 T +61 7 3437 2000
 F +61 7 3434 2099
 W rpsgroup.com.au

| | |
|--------------------------------|-----|
| Reference 116052-219 | Rev |
|--------------------------------|-----|